
KOLB LAND CONSULTING, INC.

LAND SURVEYING · SUBDIVIDING · LAND PLANNING

LAKE GENEVA, WISCONSIN 53147

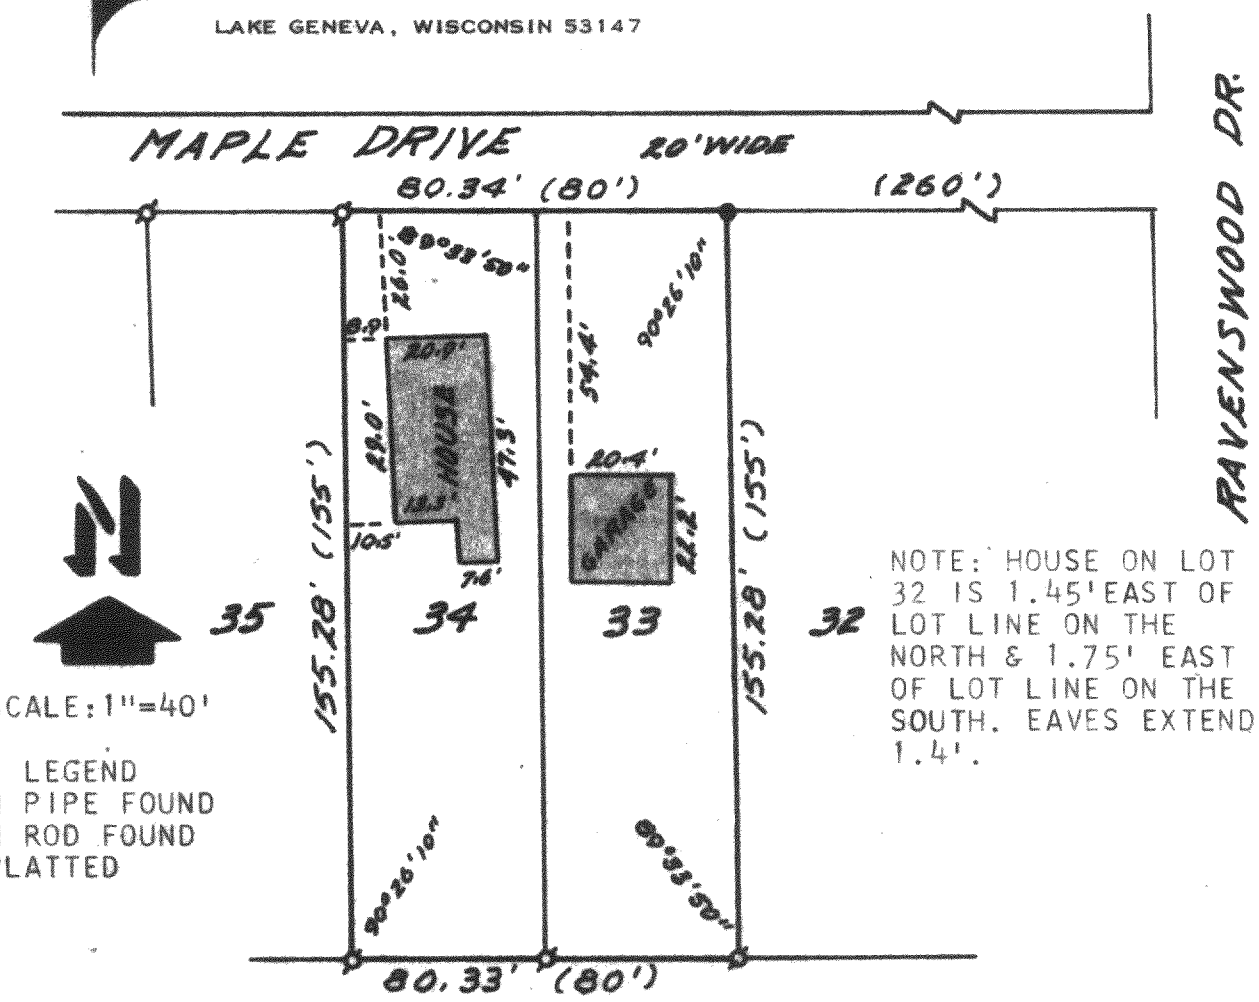

SCALE: 1"=40'

LEGEND
- ⌀ IRON PIPE FOUND
- ● IRON ROD FOUND
- ( ) AS PLATTED

NOTE: HOUSE ON LOT 32 IS 1.45' EAST OF LOT LINE ON THE NORTH & 1.75' EAST OF LOT LINE ON THE SOUTH. EAVES EXTEND 1.4'.

PLAT OF SURVEY OF

LOTS 33 AND 34, KRUMHAAR'S ADDITION TO RAVENSWOOD SUBDIVISION, LOCATED IN SECTION 31, T 2 N, R 16 E, TOWN OF DELAVAN, WALWORTH COUNTY, WISCONSIN,

ORDERED BY: KARLA ROEKER
4021 MAPLE DRIVE
DELAVAN, WI. 53115

WISCONSIN
HAROLD H. KOLB
S-187
LAKE GENEVA, WIS.
LAND SURVEYOR

I, HAROLD H. KOLB, DO HEREBY CERTIFY THAT I HAVE SURVEYED THE PROPERTY HEREON DESCRIBED ACCORDING TO THE OFFICIAL RECORDS, AND THAT THE PLAT HEREON IS A CORRECT REPRESENTATION OF THE LOT LINES AND THE PRINCIPAL LINES OF THE BUILDINGS THEREON TO THE BEST OF MY KNOWLEDGE AND BELIEF.

Harold H. Kolb

WISCONSIN REGISTERED LAND SURVEYOR, S- 187

DATE AUGUST 4, 1983

FRA 00030

216-779-K