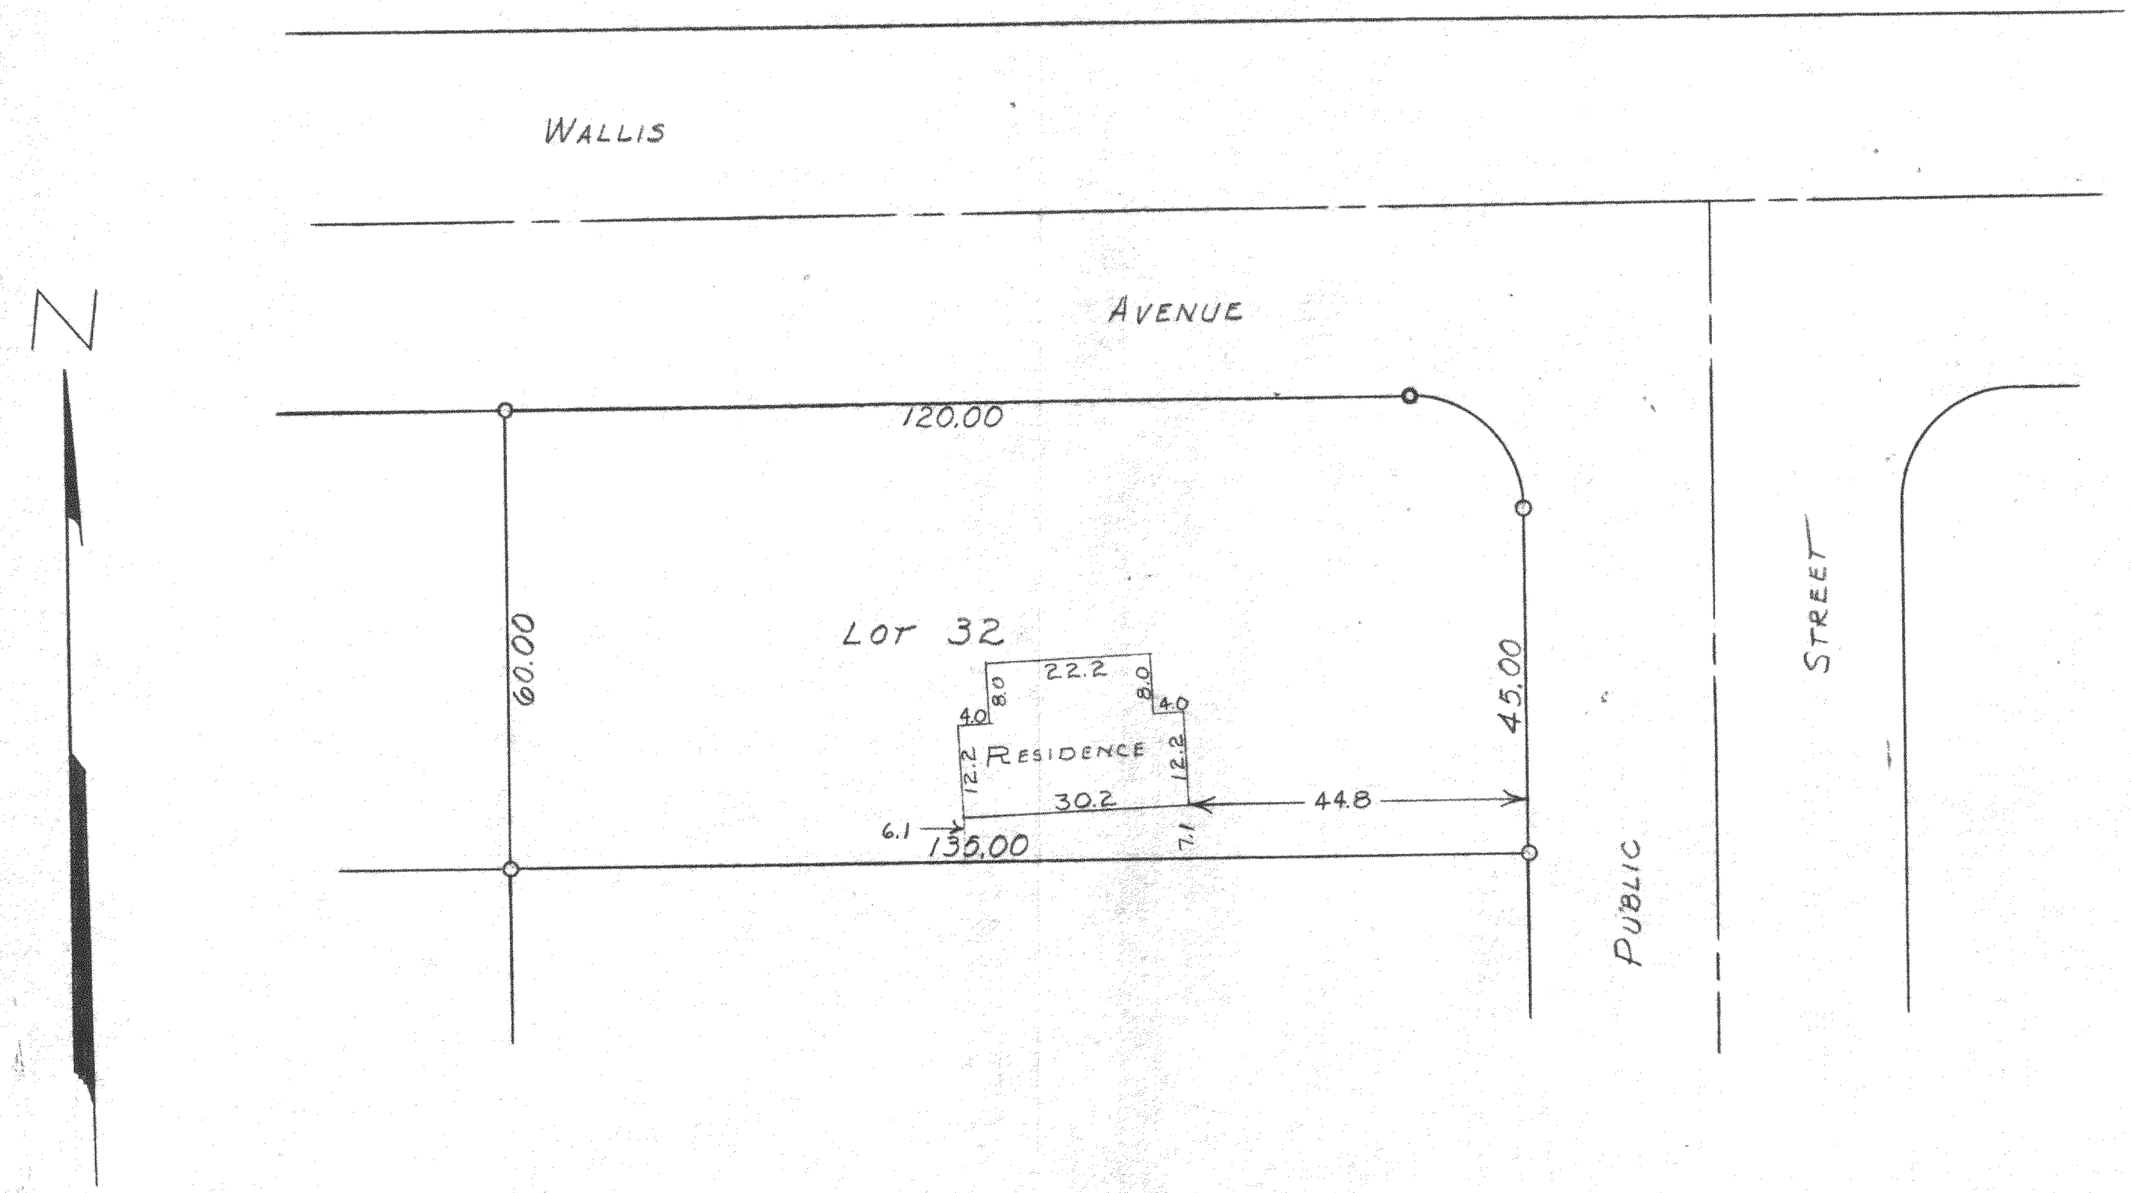

PLAT OF SURVEY OF LOT 32, BLOCK 15, DELMAR SUBDIVISION LOCATED IN THE TOWN OF DELAVAN, WALWORTH COUNTY, WISCONSIN.
AUGUST 30, 1958

GEORGE T. DUNHAM, SURVEYOR
DELAVAN, WISCONSIN

216-78