
DUNHAM SURVEYING, S. C.

SURVEYING & SUBDIVIDING

DELAVAN, WISCONSIN 53115

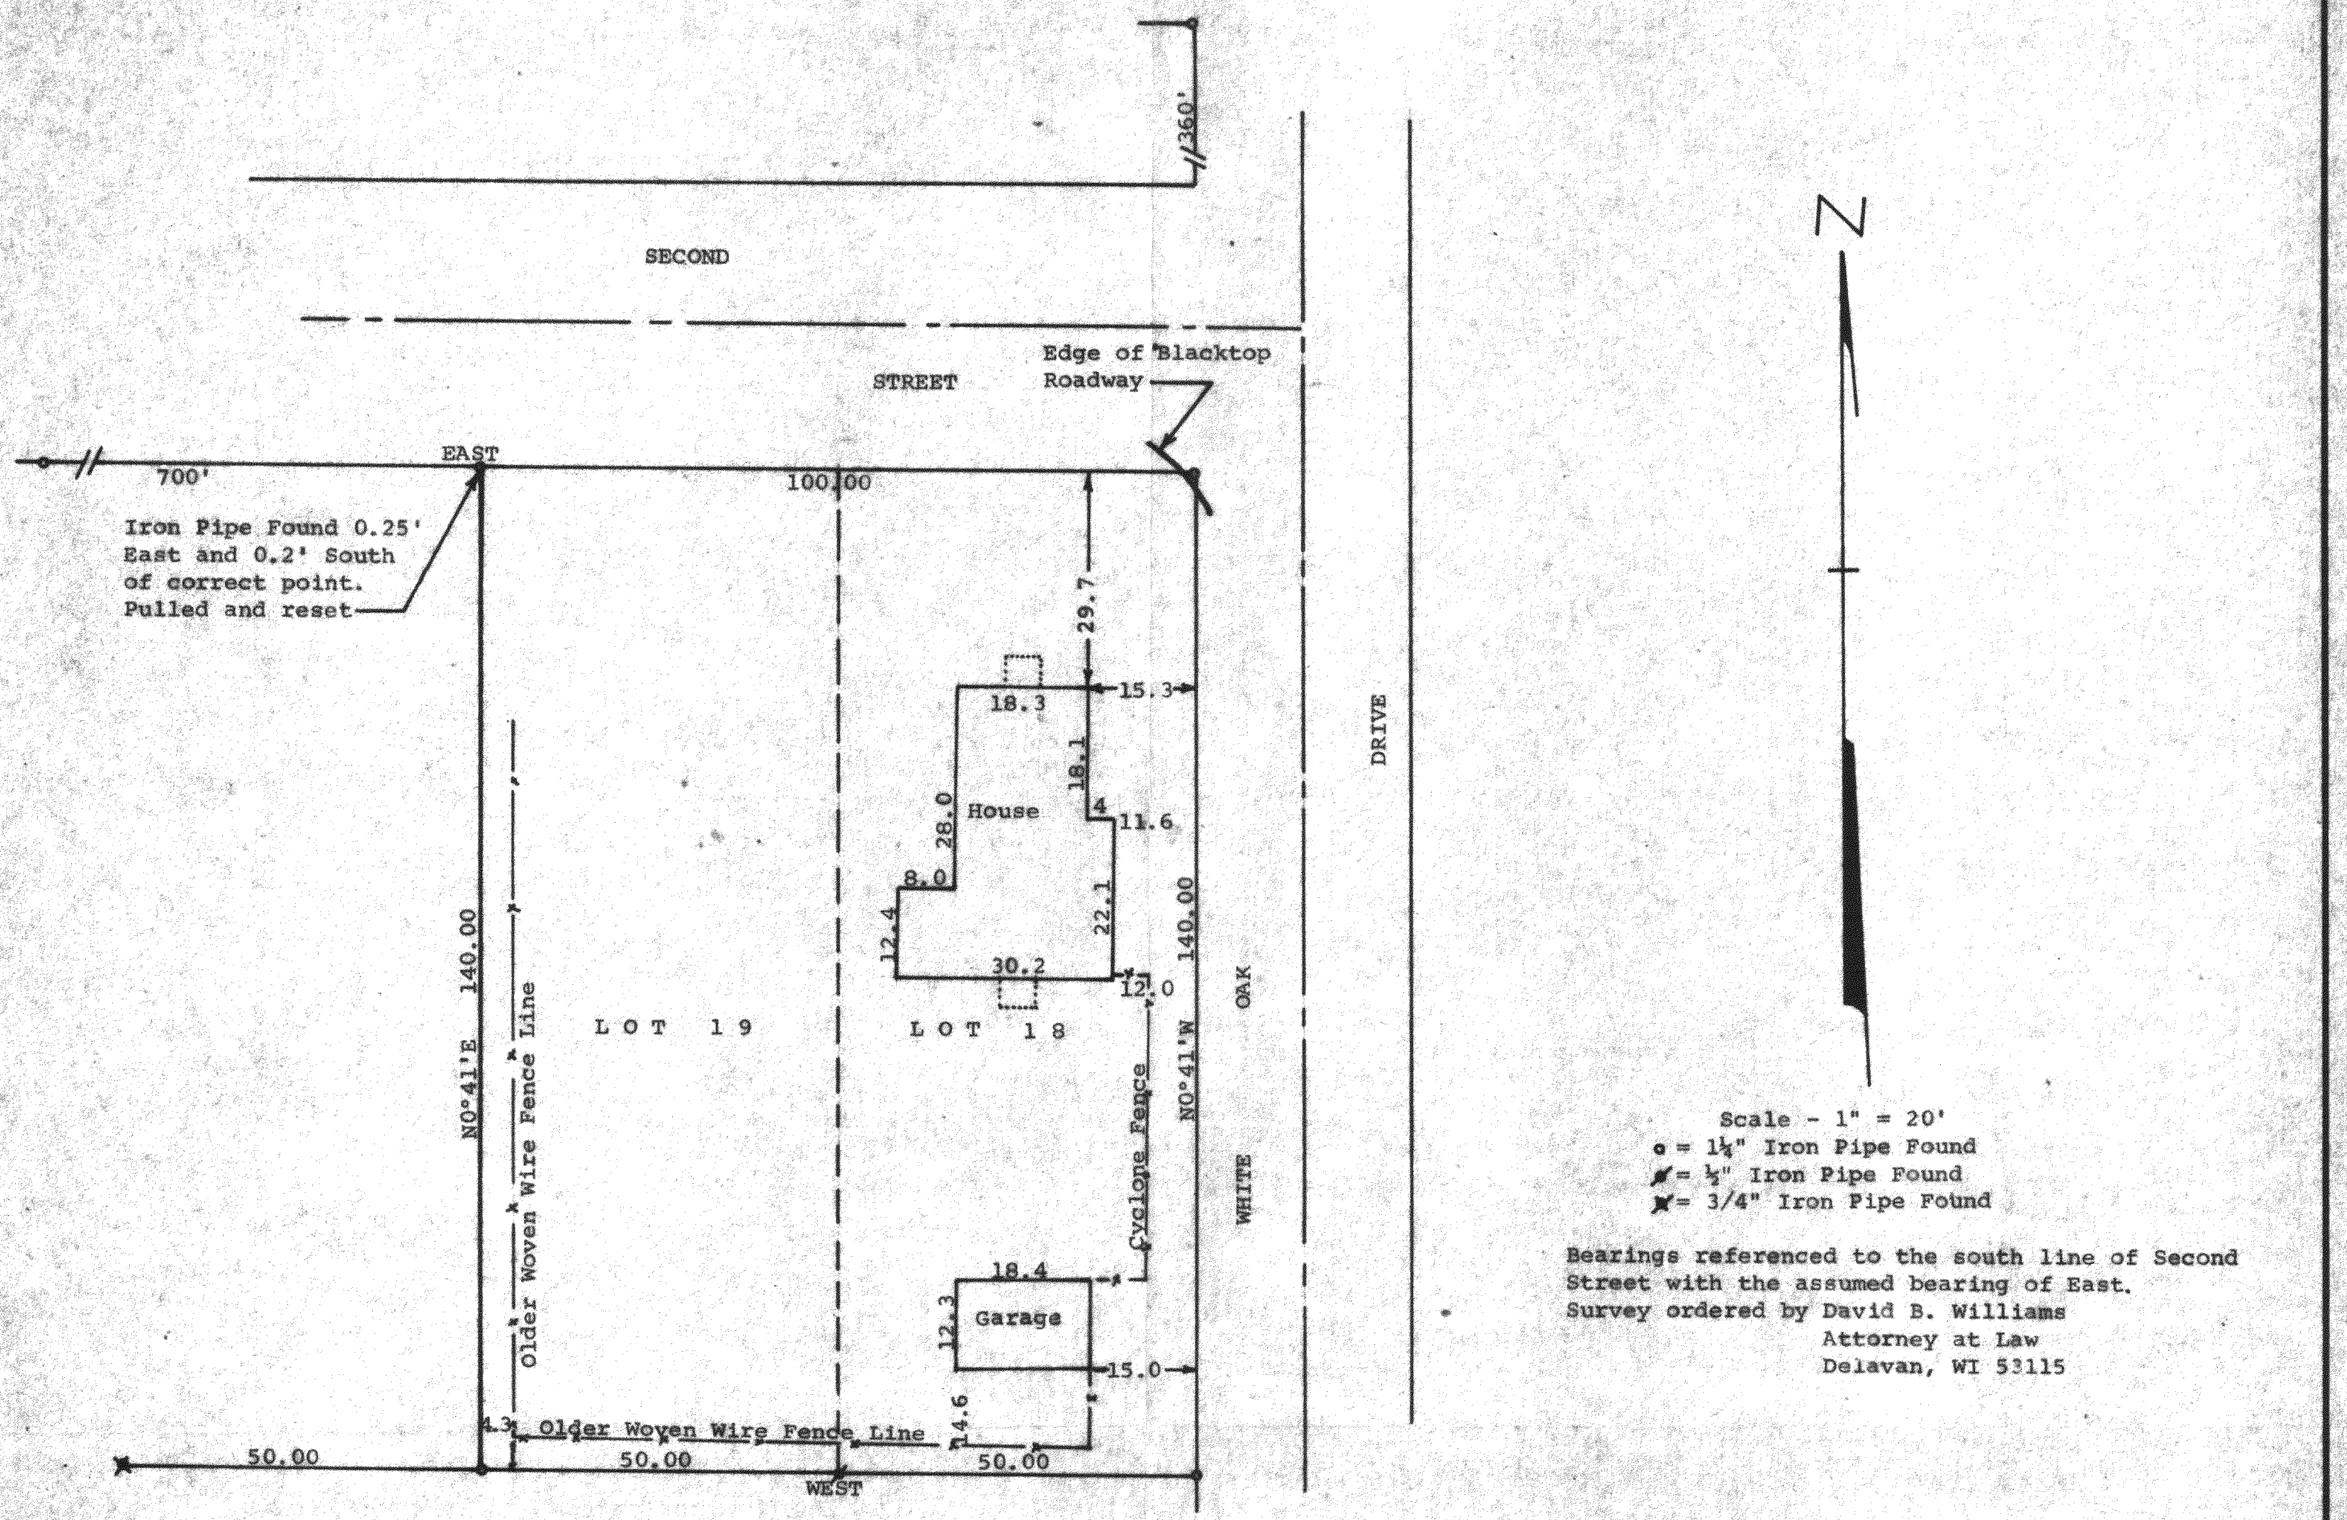

Bearings referenced to the south line of Second Street with the assumed bearing of East.
Survey ordered by David B. Williams
Attorney at Law
Delavan, WI 53115

STATE OF WISCONSIN)
COUNTY OF WALWORTH) SS

I, George T. Dunham, Surveyor, certify that I have surveyed the property described as follows:

Lots 18 and 19, Block 2, of the recorded plat of Inlet Oaks Subdivision No. 3 located in Fractional Sections 15 and 22, T 2 N, R 16 E, Walworth County, Wisconsin.

and that the above map is a true representation thereof and shows the size and location of the property, its exterior boundaries, the location of all visible structures and dimensions of all principal buildings thereon, boundary fences, apparent easements, roadways and visible encroachments, if any, and that I have surveyed the property hereon described according to the official records, to the best of my knowledge and belief.

May 10, 1983

George T. Dunham

George T. Dunham, Surveyor

WISCONSIN
GEORGE T. DUNHAM
DELAVAN, WIS.
S-306
LAND SURVEYOR

FIN3-39

216-782D

K & E 10-9155