
DUNHAM SURVEYING, S. C.

SURVEYING & SUBDIVIDING
DELAVAN, WISCONSIN 53115



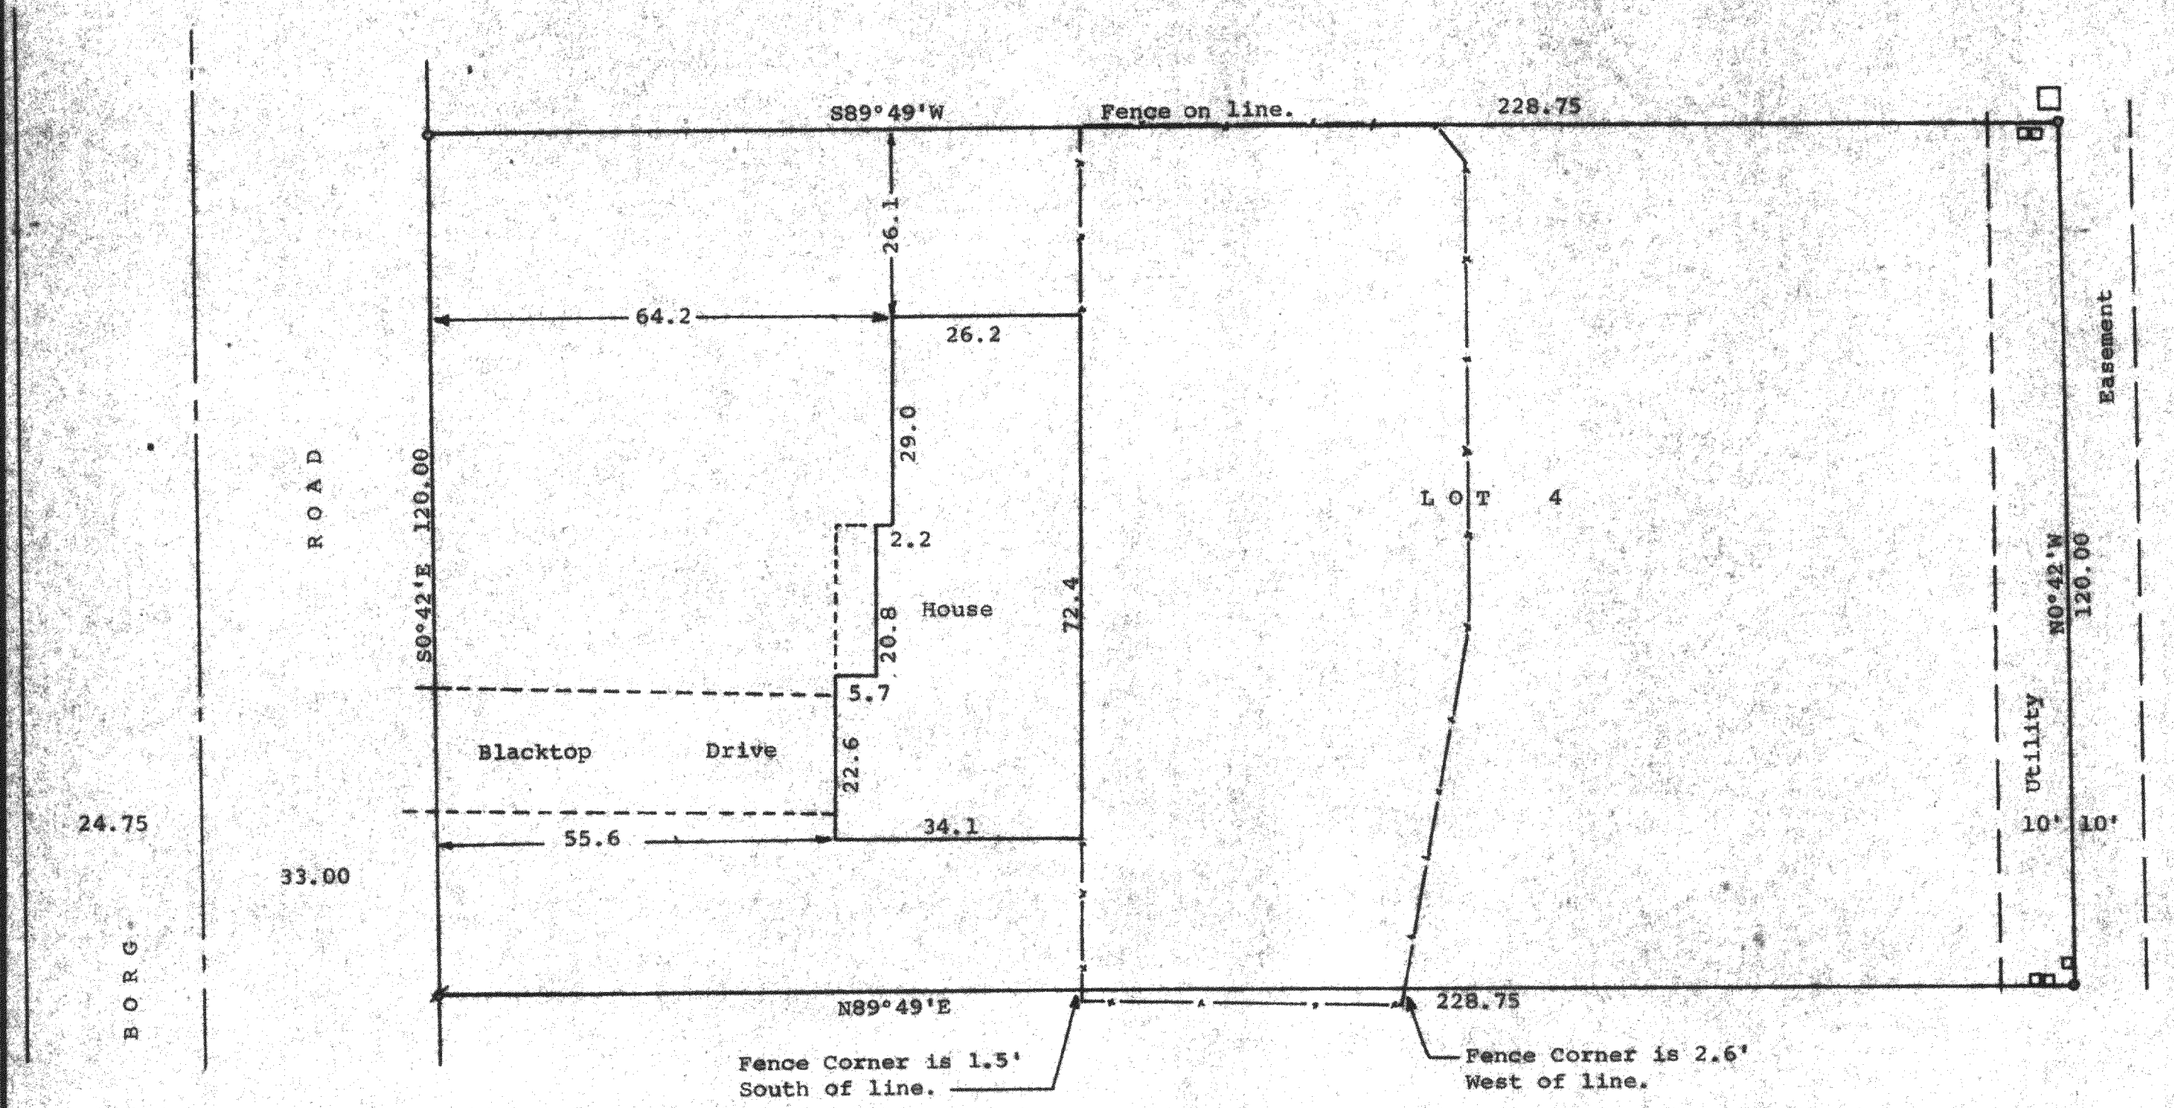

Scale - 1" = 20'
o = ½" Iron Rod Found
ø = ½" Iron Rod Found Bent and reset.
—x—x— = Fence
□ = Telephone or Electric Pedestal
▣ = Electrical Transformer

Bearings are those of record.
Survey Ordered By: The Rauland Agency
607 E. Walworth Ave.
Delavan, Wisconsin 53115

STATE OF WISCONSIN)
COUNTY OF WALWORTH) SS

I, Richard C. Schulz, Surveyor, certify that I have surveyed the property described as follows,

Lot 4, Oak Meadow Subdivision, located in the Northeast ¼ of Section 29, T2N, R16E, Town of Delavan, Walworth County, Wisconsin,

and that the above map is a true representation thereof and shows the size and location of the property, its exterior boundaries, the location of all visible structures and dimensions of all principal buildings thereon, boundary fences, apparent easements, roadways and visible encroachments, if any, and that I have surveyed the property hereon described according to the official records, to the best of my knowledge and belief.

July 27, 1983

Richard C. Schulz
Richard C. Schulz, Surveyor

WISCONSIN
RICHARD C. SCHULZ
S-1671
DELAVAN
WI
LAND SURVEYOR

FOMS-4

216-783-D