
DUNHAM SURVEYING, S. C.
SURVEYING & SUBDIVIDING
DELAVAN, WISCONSIN 53115



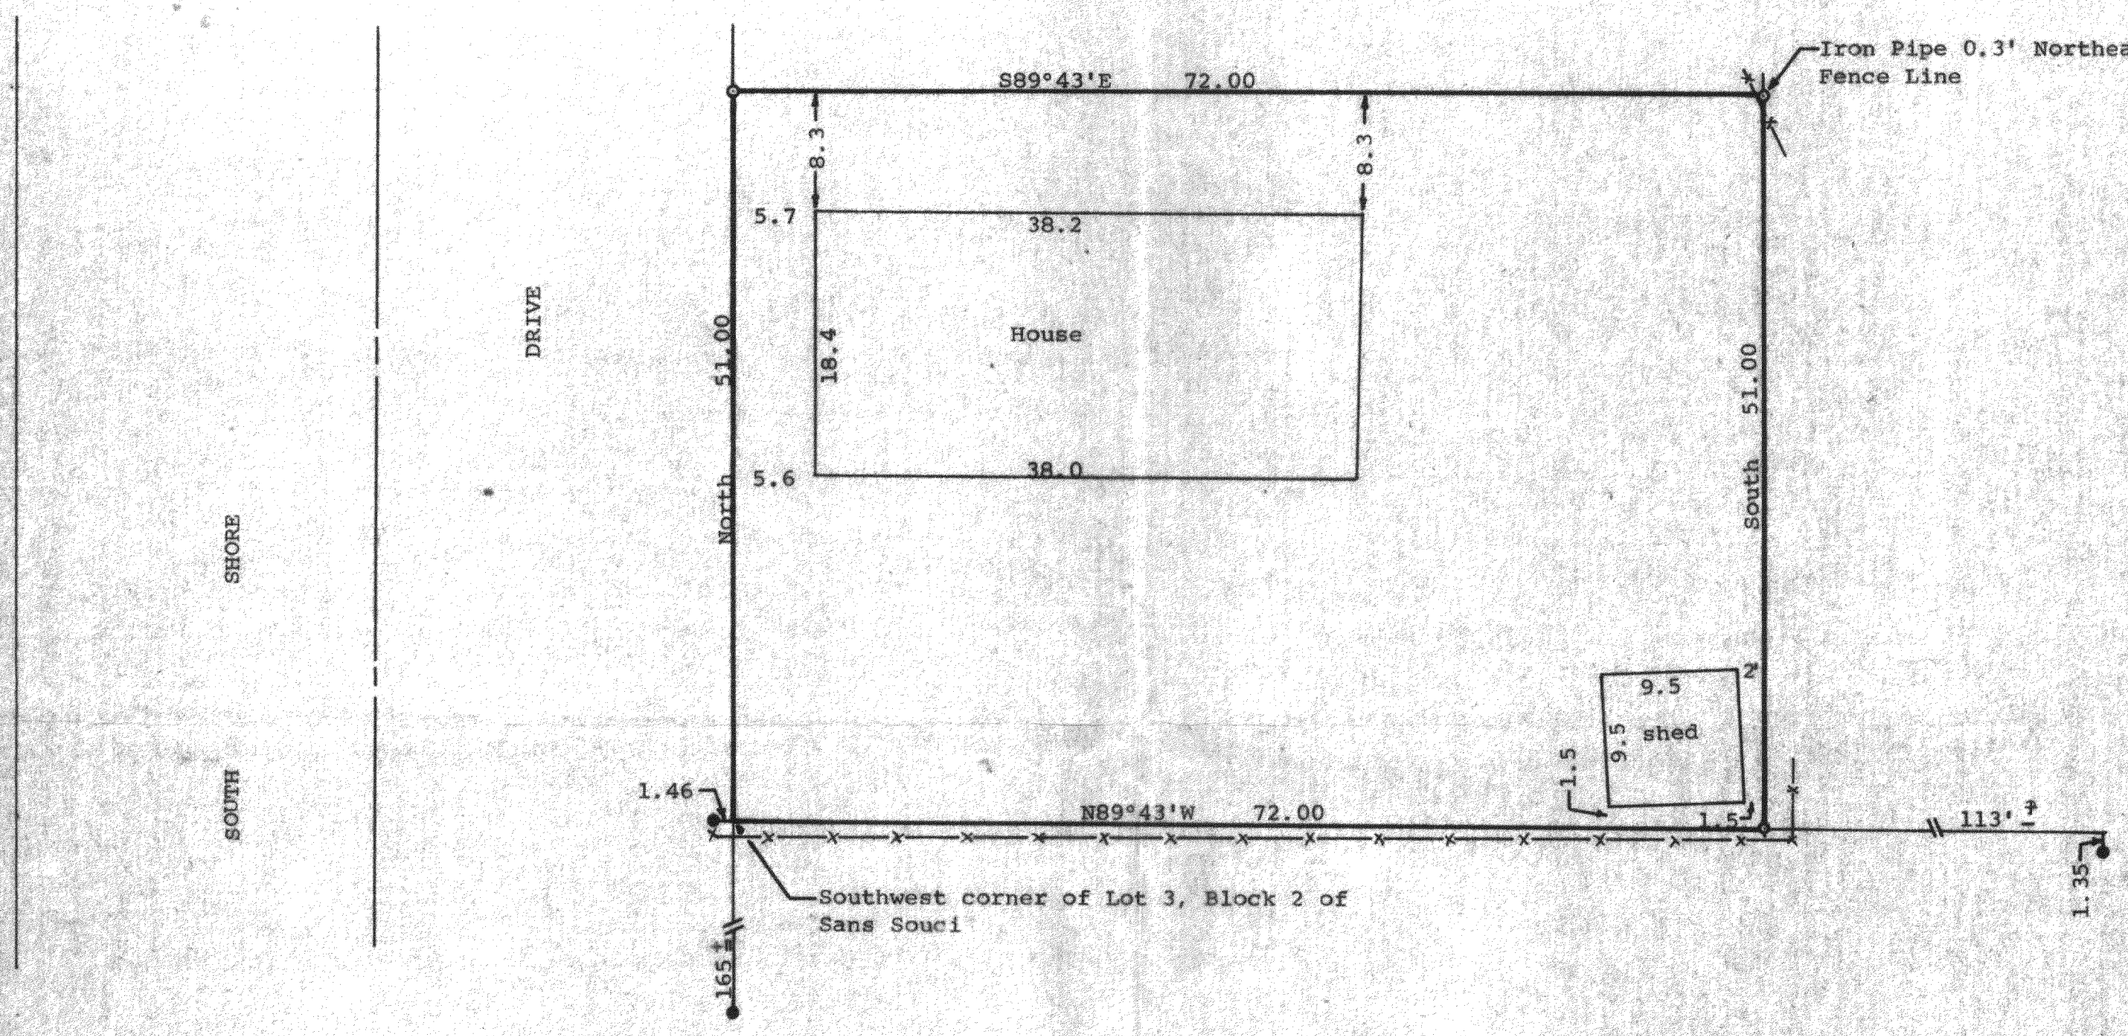

STATE OF WISCONSIN)
SS
COUNTY OF WALWORTH)

I, George T. Dunham, Surveyor, certify that I have surveyed the property described as follows:

A part of Lot 3, Block 2 of Sans Souci, a subdivision located in the Southeast Fractional ¼ of Section 22, T 2 N, R 16 E, Walworth County, Wisconsin described as follows: Beginning at the southwest corner of said Lot 3 on the easterly line of South Shore Drive; thence North along the east line of said road 51.00 feet; thence S89°43'E parallel with the south line of said Lot 3, 72.00 feet; thence South parallel with the east line of the road 51.00 feet to the south line of said Lot 3; thence N89°43'W along said south line 72.00 feet to the place of beginning subject to easements of record.

and that the map shown above is a true representation thereof and shows the size and location of the property, its exterior boundaries, the location of all visible structures, and dimensions of all principal buildings thereon, boundary fences, apparent easements, roadways and visible encroachments, if any, and that I have surveyed the property hereon described according to the official records, to the best of my knowledge and belief.

October 4, 1983

George T. Dunham, Surveyor

Scale - 1" = 10'
● = concrete Monument Found
o = 3/4" X 2' Iron Pipe Set
Bearings referenced to the west line of Lot 3, B. 2 Sans Souci, with the assumed bearing of North
Survey ordered by: Keefe Real Estate, Inc.
Better Homes & Gardens
302 East Walworth Avenue
Delavan, WI 53115

WISCONSIN
GEORGE T. DUNHAM
DELAVAN, WIS.
S-306
LAND SURVEYOR

FSA-00008

216-797-D