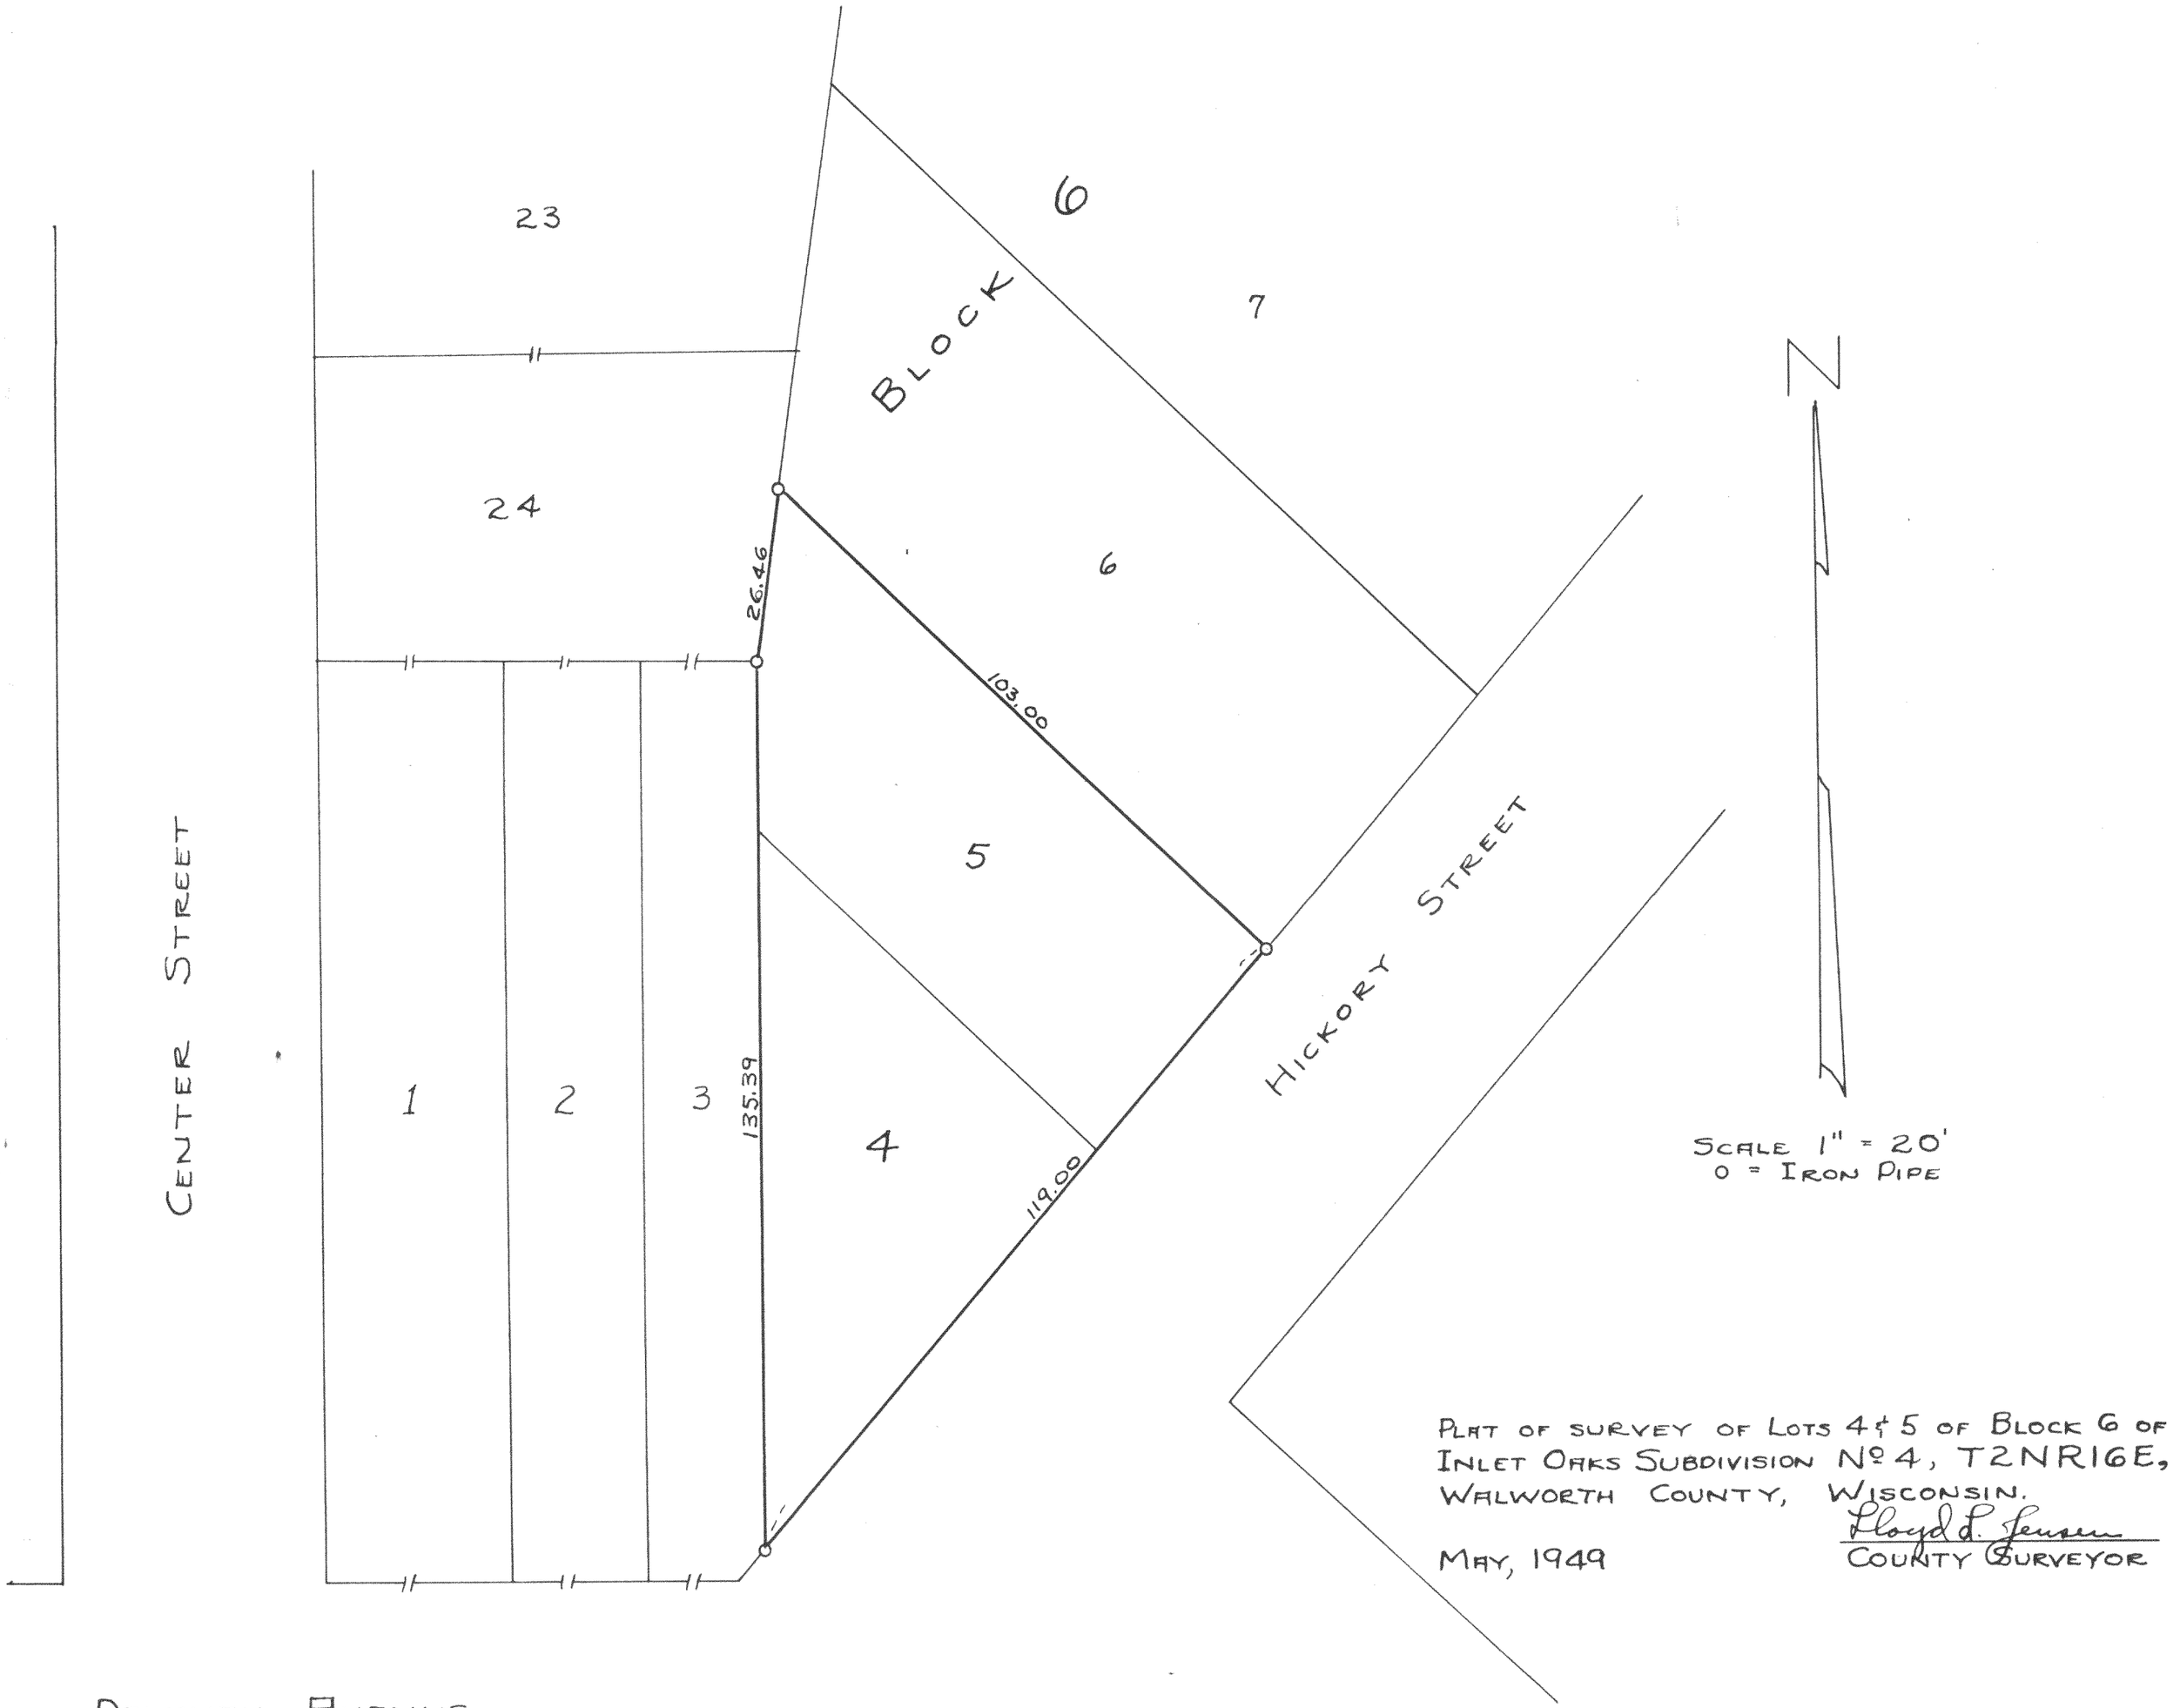


PLAT OF SURVEY OF LOTS 4 & 5 OF BLOCK 6 OF INLET OAKS SUBDIVISION Nº 4, T2NR16E, WALWORTH COUNTY, WISCONSIN.

MAY, 1949

Floyd L. Jensen
COUNTY SURVEYOR

DELAVAN AVENUE

FIN4-43

216-80.1