
ABELL
SURVEYING & MAPPING
DELAVAN, WISCONSIN 53115

RECEIVED
SEPT. 4 1985

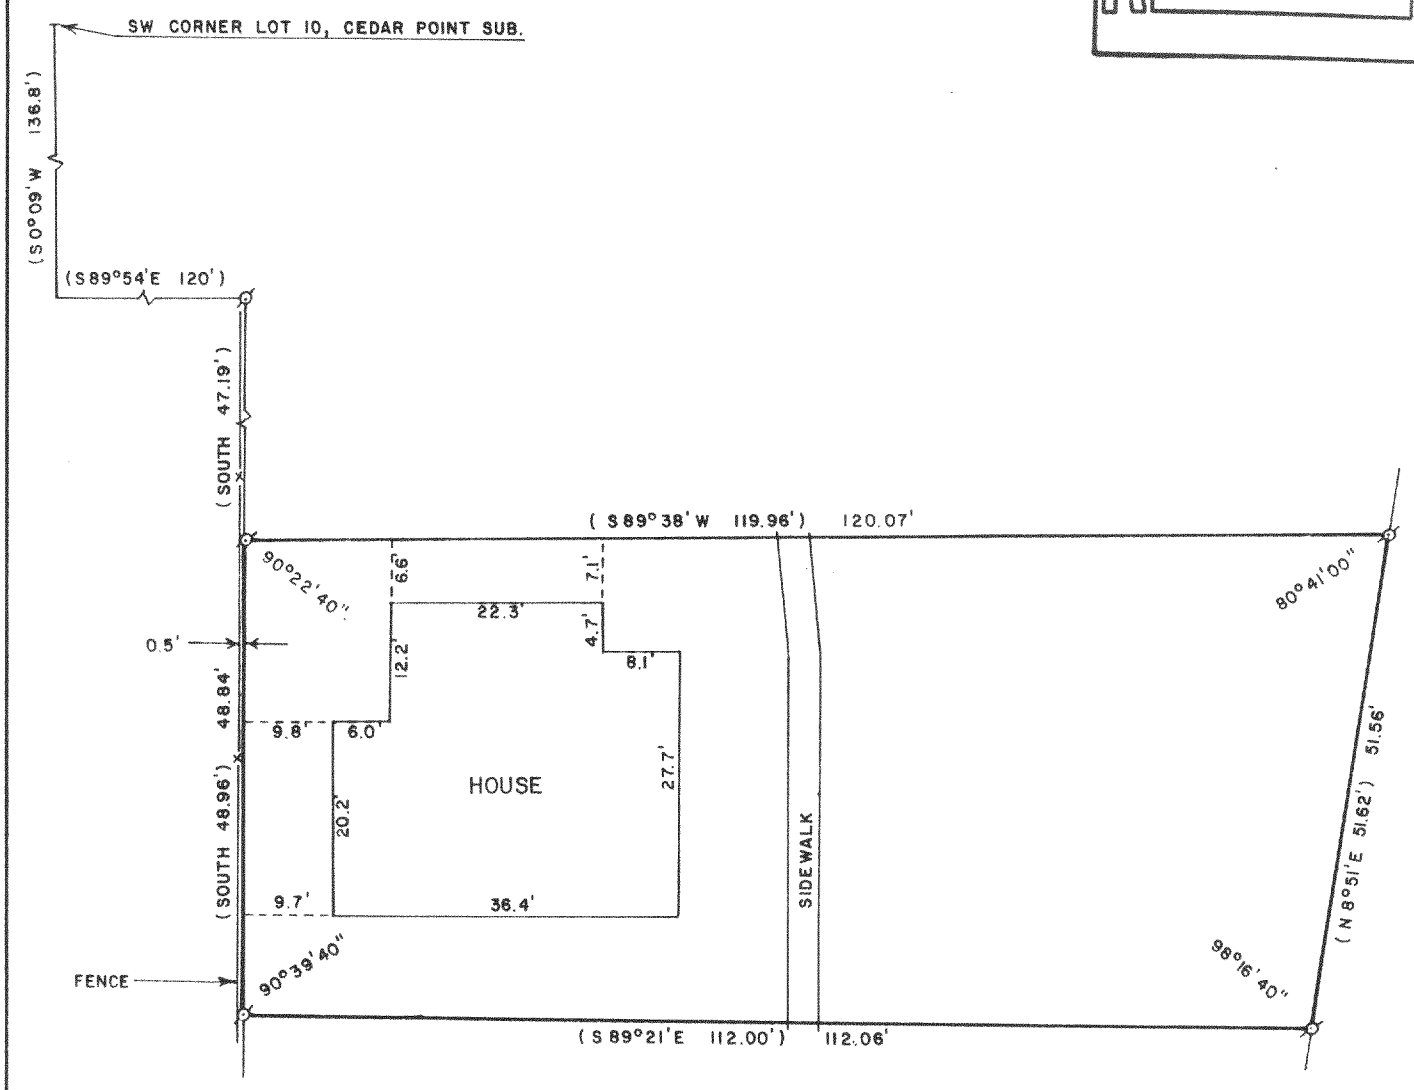

PLAT OF SURVEY OF

PART OF LOT 9 OF CEDAR POINT SUBDIVISION, LOCATED IN THE NORTHEAST 1/4 OF SECTION 28, T 2 N, R 16 E, AS DESCRIBED IN VOLUME 12, PAGE 191 OF RECORDS, WALWORTH COUNTY, WISCONSIN.

ORDERED BY: RICHARD BLOCK
7531 EMERSON
MORTON GROVE, IL 60053

WISCONSIN
DAVID F. ABELL
S-1596
Delavan, Wis.
LAND SURVEYOR

SCALE - 1"=20'

LEGEND

σ - IRON PIPE FOUND
( ) - RECORDED AS

I, DAVID F. ABELL, DO HEREBY CERTIFY THAT I HAVE SURVEYED THE PROPERTY HEREON DESCRIBED ACCORDING TO THE OFFICIAL RECORDS, AND THAT THE PLAT HEREON IS A CORRECT REPRESENTATION OF THE LOT LINES TO THE BEST OF MY KNOWLEDGE AND BELIEF.

David F. Abell
DAVID F. ABELL
WISCONSIN REGISTERED LAND SURVEYOR, S-1596

August 5, 1985
DATE JOB NUMBER - 0885CCL

EC-9J

216-800-A