


DUNHAM SURVEYING, S.C.
SURVEYING & SUBDIVIDING
DELAVAN, WISCONSIN 53115

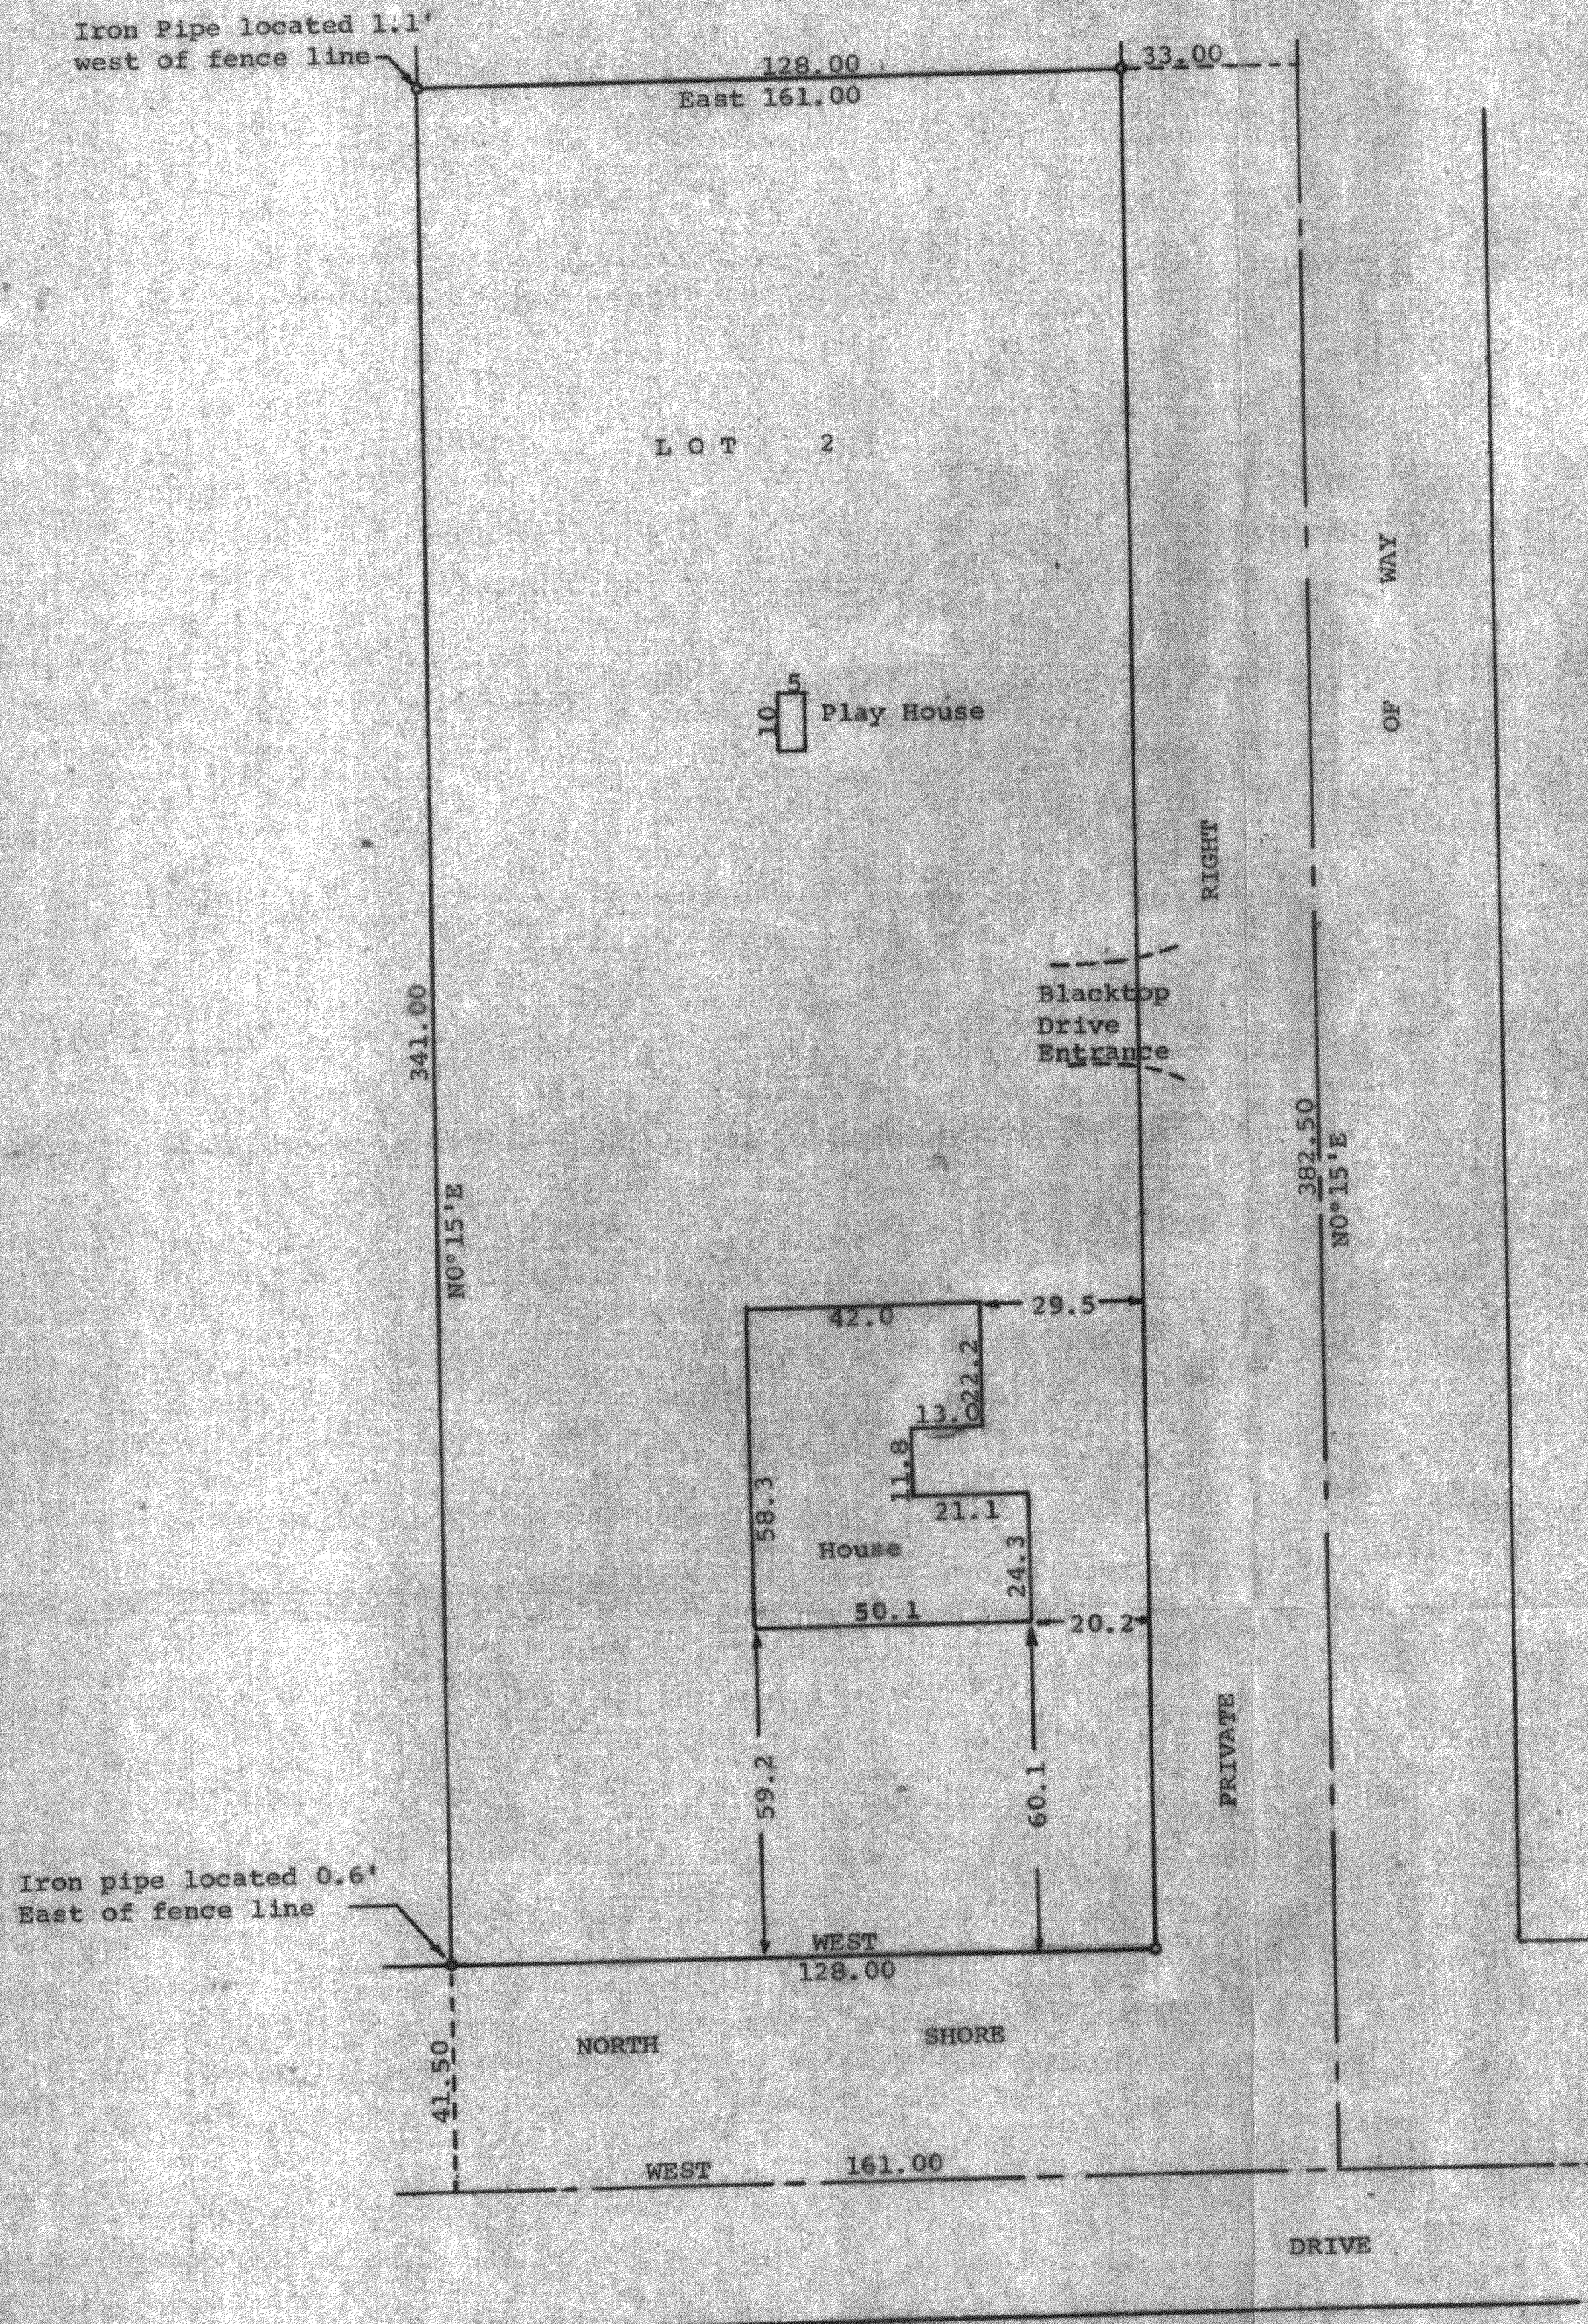

Scale - 1" = 30'
• = 1" Iron Pipe Found
Bearings used are those of record.
Owner: Peter Willemssen
N. Shore Drive
Delavan, WI 53115


STATE OF WISCONSIN)
COUNTY OF WALWORTH)

I, George T. Dunham, Surveyor, certify that I have surveyed the property described as follows:

Lot 2 of Certified Survey No. 654 recorded as Document No. 15104 in Volume 3 of Certified Surveys on Page 139, in the Office of the Register of Deeds in and for Walworth County, Wisconsin, being a parcel of land having a width of 128.00 feet frontage on North Shore Drive and a depth of 341.00 feet. This parcel does not include any portion of that certain private right of way abutting the easterly boundary of Lot 2 and said Lot 2 being located in the Southeast 1/4 of Section 30, T 2 N, R 16 E,

and that the above map is a true representation thereof and shows the size and location of the property, its exterior boundaries, the location of all visible structures and dimensions of all principal buildings thereon, boundary fences, apparent easements, roadways and visible encroachments, if any, and that I have surveyed the property hereon described according to the official records, to the best of my knowledge and belief.
December 7, 1983

George T. Dunham, Surveyor

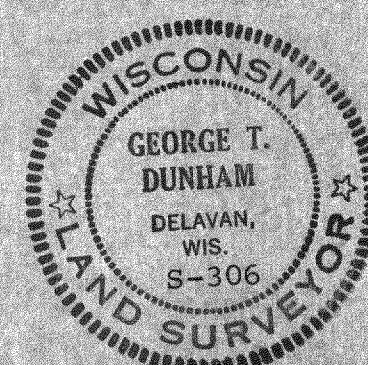

EA654-2

216-800