
DUNHAM SURVEYING, S. C.
SURVEYING & SUBDIVIDING
DELAVAN, WISCONSIN 53115

RECEIVED
SEP - 4 1985
W. L.



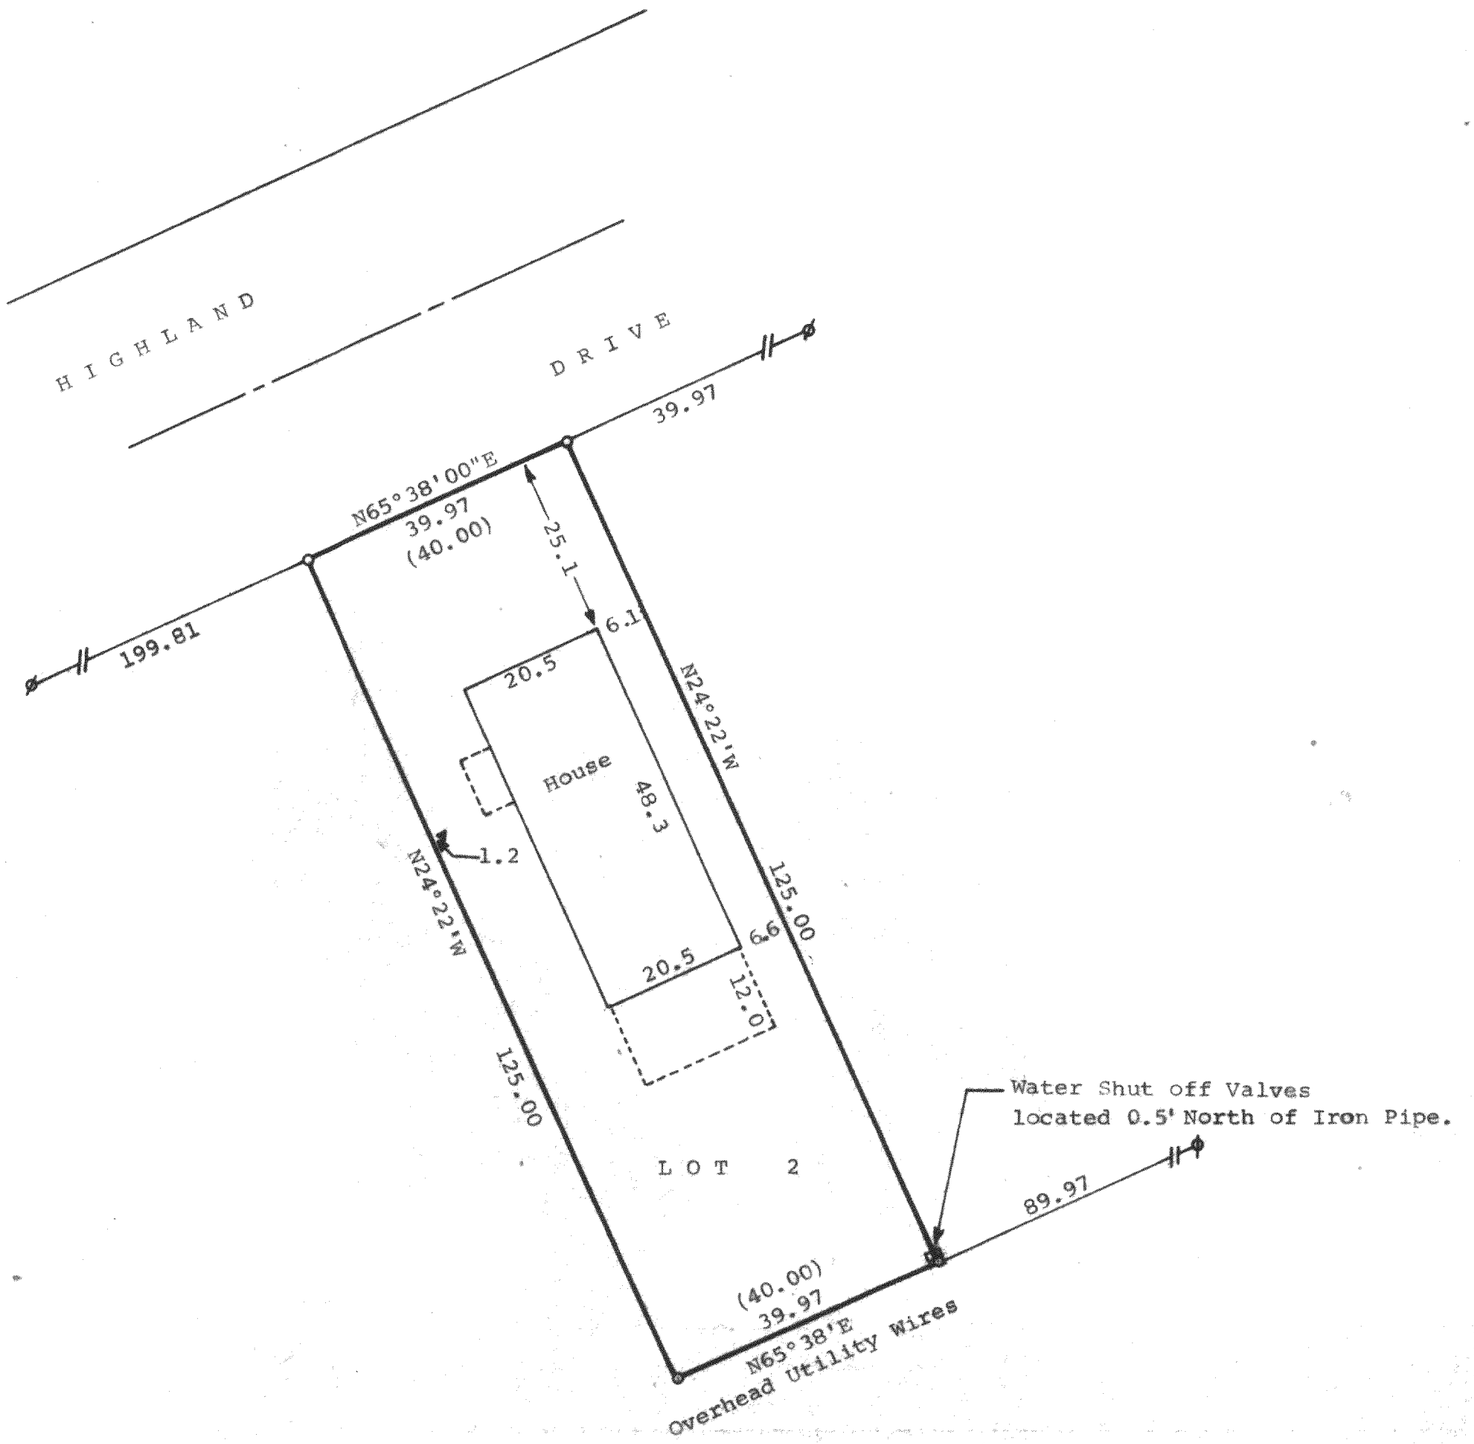

Scale - 1" = 20'
o = 3/4"x24" Iron Pipe Set
ø = 3/4" Dia. Iron Pipe Found
◂ = Well
ø = ½" Dia. Iron Pipe Found
(00.00) = Recorded Distance
Bearings are referenced to the Southeasterly line of Highland Drive, Assumed bearing of N65°38'E.
Survey Ordered By:
The Rauland Agency
607 E. Walworth Ave.
Delavan, WI 53115

STATE OF WISCONSIN) SS
COUNTY OF WALWORTH)

I, Richard C. Schulz, Surveyor, certify that I have surveyed the property described as follows,

Lot 2, Block 19 of Delavan Lake View Crest, a subdivision located in the North ½ of Section 31, T2N, R16E, Walworth County, Wisconsin,

and that the above map is a true representation thereof and shows the size and location of the property, its exterior boundaries, the location of all visible structures and dimensions of all principal buildings thereon, boundary fences, apparent easements, roadways and visible encroachments, if any, and that I have surveyed the property hereon described according to the official records, to the best of my knowledge and belief.

June 28, 1985.

Richard C. Schulz

Richard C. Schulz, Surveyor

WISCONSIN
RICHARD C. SCHULZ
S-1671
DELAVAN
WI
LAND SURVEYOR

FDLV-171

216-809-D

K & E 10-9155