
DUNHAM SURVEYING, S. C.
SURVEYING & SUBDIVIDING
DELAVAN, WISCONSIN 53115

RECEIVED
SEP 4 1985

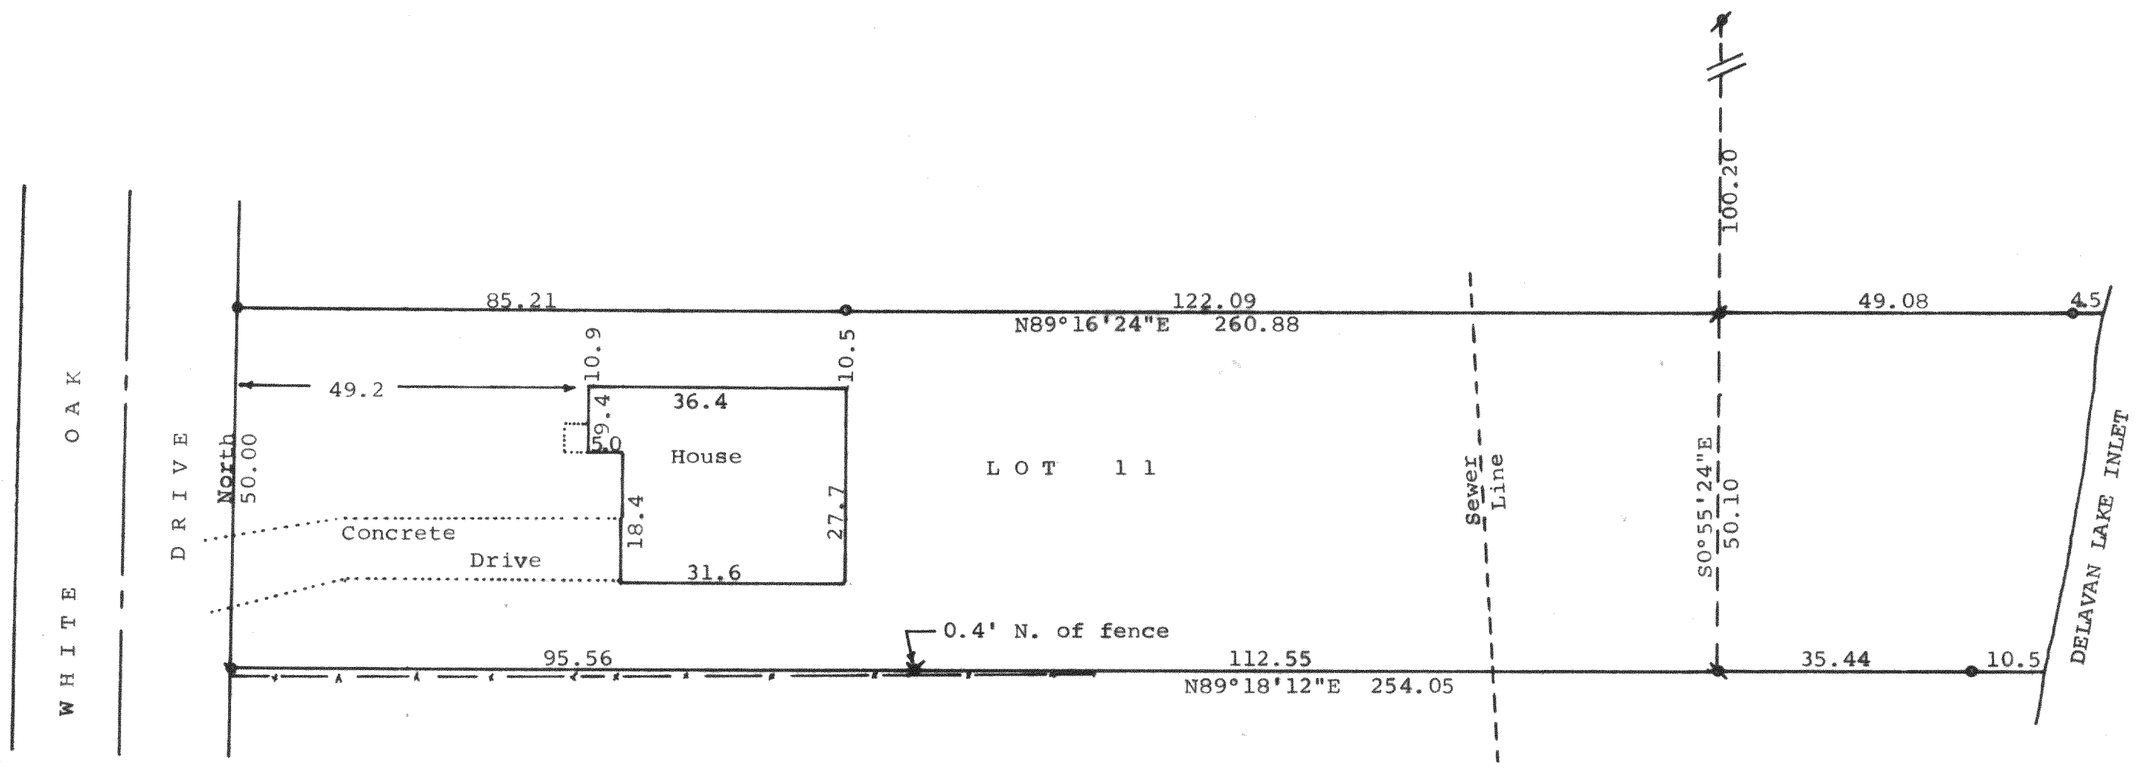



STATE OF WISCONSIN)
COUNTY OF WALWORTH) SS

I, George T. Dunham, Surveyor, certify that I have surveyed the property described as follows:

Lot 11 of The Annex to Inlet Oaks, located in Section 22, T 2 N, R 16 E, Walworth County, Wisconsin,

and that the map shown above is a true representation thereof and shows the size and location of the property, its exterior boundaries, the location of all visible structures and dimensions of all principal buildings thereon, boundary fences, apparent easements, roadways and visible encroachments, if any, and that I have surveyed the property hereon described according to the official records to the best of my knowledge and belief.

August 9, 1985

George T. Dunham, Surveyor

WISCONSIN LAND SURVEYOR
GEORGE T. DUNHAM
S-306
DELAVAN WIS.

Scale - 1" = 20'
● = 1½" Iron Pipe Found
⌀ = 1¼" Iron Pipe Found
◥ = 3/4" Iron Pipe Found
✖ = ½" Iron Pipe Found
○ = 3/4" X 24" Iron Pipe Set
—‹——‹— = Fence Line
Bearings referenced to the assumed bearing of North along the east line of White Oak Drive
Survey ordered by: Carmin Realtors
537 Laurel Heights Dr.
Delavan, WI 53115
⌀ = 1" X 24" Iron Pipe Set

FIA-00010

216-875

K & E 10-9155