
DUNHAM SURVEYING, S. C.
SURVEYING & SUBDIVIDING
DELAVAN, WISCONSIN 53115

RECEIVED
SEP - 4 1985

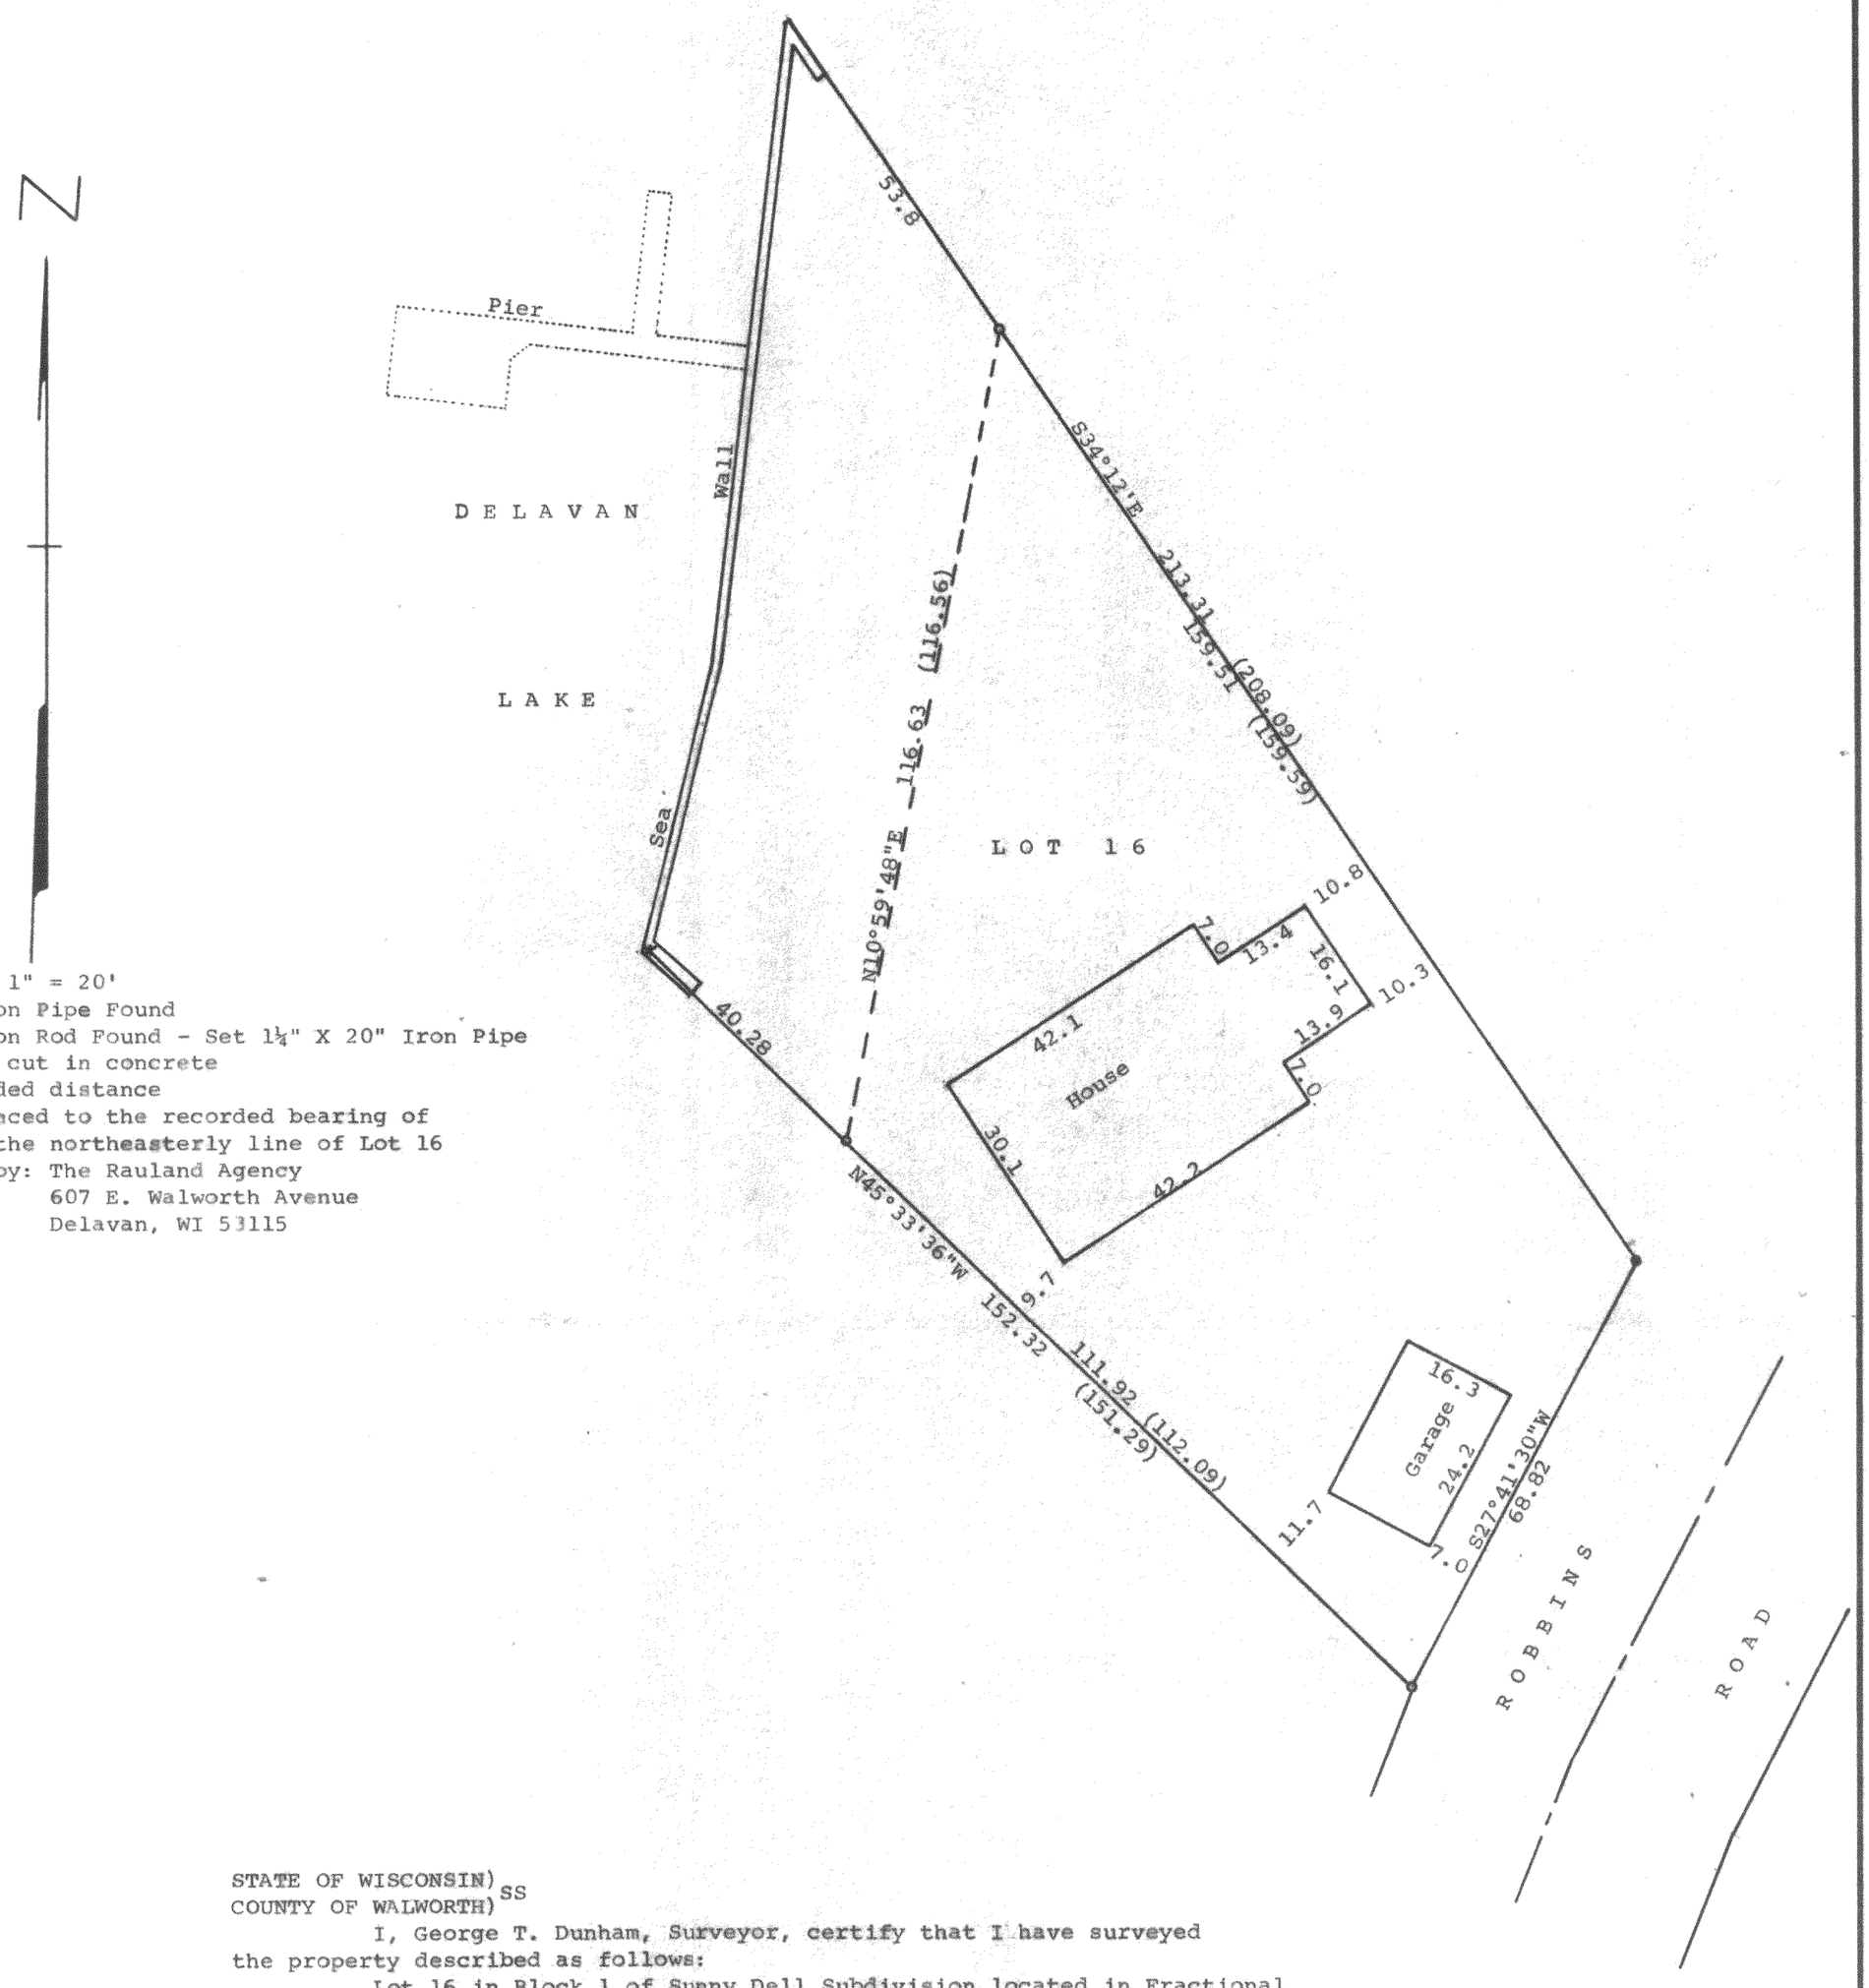

Scale - 1" = 20'
o = 1" Iron Pipe Found
● = ¼" Iron Rod Found - Set 1¼" X 20" Iron Pipe
× = cross cut in concrete
(0.00) = recorded distance
Bearings referenced to the recorded bearing of S34°12'E along the northeasterly line of Lot 16
Survey ordered by: The Rauland Agency
607 E. Walworth Avenue
Delavan, WI 53115

STATE OF WISCONSIN)
COUNTY OF WALWORTH) SS

I, George T. Dunham, Surveyor, certify that I have surveyed the property described as follows:

Lot 16 in Block 1 of Sunny Dell Subdivision located in Fractional Section 32, T 2 N, R 16 E, Walworth County, Wisconsin,

and that the map shown above is a true representation thereof and shows the size and location of the property, its exterior boundaries, the location of boundary fences, apparent easements, roadways and visible encroachments, if any, and that I have surveyed the property hereon described according to the official records to the best of my knowledge and belief.

May 17, 1985

George T. Dunham
George T. Dunham, Surveyor

WISCONSIN
GEORGE T. DUNHAM
S-306
DELAVAN WIS.
LAND SURVEYOR

FSU-00016

K & E 10-9155

216820-D