
KOLB LAND CONSULTING, INC.

LAND SURVEYING · SUBDIVIDING · LAND PLANNING

928 WILLIAMS STREET LAKE GENEVA, WISCONSIN 53147 414-248-3697

RECEIVED
APR 11 1986

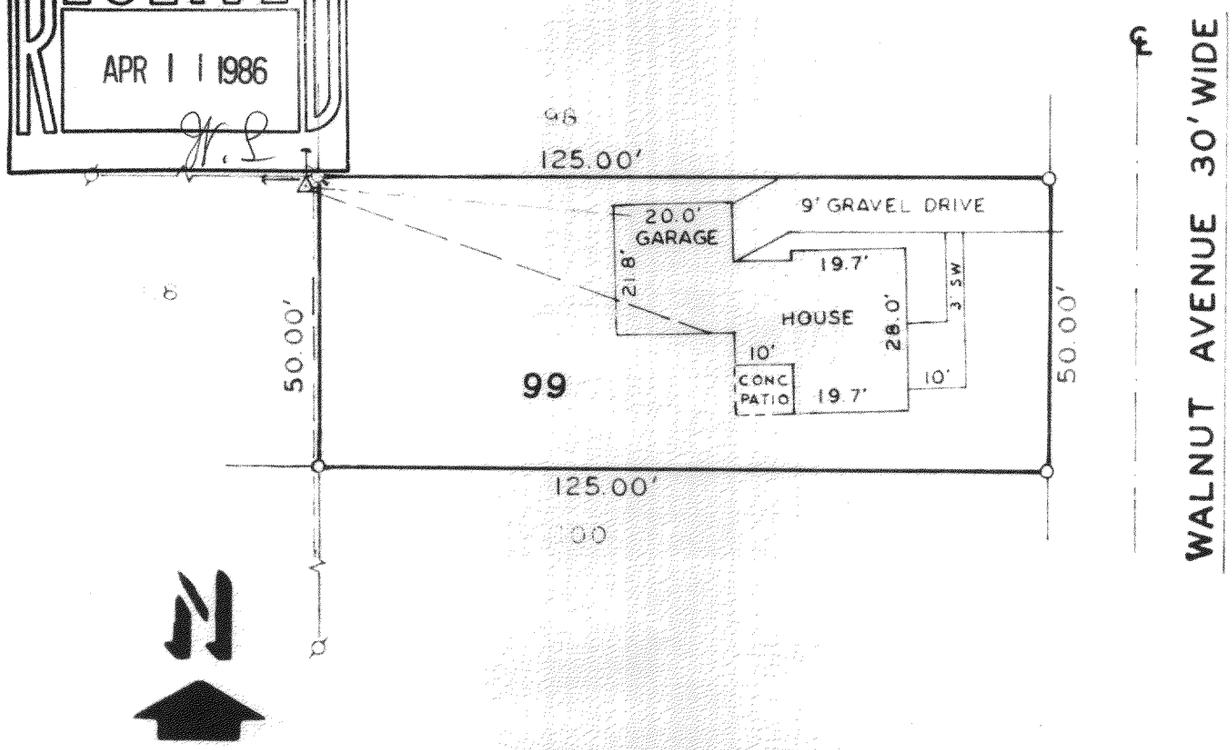

SCALE: 1" = 30'

ORDERED BY:
FIRST BANK SOUTHEAST
P.O. BOX 327
DELAVAN, WI. 53115

LEGEND

- Ø - IRON PIPE FOUND
- o - 1" X 24" IRON PIPE SET
- ^ - UTILITY POLE
- ⊥ - UTILITY POLE ANCHOR
- — — OVERHEAD UTILITY LINE
- SW SIDE WALK

PLAT OF SURVEY OF

LOT 99 OF LAKE DELAVAN HIGHLANDS SUBDIVISION, TOWN OF DELAVAN, WALWORTH COUNTY, WISCONSIN.

I HEREBY CERTIFY THAT I HAVE SURVEYED THE ABOVE DESCRIBED PROPERTY AND THAT THE ABOVE MAP IS A TRUE REPRESENTATION THEREOF AND SHOWS THE SIZE AND LOCATION OF THE PROPERTY, ITS EXTERIOR BOUNDARIES, THE LOCATION OF ALL VISIBLE STRUCTURES AND DIMENSIONS OF ALL PRINCIPAL BUILDINGS THEREON, BOUNDARY FENCES, APPARENT EASEMENTS, ROADWAYS AND VISIBLE ENCROACHMENTS, IF ANY, TO THE BEST OF MY KNOWLEDGE AND BELIEF.
THIS SURVEY IS MADE FOR THE USE OF THE PRESENT OWNERS OF THE PROPERTY, AND ALSO THOSE WHO PURCHASE, MORTGAGE, OR GUARANTEE THE TITLE THERETO WITHIN ONE (1) YEAR FROM DATE HEREOF.

Harold H. Kolb

HAROLD H. KOLB

WISCONSIN REGISTERED LAND SURVEYOR, S-187

DATE DECEMBER 5, 1985

REVISED

REVISED

FLAD-80

216-823-K