
DUNHAM SURVEYING, S.C.
SURVEYING & SUBDIVIDING
DELAVAN, WISCONSIN 53115

RECEIVED
MAY 5 1986



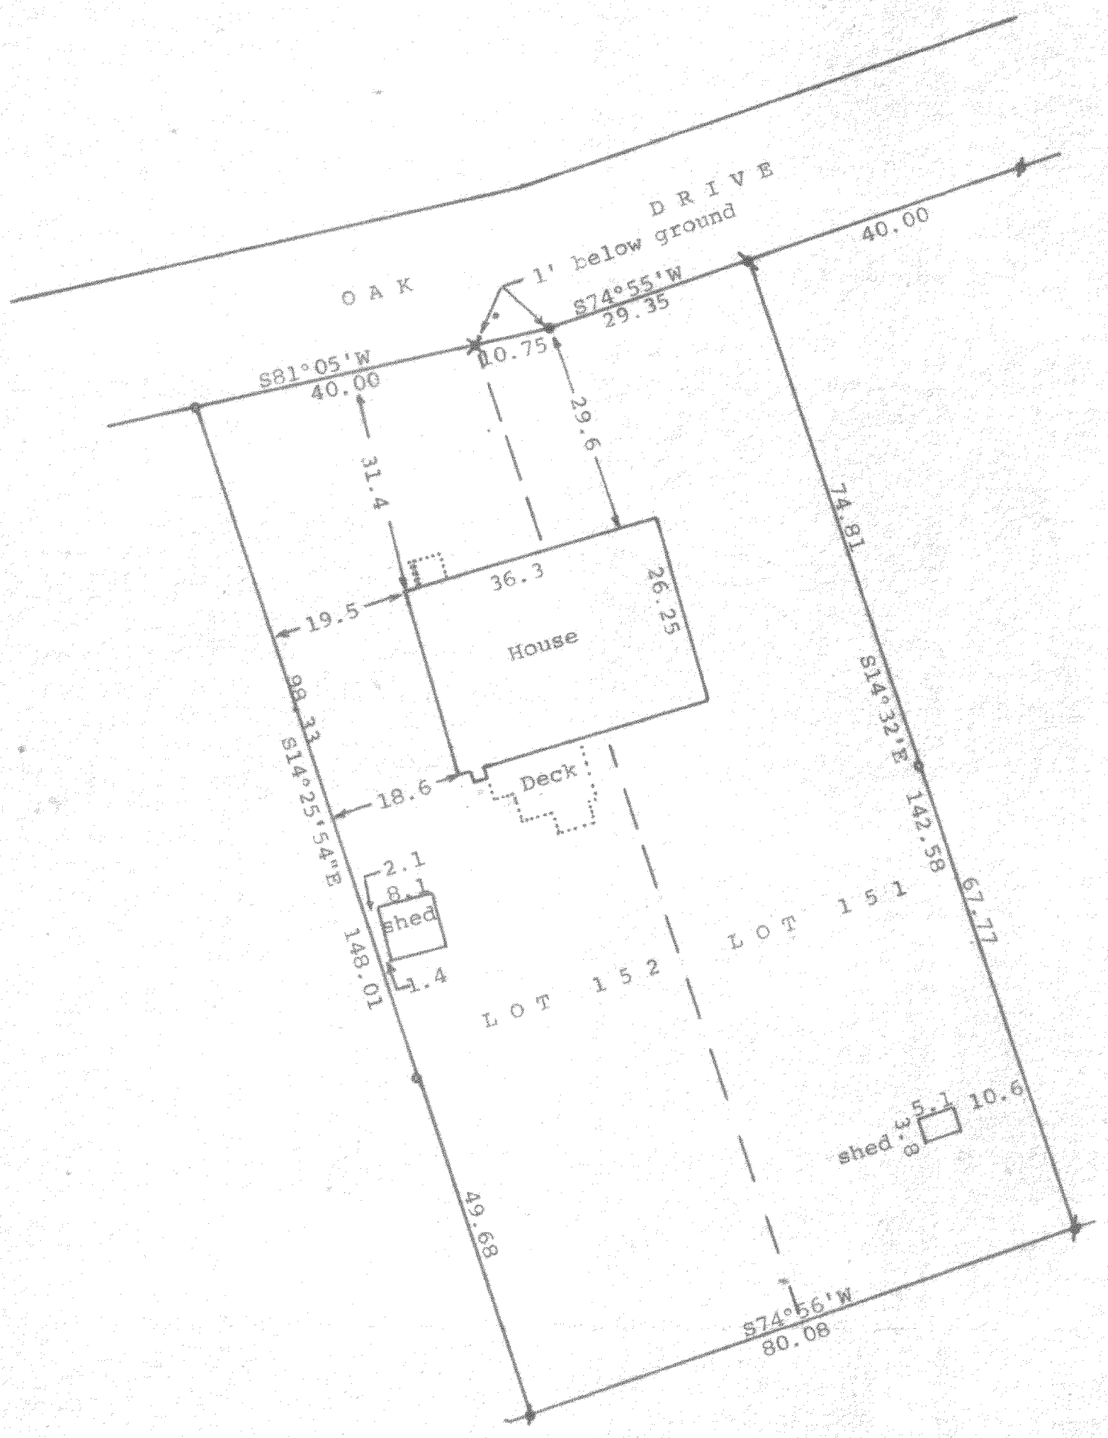

Scale - 1" = 20'
⊙ = 3/4" X 24" Iron Pipe Set
● = Concrete Monument Found
/ = ½" Square Iron Rod Found
✕ = 1¼" Iron Pipe Found
Survey ordered by: Century 21 Skandia Realty Inc
312 South 7th Street
Delavan, WI 53115
◥ = 1¼" X 24" iron Pipe Set
Bearings referenced to the assumed bearing of S74°55'W along the northerly line of Lot 151

STATE OF WISCONSIN) SS
COUNTY OF WALWORTH)

I, George T. Dunham, Surveyor, certify that I have surveyed the property described as follows:

Lots 151 and 152 of Krumhaar's 2nd Addition to Ravenswood, a subdivision located in Section 31, T 2 N, R 16 E, Walworth County, Wisconsin,

and that the above map is a true representation thereof and shows the size and location of the property, its exterior boundaries, the location of all visible structures and dimensions of all principal buildings thereon, boundary fences, apparent easements, roadways and visible encroachments, if any, and that I have surveyed the property hereon described according to the official records, to the best of my knowledge and belief.

April 9, 1986

George T. Dunham, Surveyor

WISCONSIN LAND SURVEYOR
GEORGE T. DUNHAM
S-306
DELAVAN WIS.

FRA2-42

216-829-D

73307
GMB 1020