
DUNHAM SURVEYING, S.C.

SURVEYING & SUBDIVIDING

DELAVAN, WISCONSIN 53115

RECEIVED
MAY 5 1986

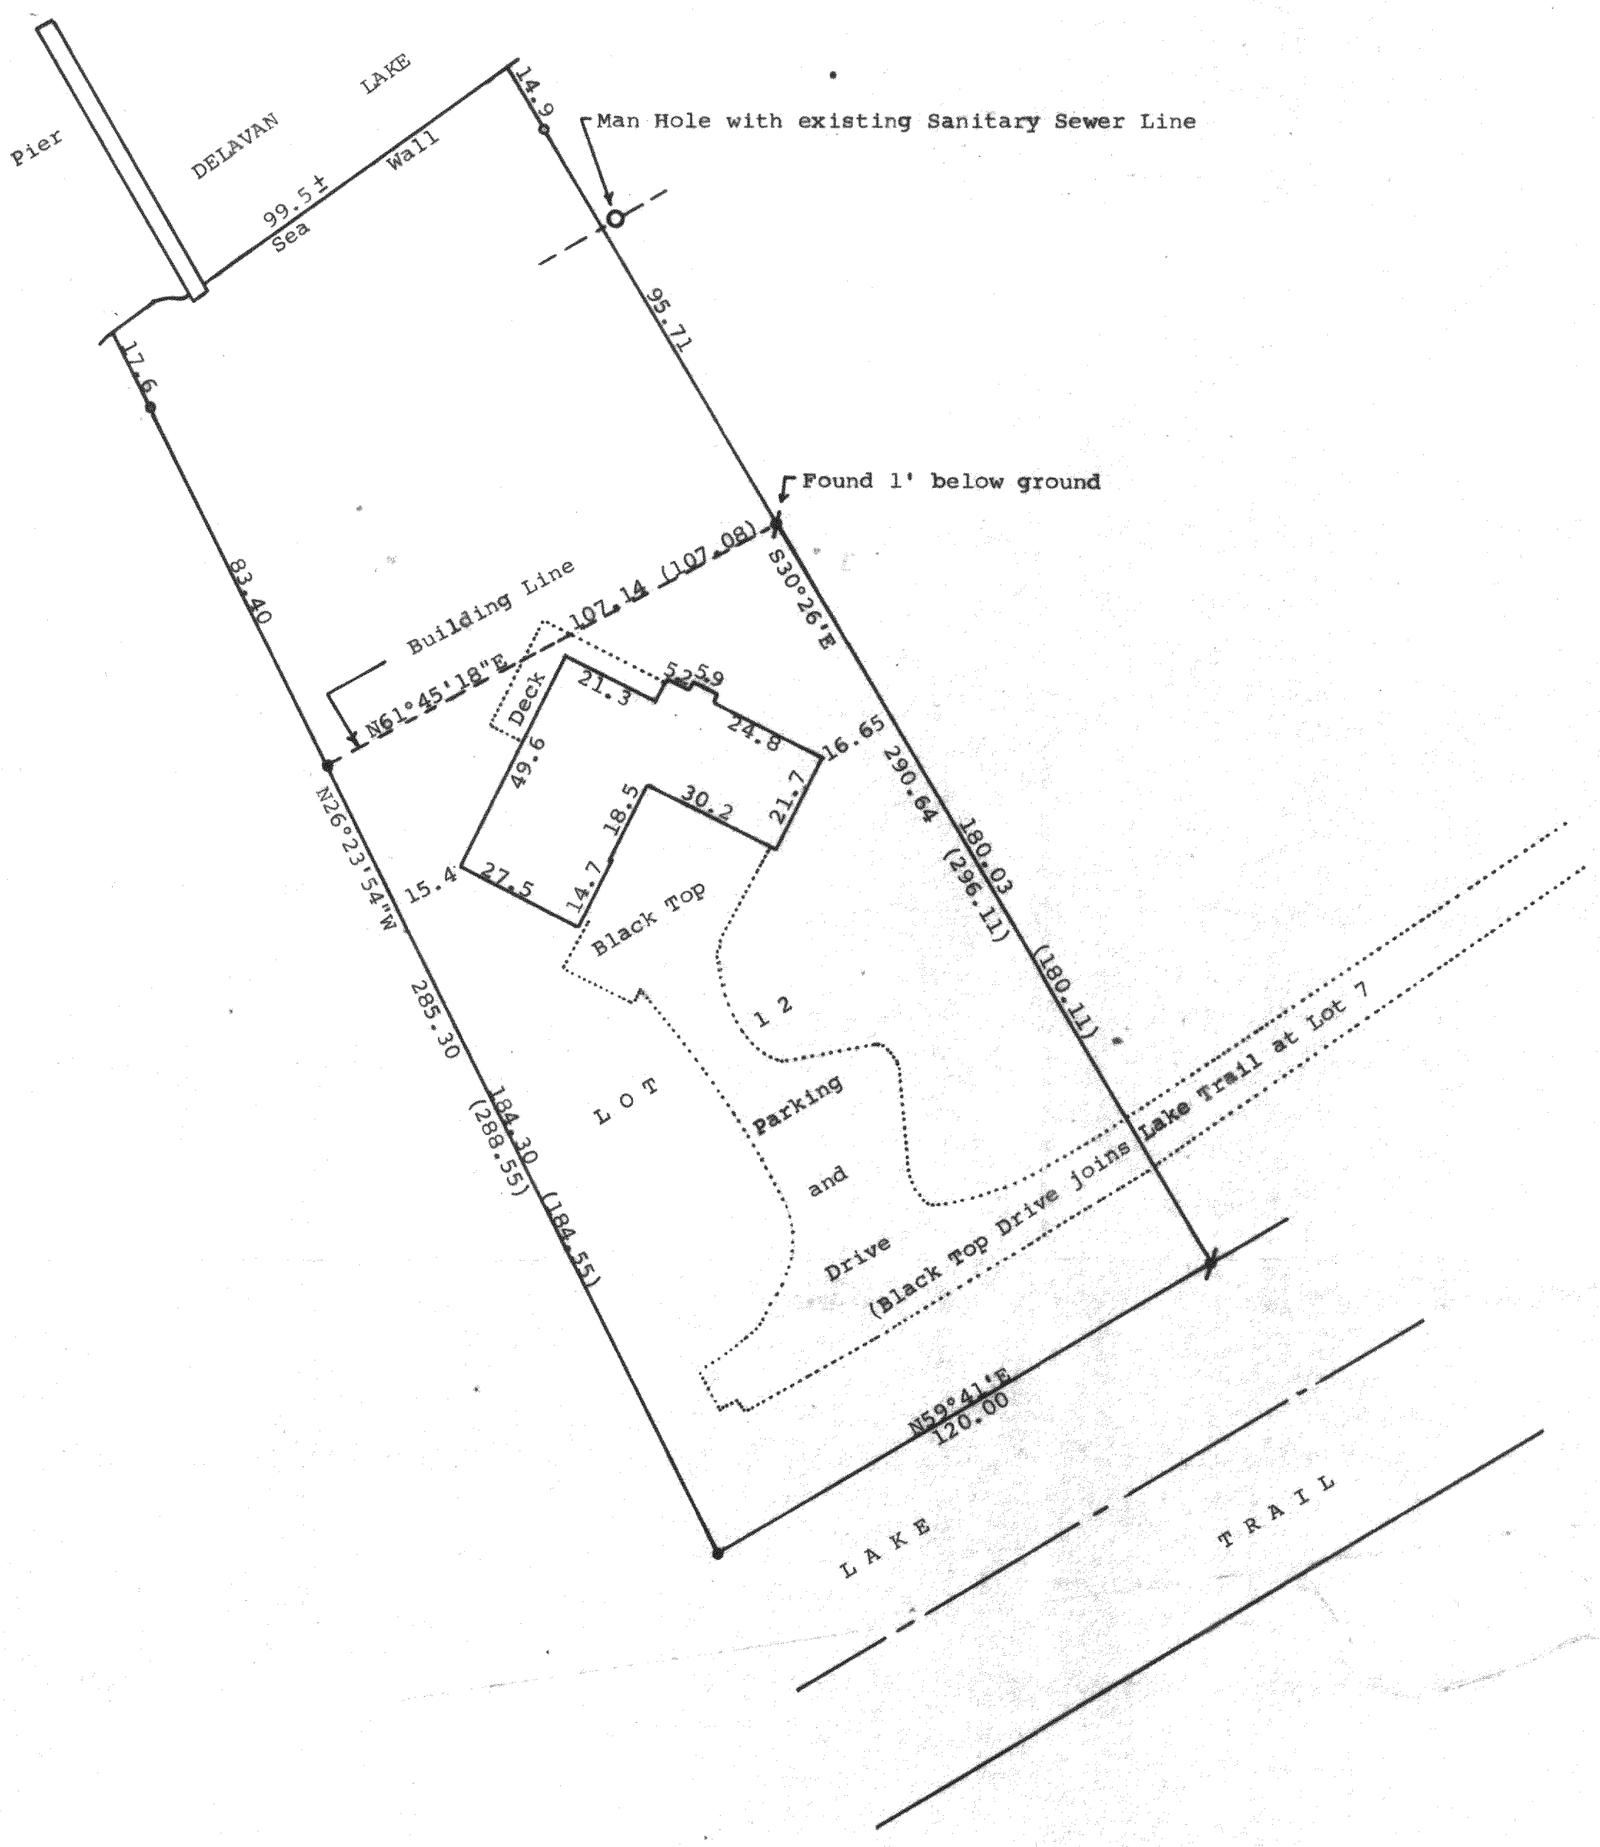

Scale - 1" = 30'
● = 5" Concrete Monument Found
✓ = 1" Iron Pipe Found
○ = 3/4" X 24" Iron Pipe Set
Bearings referenced to the northwesterly side of Lake Trail with the recorded bearing of N59°41'E
(0.00) = recorded distance
Survey ordered by: The Rauland Agency
Kenosha Street
Walworth, WI 53184

STATE OF WISCONSIN)
COUNTY OF WALWORTH) SS

I, George T. Dunham, Surveyor, certify that I have surveyed the property described as follows:

Lot 12 in Lakewood Estates, a subdivision located in the Southwest ¼ of Section 21, T 2 N, R 16 E, Walworth County, Wisconsin,

and that the map shown above is a true representation thereof and shows the size and location of the property, its exterior boundaries, the location of all visible structures and dimensions of all principal buildings thereon, boundary fences, apparent easements, roadways, and visible encroachments, if any, and that I have surveyed the property hereon described according to the official records to the best of my knowledge and belief.

September 18, 1985

George T. Dunham, Surveyor

WISCONSIN LAND SURVEYOR
GEORGE T. DUNHAM
S-306
DELAVAN WIS.

FLE-12

216-831

K & E 10-9153