
DUNHAM SURVEYING, S. C.
SURVEYING & SUBDIVIDING
DELAVAN, WISCONSIN 53115

RECEIVED
AUG 19 1986

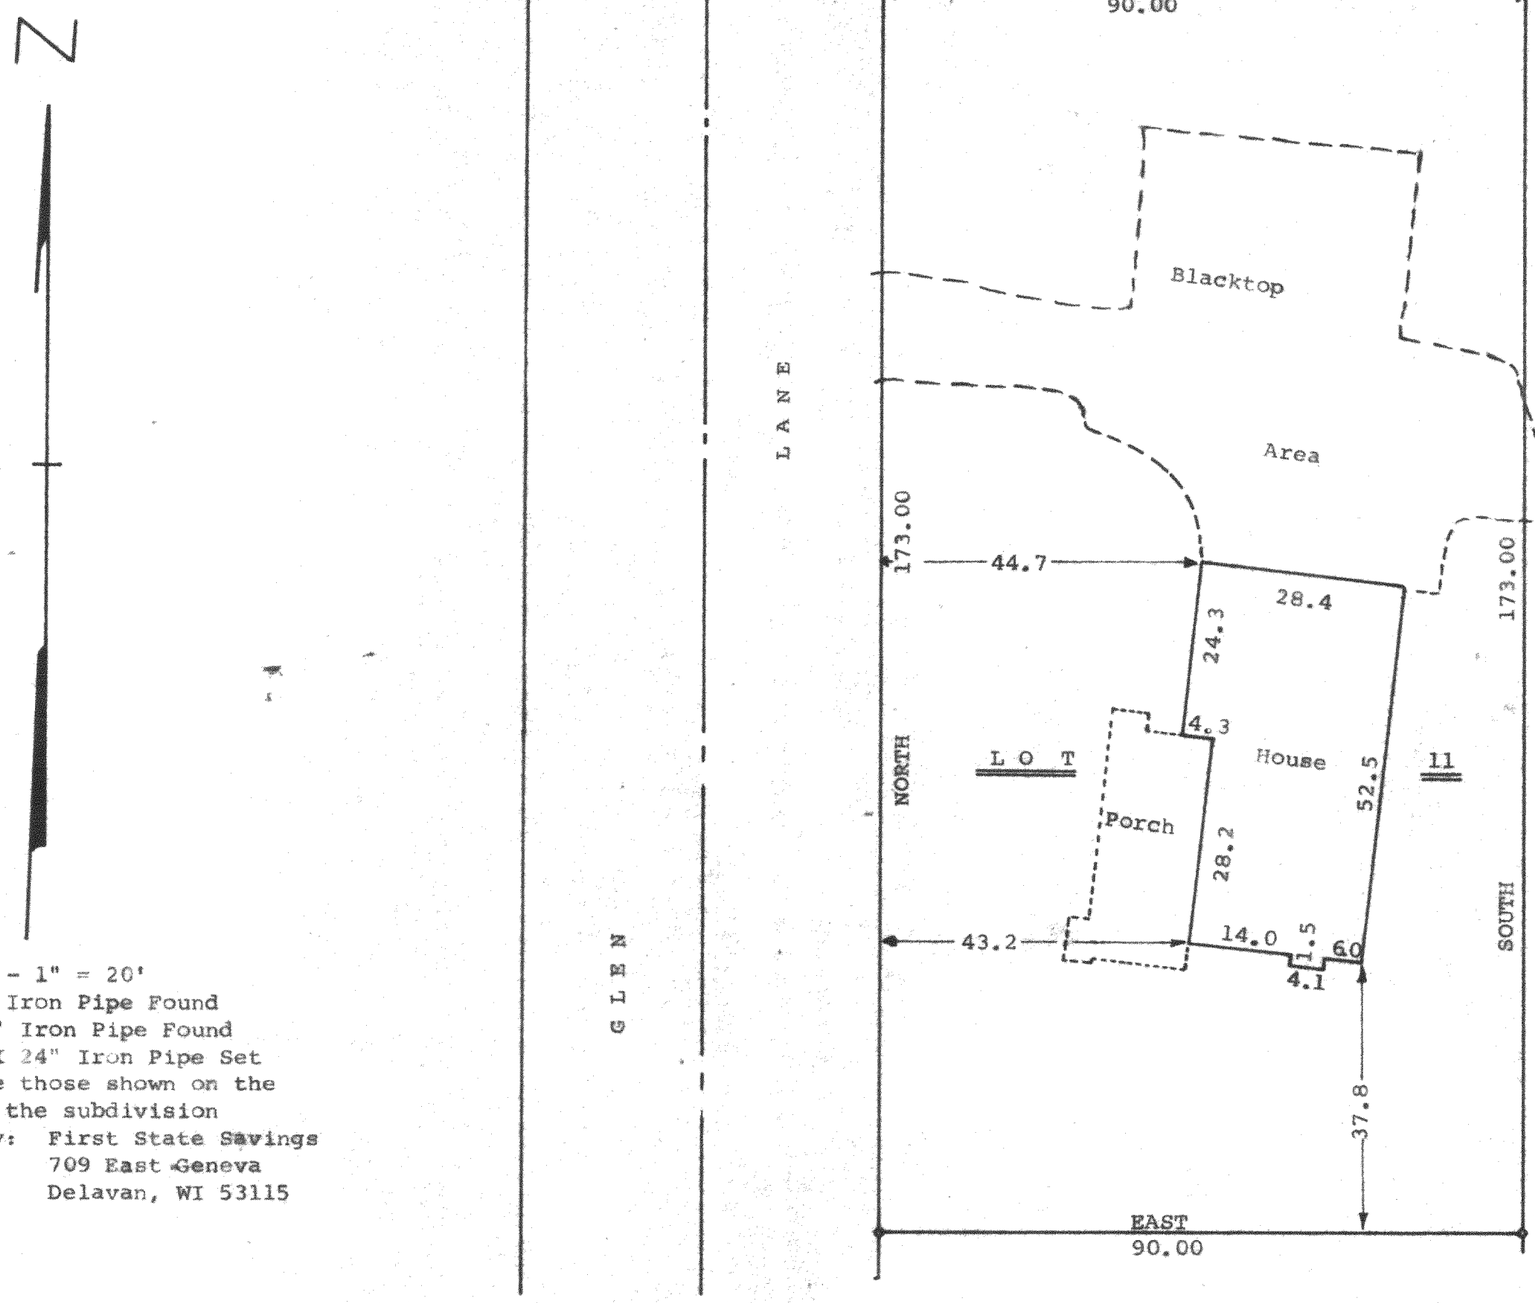

Scale - 1" = 20'
o = 1⅛" Iron Pipe Found
ø = 3/4" Iron Pipe Found
⊗ = 1" X 24" Iron Pipe Set
Bearings used are those shown on the recorded plat of the subdivision
Survey ordered by: First State Savings
709 East Geneva
Delavan, WI 53115

STATE OF WISCONSIN)
COUNTY OF WALWORTH) SS

I, George T. Dunham, Surveyor, certify that I have surveyed the property described as follows,

Lot 11 of the Re-subdivision of Lots 1 and 3 of Glen Eyrie, a subdivision located in Fractional Sections 28 and 29, T2N, R16E, Walworth County, Wisconsin,

and that the map shown above is a true representation thereof and shows the size and location of the property, its exterior boundaries, the location of all visible structures and dimensions of all principal buildings, thereon boundary fences, apparent easements, roadways and visible encroachments, if any, and that I have surveyed the property hereon described according to the official records to the best of my knowledge and belief.

June 13, 1986.

George T. Dunham, Surveyor

WISCONSIN
GEORGE T. DUNHAM
S-306
DELAVAN WIS.
LAND SURVEYOR

78307
OMB 1020

F&E-11

216-847