
ABELL
SURVEYING & MAPPING
DELAVAN, WISCONSIN 53115
414-728-6737

RECEIVED
JAN 7 19

ORDERED BY: CENTURY 21-SKANDIA REALTY
312 S. 7th STREET
DELAVAN, WI 53115

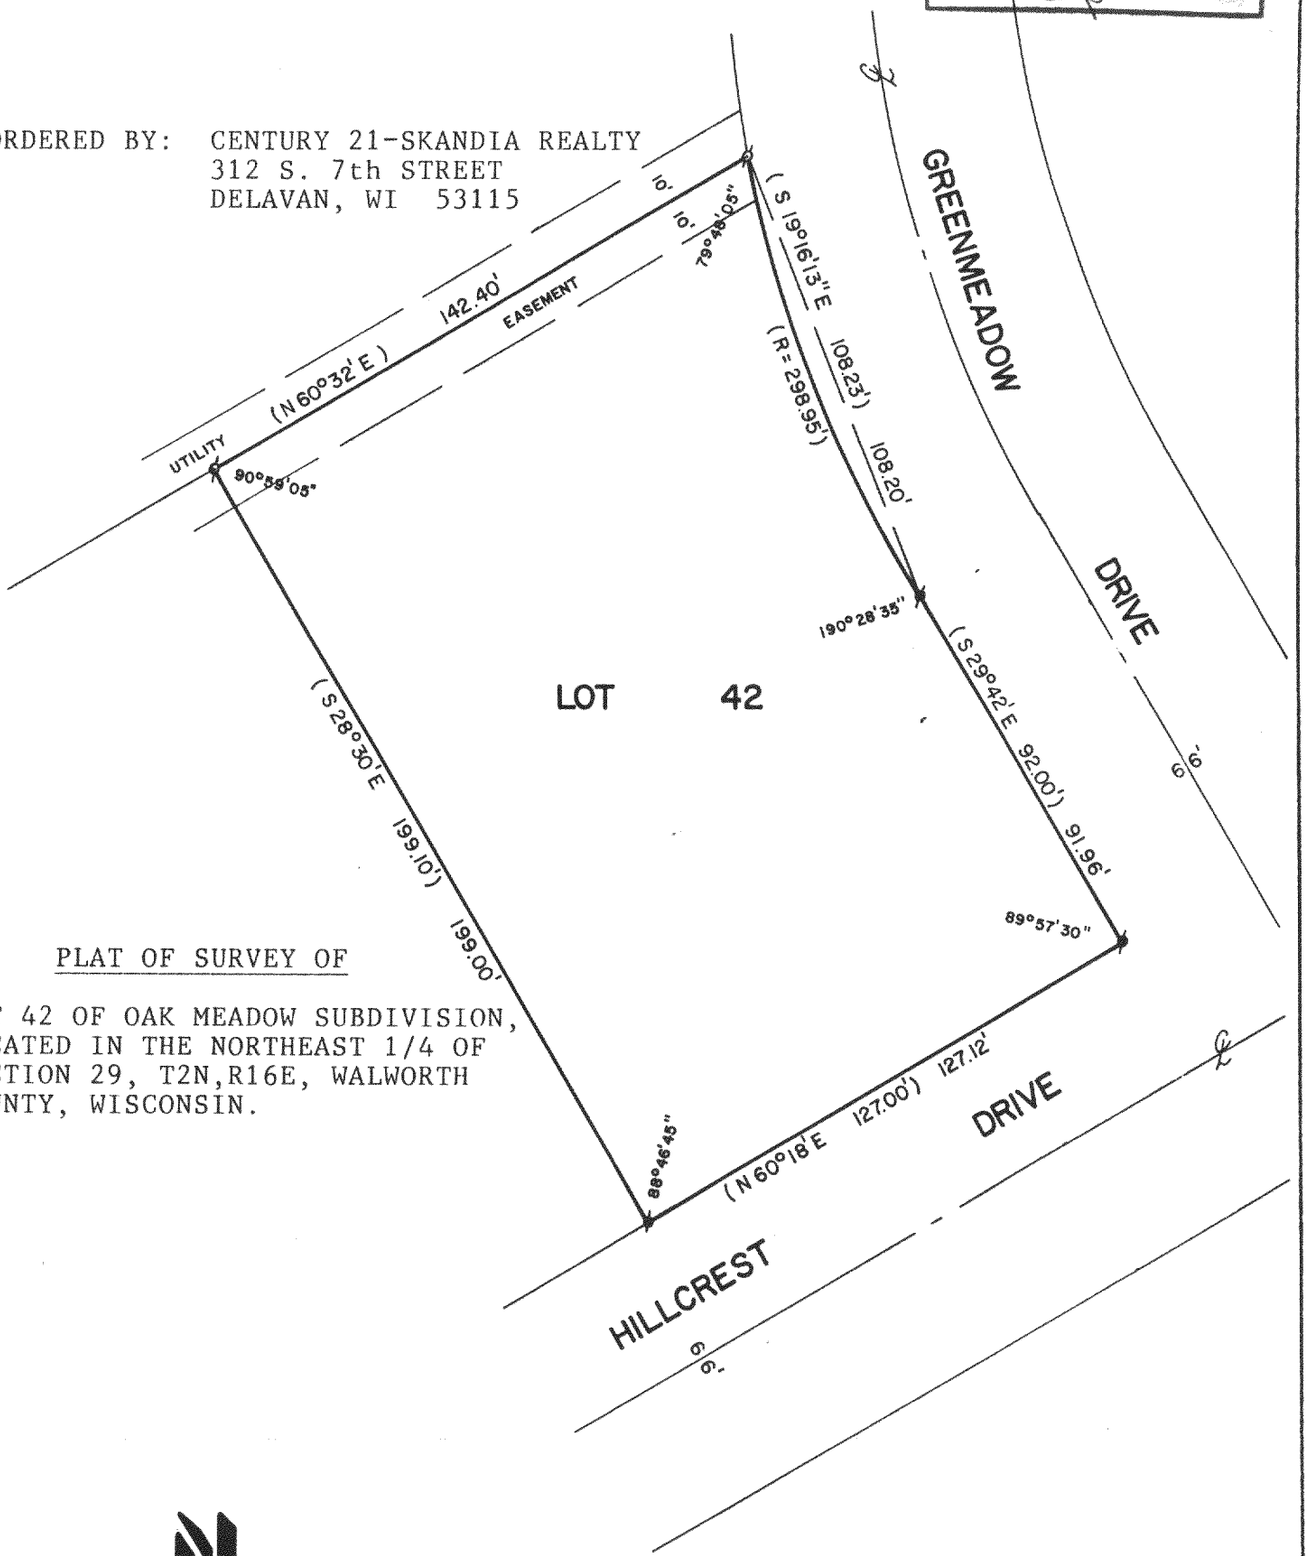

PLAT OF SURVEY OF

LOT 42 OF OAK MEADOW SUBDIVISION, LOCATED IN THE NORTHEAST 1/4 OF SECTION 29, T2N,R16E, WALWORTH COUNTY, WISCONSIN.

SCALE - 1"=40'

LEGEND
- ⌀ - IRON PIPE FOUND
- ● - IRON ROD FOUND
- ( )- RECORDED AS

I, DAVID F. ABELL, DO HEREBY CERTIFY THAT I HAVE SURVEYED THE PROPERTY HEREON DESCRIBED ACCORDING TO THE OFFICIAL RECORDS AND THAT THE PLAT HEREON IS A CORRECT REPRESENTATION OF THE PROPERTY LINES TO THE BEST OF MY KNOWLEDGE AND BELIEF.

David F. Abell
DAVID F. ABELL
WISCONSIN REGISTERED LAND SURVEYOR, S-1596

December 22, 1986
DATE JOB NUMBER - 86085

NOTE: THIS IS NOT A CERTIFIED COPY UNLESS SEALED.

FORM S-43

216-891A