
ABELL
SURVEYING & MAPPING
DELAVAN, WISCONSIN 53115
414-728-6737

RECEIVED
FEB 10 1987

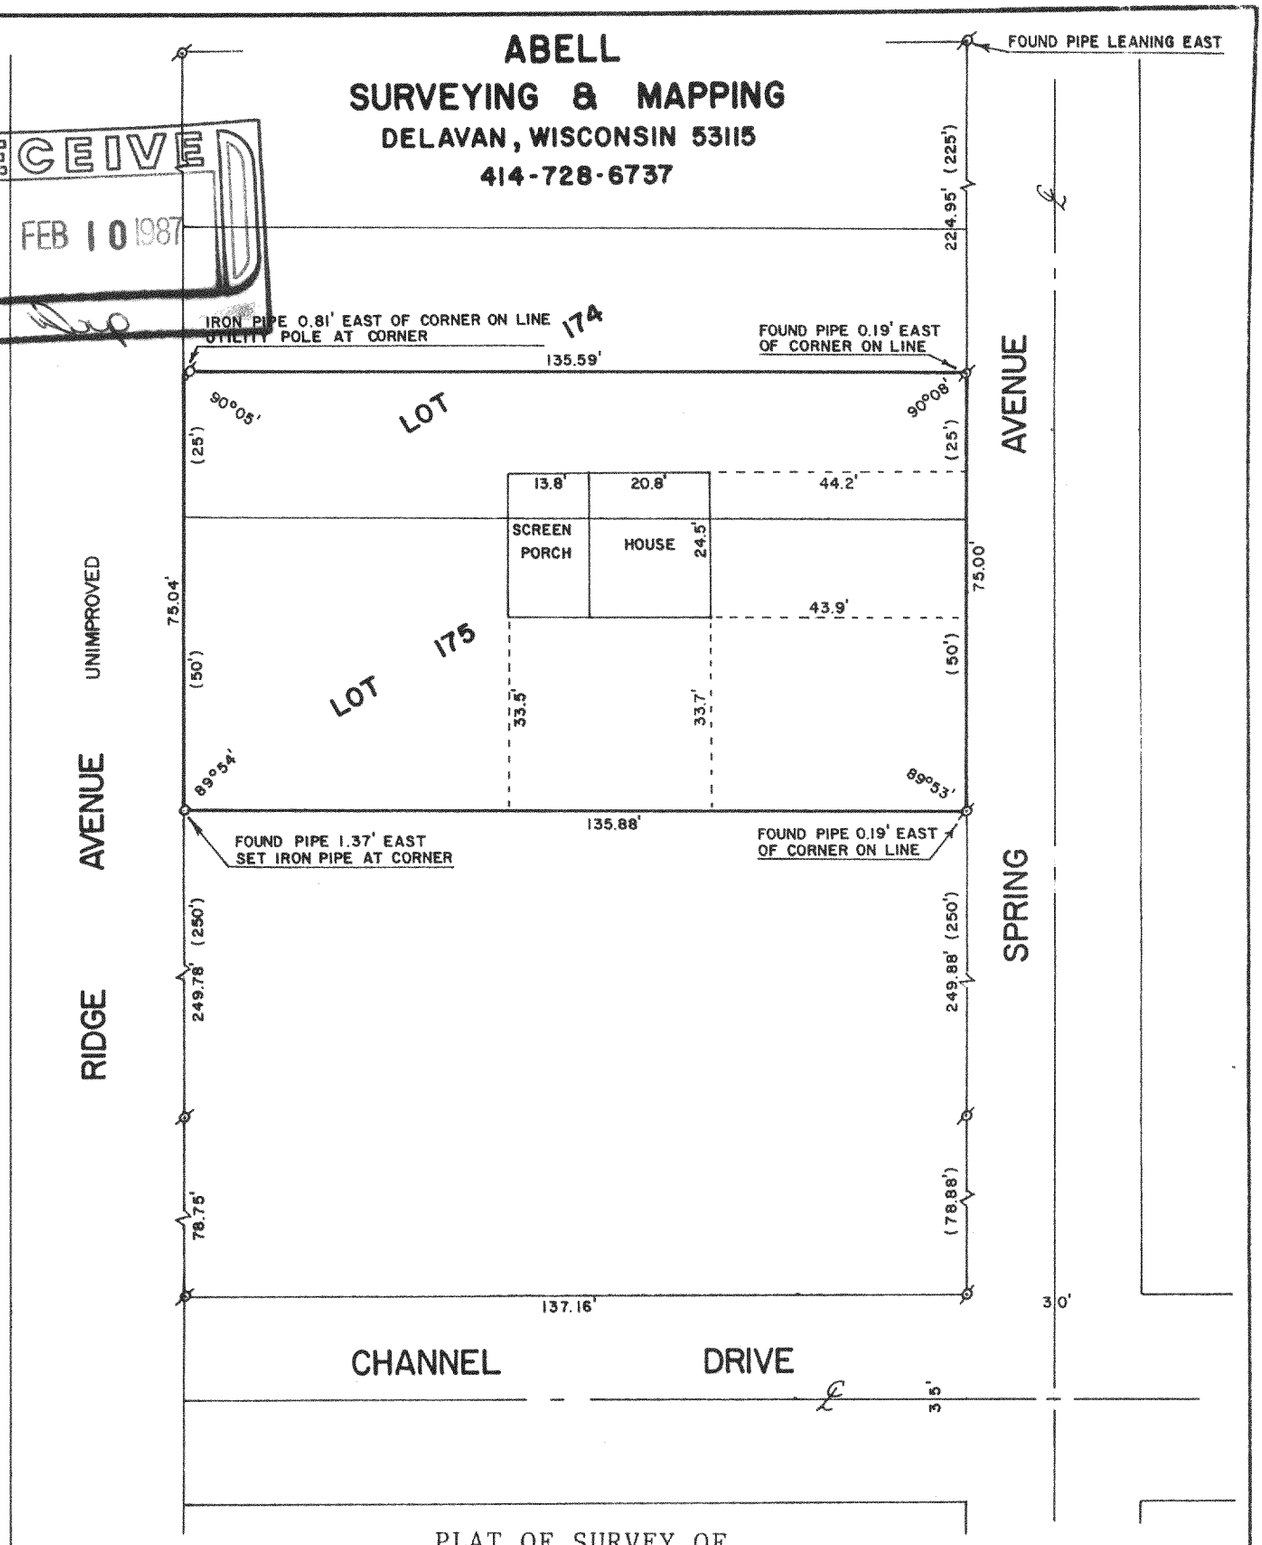

PLAT OF SURVEY OF

LOT 175 AND THE SOUTH 1/2 OF LOT 174, LAKE DELAVAN HIGHLANDS, LOCATED IN THE SOUTH 1/2 OF THE SOUTHEAST 1/4 OF SECTION 31, T2N,R16E, WALWORTH COUNTY, WISCONSIN.

ORDERED BY: KEEFE REAL ESTATE
704 W. MAIN ST.
LAKE GENEVA, WI 53147

SCALE - 1"=30'

LEGEND

ø - IRON PIPE FOUND
o - IRON PIPE SET
( )- RECORDED AS

I, DAVID F. ABELL, DO HEREBY CERTIFY THAT I HAVE SURVEYED THE PROPERTY HEREON DESCRIBED ACCORDING TO THE OFFICIAL RECORDS AND THAT THE PLAT HEREON IS A CORRECT REPRESENTATION OF THE PROPERTY LINES TO THE BEST OF MY KNOWLEDGE AND BELIEF.

David F. Abell
DAVID F. ABELL
WISCONSIN REGISTERED LAND SURVEYOR, S-1596

January 28, 1987
DATE JOB NUMBER - 87006

NOTE: THIS IS NOT A CERTIFIED COPY UNLESS SEALED.

FLAD-136A

216-894A