
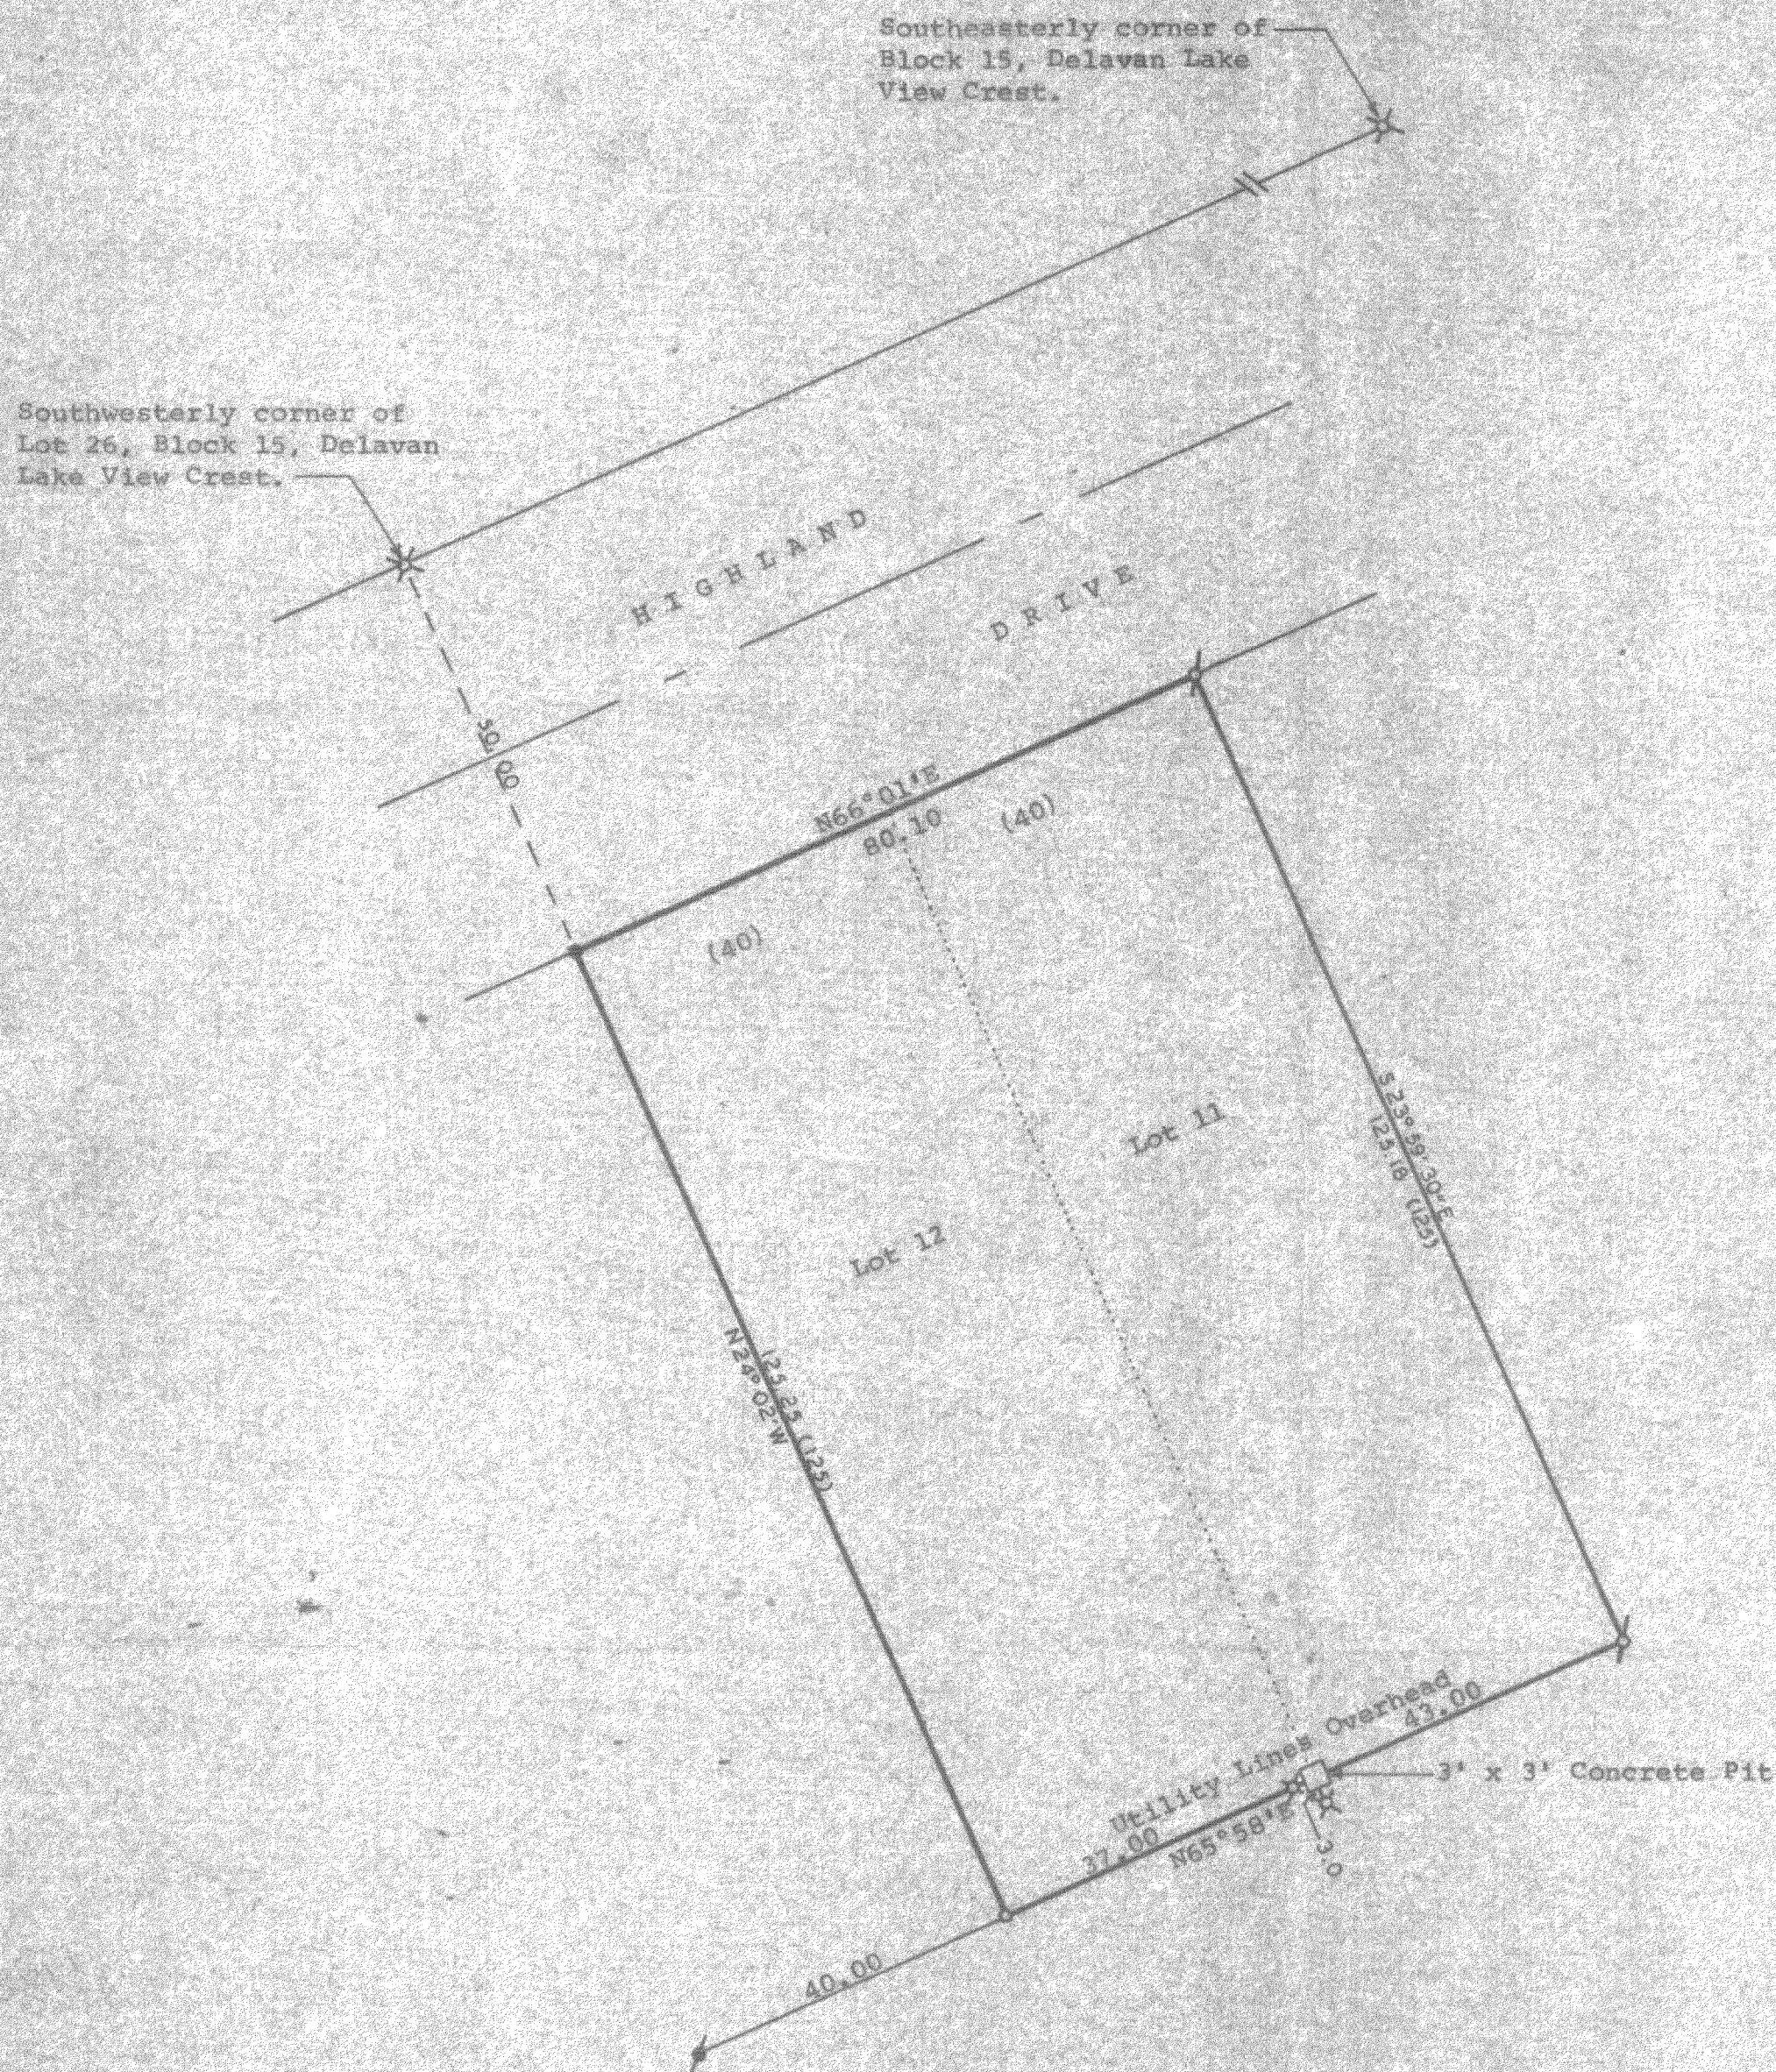


DUNHAM SURVEYING, S.C.
SURVEYING & SUBDIVIDING
DELAVER, WISCONSIN 53115

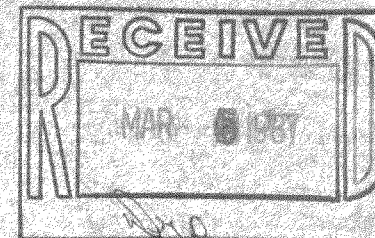

Scale - 1" = 20'

⌀ = 5/8" Dia. Iron Rod Found

⌀ = 1" Dia. Iron Pipe Found

X = 3/4" Dia. Iron Pipe Found

• = Iron Pipe Set 1" x 24"

o = Iron Pipe Set 3/4" x 24"

(x.x) = Recorded Distance

Bearings referenced to the southeasterly line of lots 11 & 12. Assumed bearing of N65°58'E from previously surveys used.

Survey ordered by: Keefe Real Estate, Inc.
Better Homes & Gardens
704 W. Main Street
Lake Geneva, Wisconsin
53147

STATE OF WISCONSIN)
COUNTY OF WALWORTH)

I, George T. Dunham, Surveyor, certify that I have surveyed the property described as follows.

Lots 11 and 12, Block 20 of Delavan Lake View Crest, a subdivision located in Section 31, T 2 N, R 16 E, Walworth County, Wisconsin.

and that the map shown hereon is a correct representation thereof and shows the size and location of the property, its exterior boundaries, the location of all visible structures and dimensions of all principal buildings thereon, boundary fences, apparent easements, roadways and visible encroachments, if any, and that I have surveyed the property hereon described, according to the official records, to the best of my knowledge and belief.

November 24, 1986

George T. Dunham
George T. Dunham, Surveyor

