
RECEIVED
MAY 26 1987
YMS

ABELL
SURVEYING & MAPPING
DELAVAN, WISCONSIN 53115
414-728-6737

PLAT OF SURVEY OF

LOT 17, BLOCK 1, DELMAR SUBDIVISION, T2N,R16E,
WALWORTH COUNTY, WISCONSIN.

ORDERED BY: ANCHOR SAVINGS & LOAN
500 E. WALWORTH AVE.
DELAVAN, WI 53115

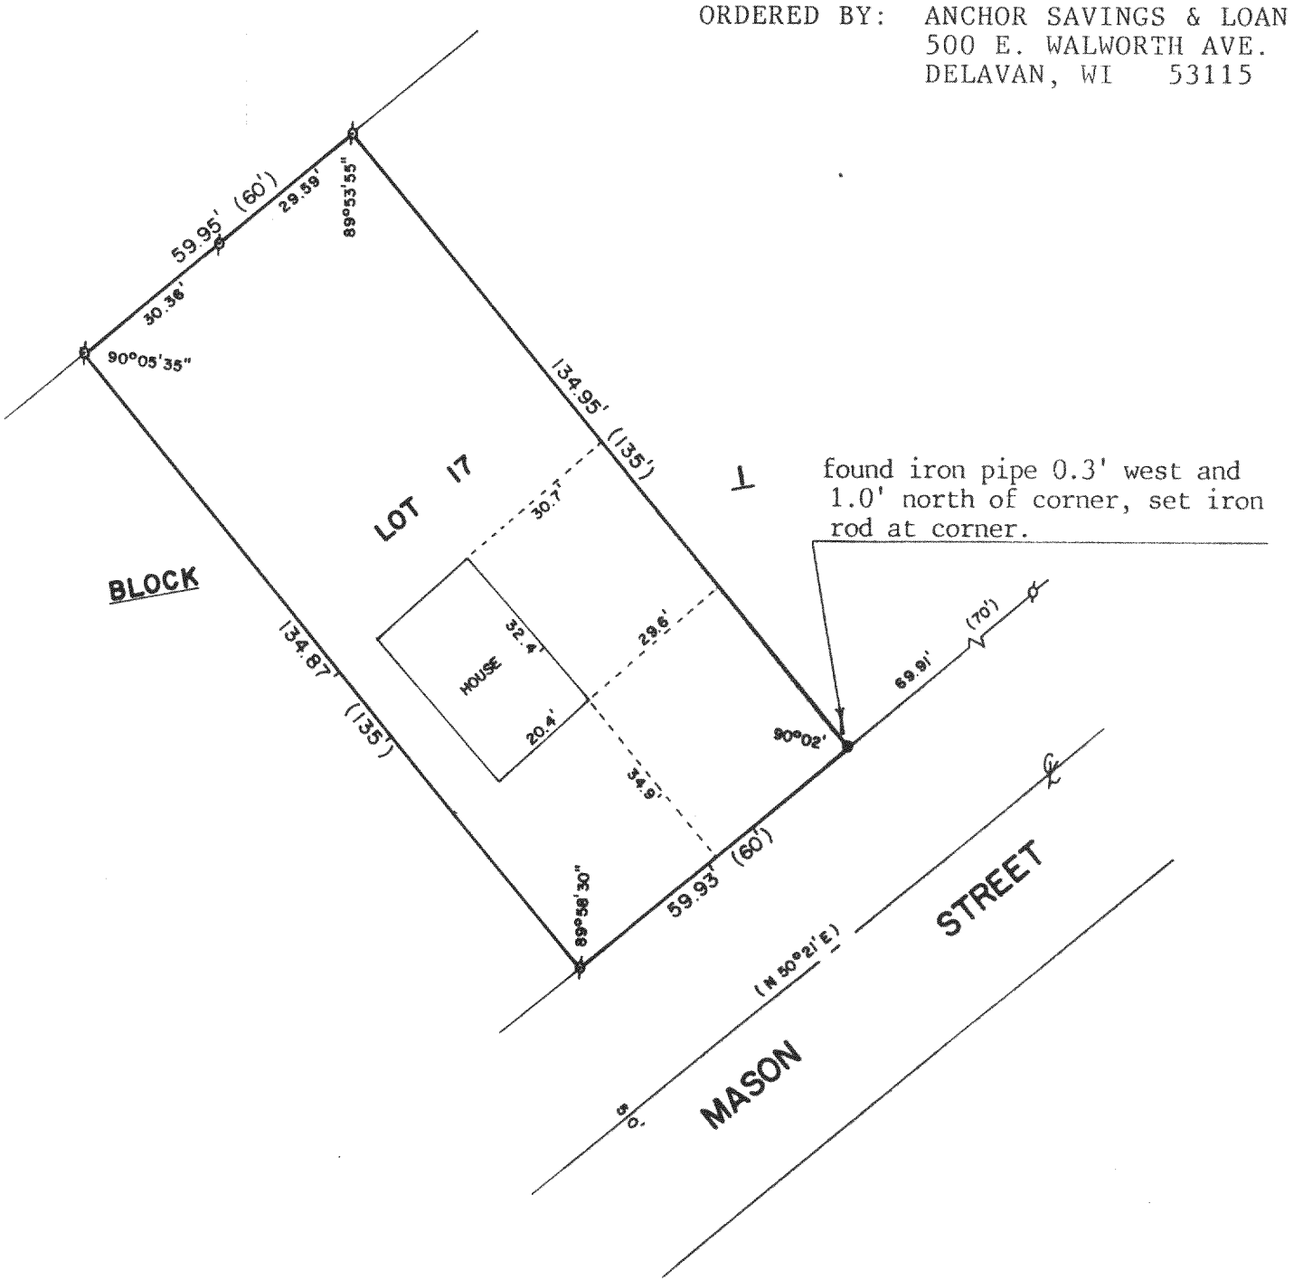

SCALE - 1"=30'

LEGEND
- ⌀ - IRON PIPE FOUND
- • - IRON ROD SET
- ( ) - RECORDED AS

I, DAVID F. ABELL, DO HEREBY CERTIFY THAT I HAVE SURVEYED THE PROPERTY HEREON DESCRIBED ACCORDING TO THE OFFICIAL RECORDS AND THAT THE PLAT HEREON IS A CORRECT REPRESENTATION OF THE PROPERTY LINES TO THE BEST OF MY KNOWLEDGE AND BELIEF.

David F. Abell
DAVID F. ABELL
WISCONSIN REGISTERED LAND SURVEYOR, S-1596

April 25, 1987
DATE JOB NUMBER - 87043

NOTE: THIS IS NOT A CERTIFIED COPY UNLESS SEALED.

FDM-4C

216-920