
ABELL
SURVEYING & MAPPING
DELAVAN, WISCONSIN 53115
414-728-6737

RECEIVED
NOV 25 19[illegible]

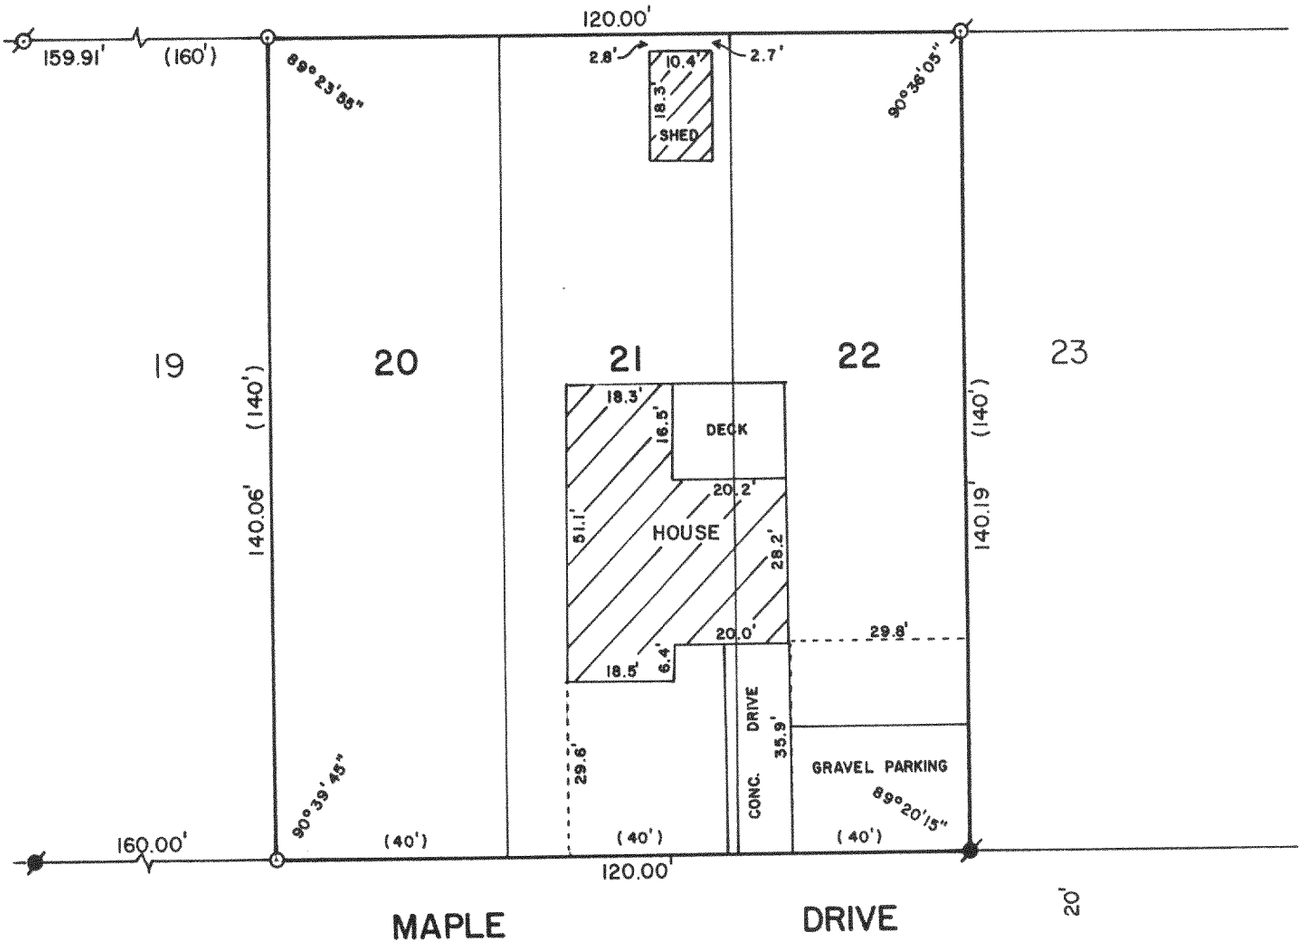

PLAT OF SURVEY OF

LOTS 20-22 OF KRUMHAAR'S ADDITION TO RAVENSWOOD, TOWN 2 NORTH, RANGE 16 EAST, WALWORTH COUNTY, WISCONSIN.

ORDERED BY: CENTURY 21 - SKANDIA REALTY
312 S. 7th STREET
DELAVAN, WI. 53115

SCALE - 1"=30'

LEGEND

- ⌀ - IRON PIPE FOUND
- ● - IRON ROD FOUND
- o - IRON ROD SET
- ( )- RECORDED AS

I, DAVID F. ABELL, DO HEREBY CERTIFY THAT I HAVE SURVEYED THE PROPERTY HEREON DESCRIBED ACCORDING TO THE OFFICIAL RECORDS AND THAT THE PLAT HEREON IS A CORRECT REPRESENTATION OF THE PROPERTY LINES TO THE BEST OF MY KNOWLEDGE AND BELIEF.

David F. Abell

DAVID F. ABELL
WISCONSIN REGISTERED LAND SURVEYOR, S-1596

November 11, 1987

DATE JOB NUMBER - 87175

NOTE: THIS IS NOT A CERTIFIED COPY UNLESS SEALED.

216-983