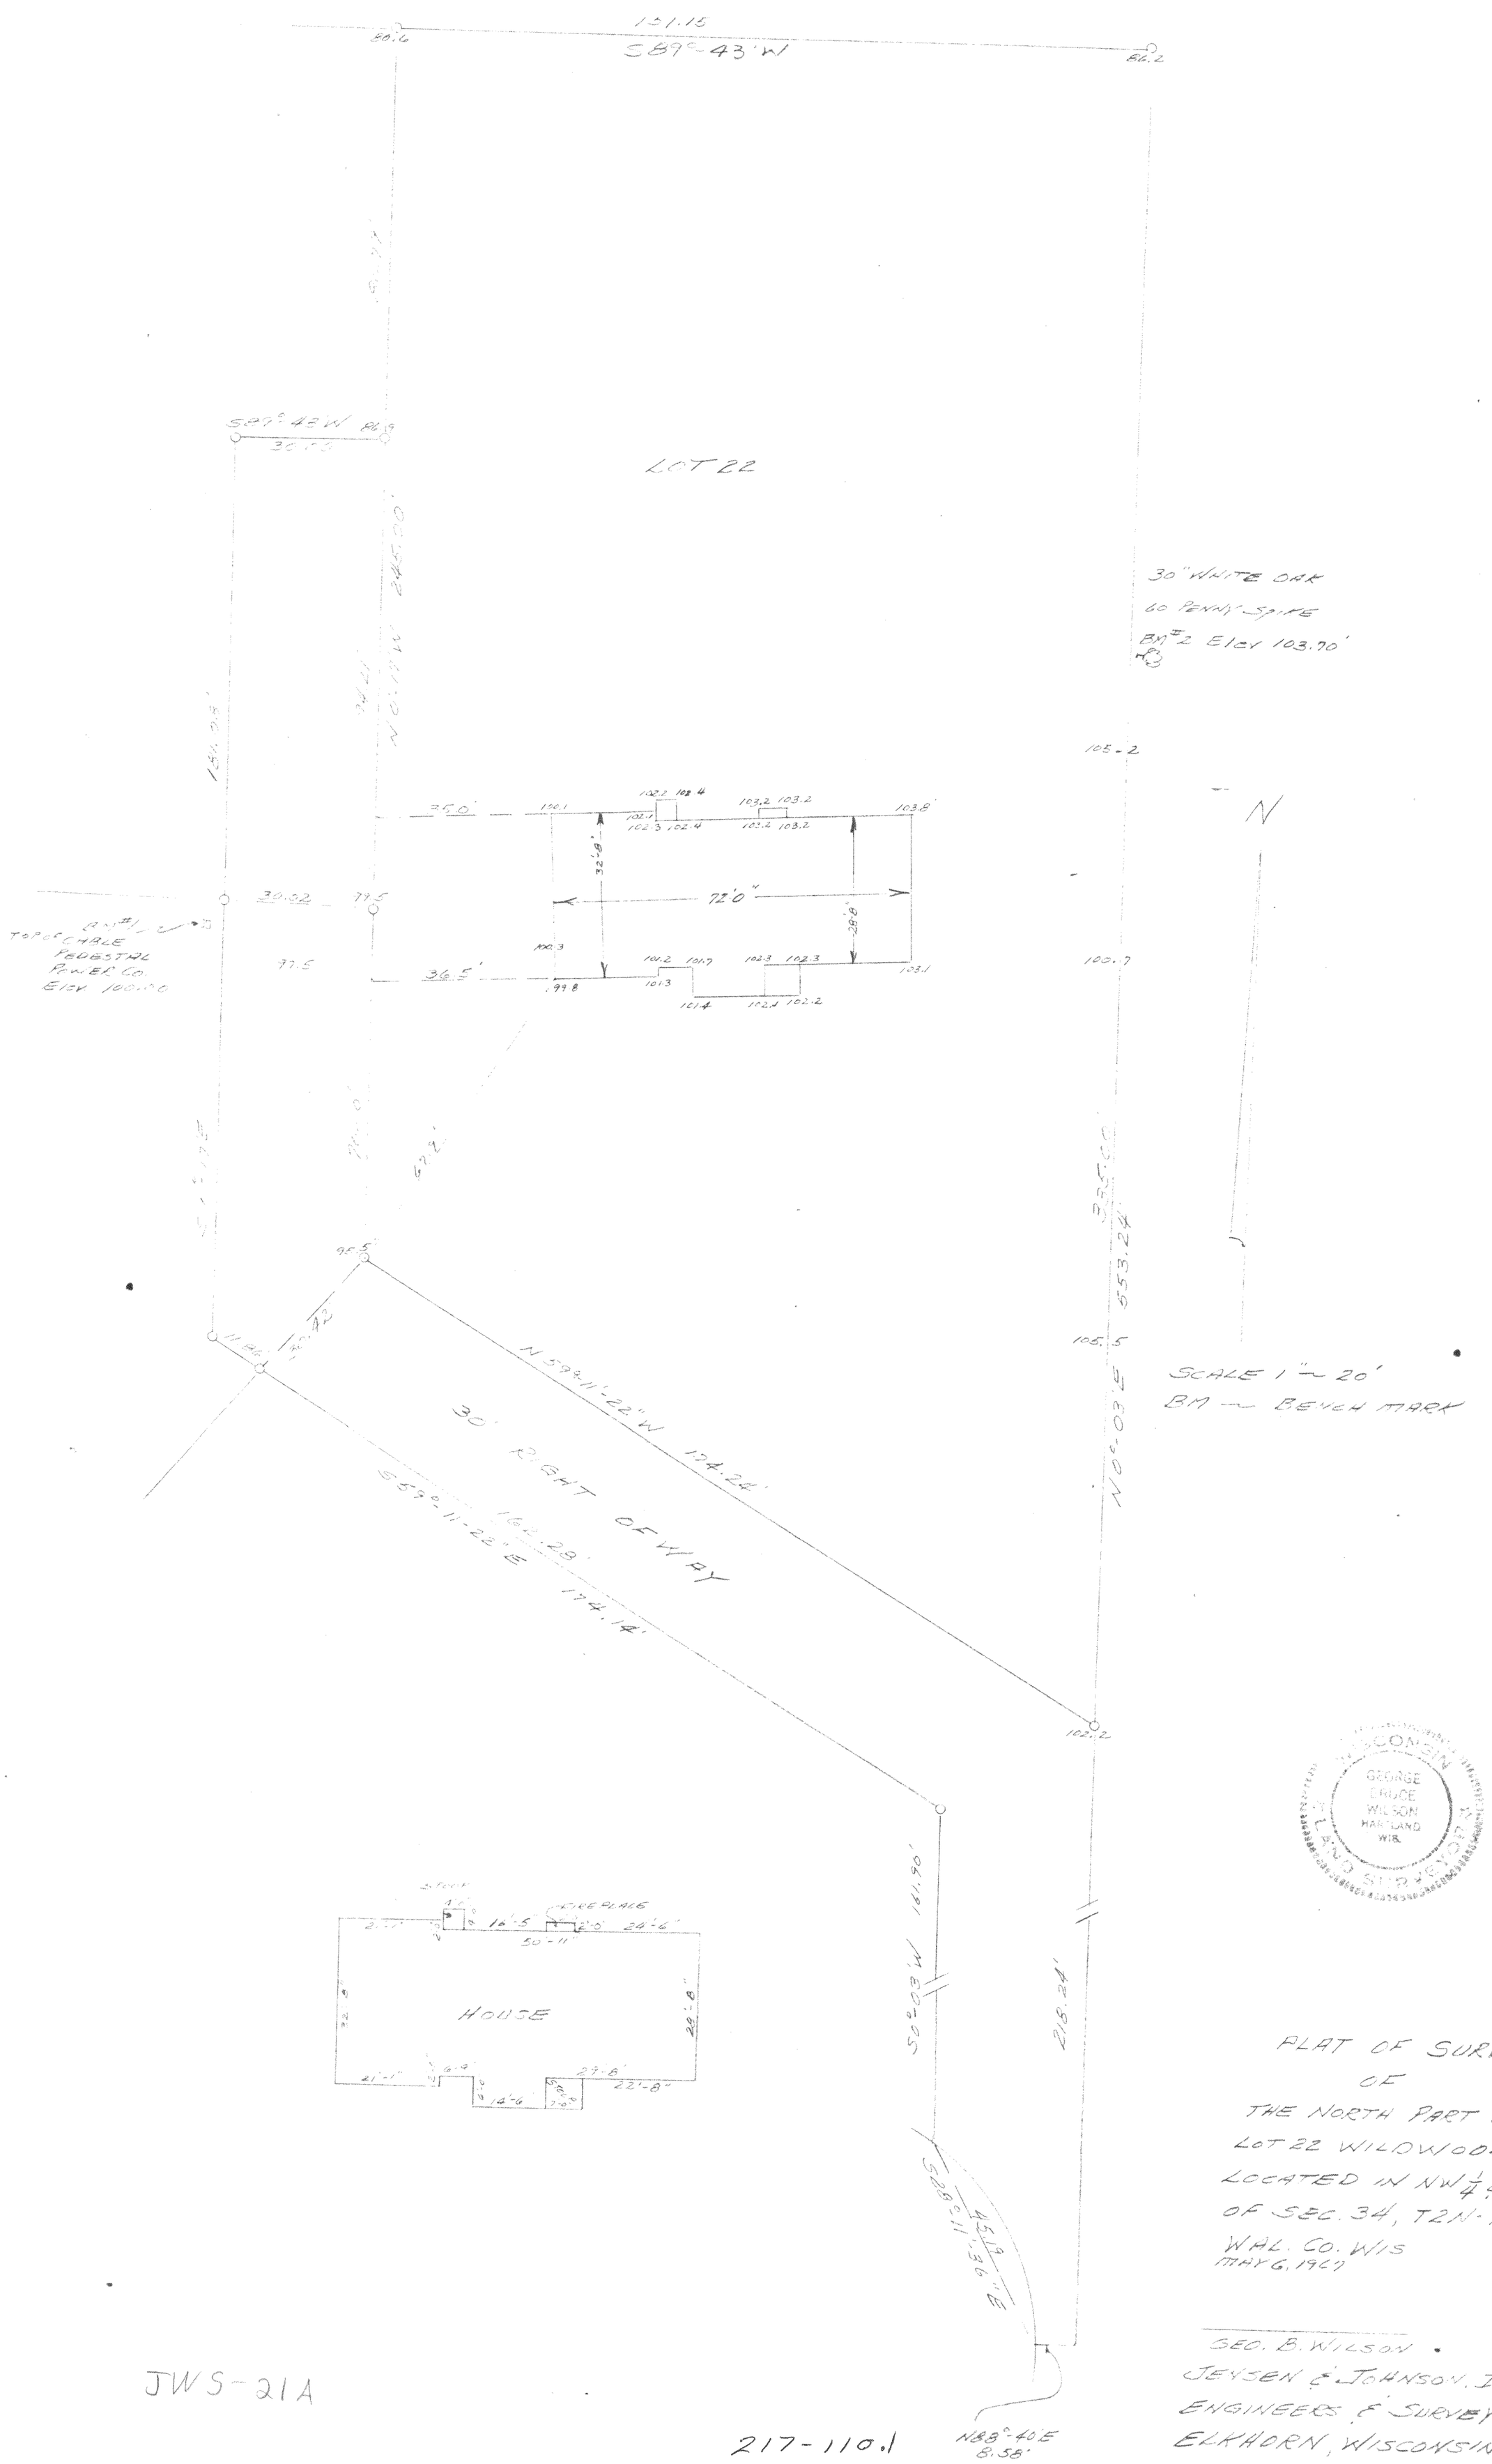
131.15
S89°-43'W
LOT 22
30" WHITE OAK
60 PENNY SPIKE
BM #2 Elev 103.70'
SCALE 1" ~ 20'
BM ~ BENCH MARK
TOP OF CABLE PEDESTAL POWER CO. ELEV 100.00
72'0"
36.5'
N59°11'-22"W 174.24'
30' RIGHT OF WAY
S59°-11-22"E 174.14'
N00°-03'E 553.2
S00°03'W 161.90'
218.24'
S88°11'36"E
N88°-40'E 8.58'
HOUSE
FIRE PLACE
STOOP
50'-11"
24'-6"
16'-5"
29'-8"
22'-8"
14'-6"
21'-1"
PLAT OF SURVEY
OF
THE NORTH PART OF
LOT 22 WILDWOOD SUBD.
LOCATED IN NW¼ & NE¼
OF SEC. 34, T2N-R17E
WAL. CO. WIS
MAY 6, 1967
GEO. B. WILSON
JENSEN & JOHNSON, INC.
ENGINEERS & SURVEYORS
ELKHORN, WISCONSIN
WISCONSIN
GEORGE BRUCE WILSON
HARTLAND WIS.
LAND SURVEYOR
JWS-21A
217-110.1