
KOLB LAND CONSULTING, INC.

LAND SURVEYING · SUBDIVIDING · LAND PLANNING

929 WILLIAMS STREET LAKE GENEVA, WISCONSIN 53147 414-248-3697

ORDERED BY:
SANDRA BANASZAK
5805 W. ST. PAUL AVE.
MILWAUKEE, WI.53213

NOTE: BEARINGS ARE ASSUMED AS SHOWN ON RECORDED PLAT OF LAKE COMO BEACH.

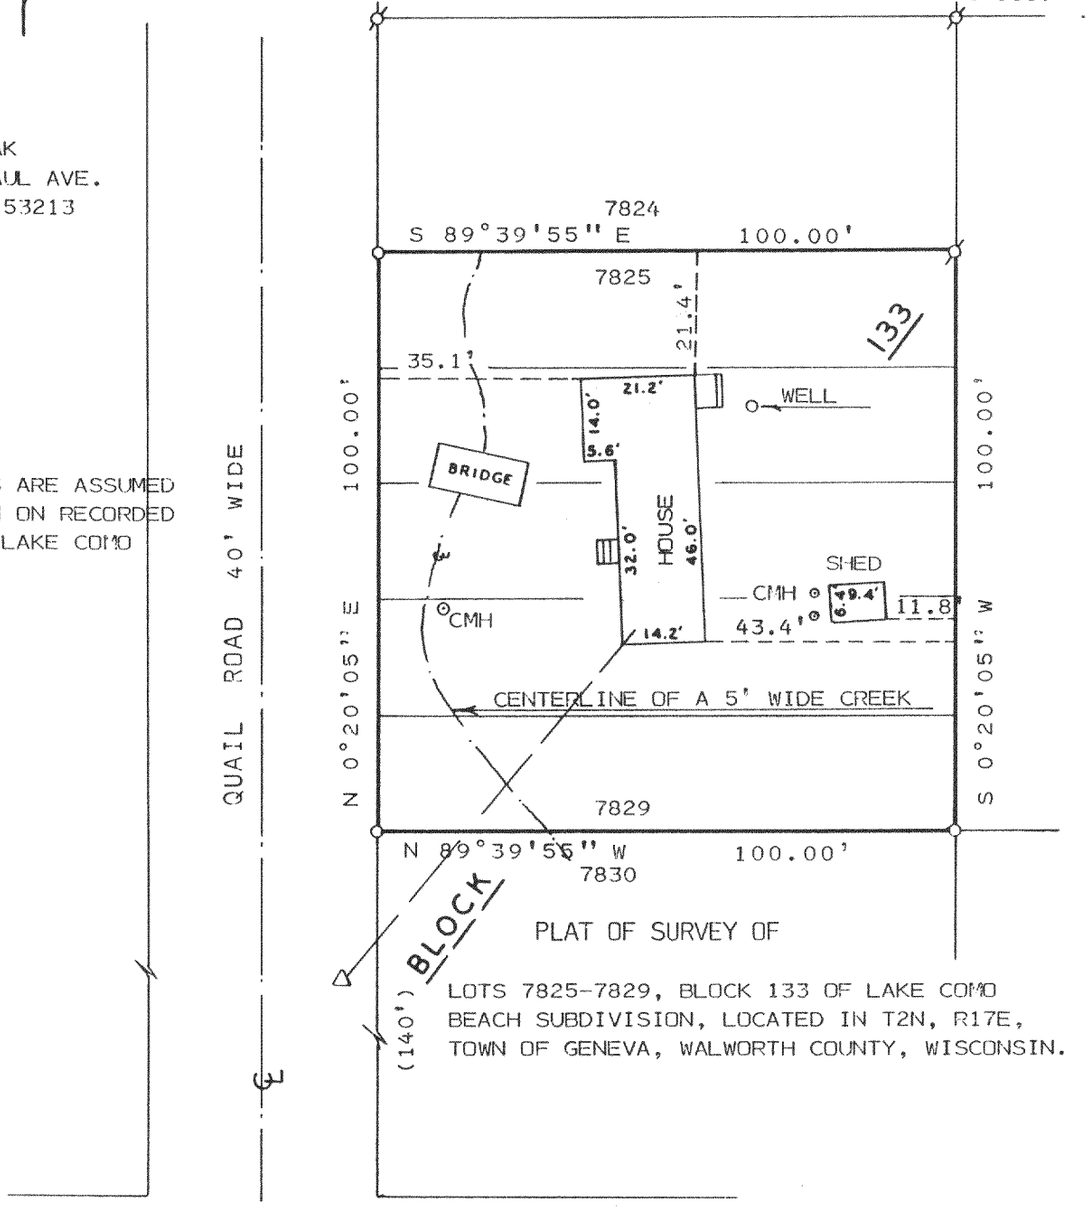

PLAT OF SURVEY OF

LOTS 7825-7829, BLOCK 133 OF LAKE COMO BEACH SUBDIVISION, LOCATED IN T2N, R17E, TOWN OF GENEVA, WALWORTH COUNTY, WISCONSIN.

RECEIVED
JAN 14 1994

SCALE: 1" = 30'

LEGEND

- ø - IRON PIPE FOUND
- o - IRON PIPE SET
- CMH - CONCRETE MANHOLE
- △ - UTILITY POLE
- ——— - OVERHEAD UTILITY LINE
- ( ) - AS RECORDED

I HEREBY CERTIFY THAT I HAVE SURVEYED THE ABOVE DESCRIBED PROPERTY AND THAT THE ABOVE MAP IS A TRUE REPRESENTATION THEREOF AND SHOWS THE SIZE AND LOCATION OF THE PROPERTY, ITS EXTERIOR BOUNDARIES, THE LOCATION OF ALL VISIBLE STRUCTURES AND DIMENSIONS OF ALL PRINCIPAL BUILDINGS THEREON, BOUNDARY FENCES, APPARENT EASEMENTS, ROADWAYS AND VISIBLE ENCROACHMENTS, IF ANY, TO THE BEST OF MY KNOWLEDGE AND BELIEF.
THIS SURVEY IS MADE FOR THE USE OF THE PRESENT OWNERS OF THE PROPERTY, AND ALSO THOSE WHO PURCHASE, MORTGAGE, OR GUARANTEE THE TITLE THERETO WITHIN ONE (1) YEAR FROM DATE HEREOF. THIS SURVEY IS NOT VALID UNLESS THE SURVEYOR'S SIGNATURE IS IN RED.

HAROLD H. KOLB
WISCONSIN REGISTERED LAND SURVEYOR, S-187
DATE NOVEMBER 23, 1992
REVISED
REVISED

JLCB-1665

2-17-LLB-1874

217-1204