G 82 Survey Lots 4508-4522 & 4527-4536 inc
L. H. Yaggart, Como Beach Subdivision
Apr. 21, 1932

Stake at S. E. Cor. of Lot 4522 is closest to S. E. Cor of Bldg

R. G. Steele, Reg C.E.
Bessie M. Palmer, Asst.

See Blue print G-82

Lots 4508 - 4522 Lake Como Beach

217-120-Lk

17 April 21 survey of
Lots 4508 - 4522 & 4527-4536
Block 78, Como Beach Sub.
Request L. H. Jaggart,
A stake with nail in it had been
set at S. W. Cor. of Lot 4522.
Said stake was in gross error.
supposing said lot be 20'X100'
and on the plat it is 20'X95'
This was corrected by the
writer, all east Lots running E & W.
in said block 78 are 95' E & W.
2" iron stks were found as follows
at S.E. Cor. B. 78, S.W. Cor. B. 78
N.E. & N.W. Cor's Block S. of 78
N.W. Cor 78, N.E & S.E Cors. of
B. W. of 78, N.E. of B. S. W. of 78
& N. W. Cor of B.S. of 78 stks had
been pulled and thrown away,
stks were set today by writer
at N.W. Cor. B. S. of B78. at S.W. Cor
Lot 4522, R.W. Cor. Lot 4536 at
S.E. Cor. 4536, N.W. Cor 4527
& N.E. Cor. 4508 all in B. 78
Walnut Road, Daisy Drive are
each 40 ft. Wide. Club House
Road is 50' Wide.
Set stks axe iron pipe

217-120-Sk

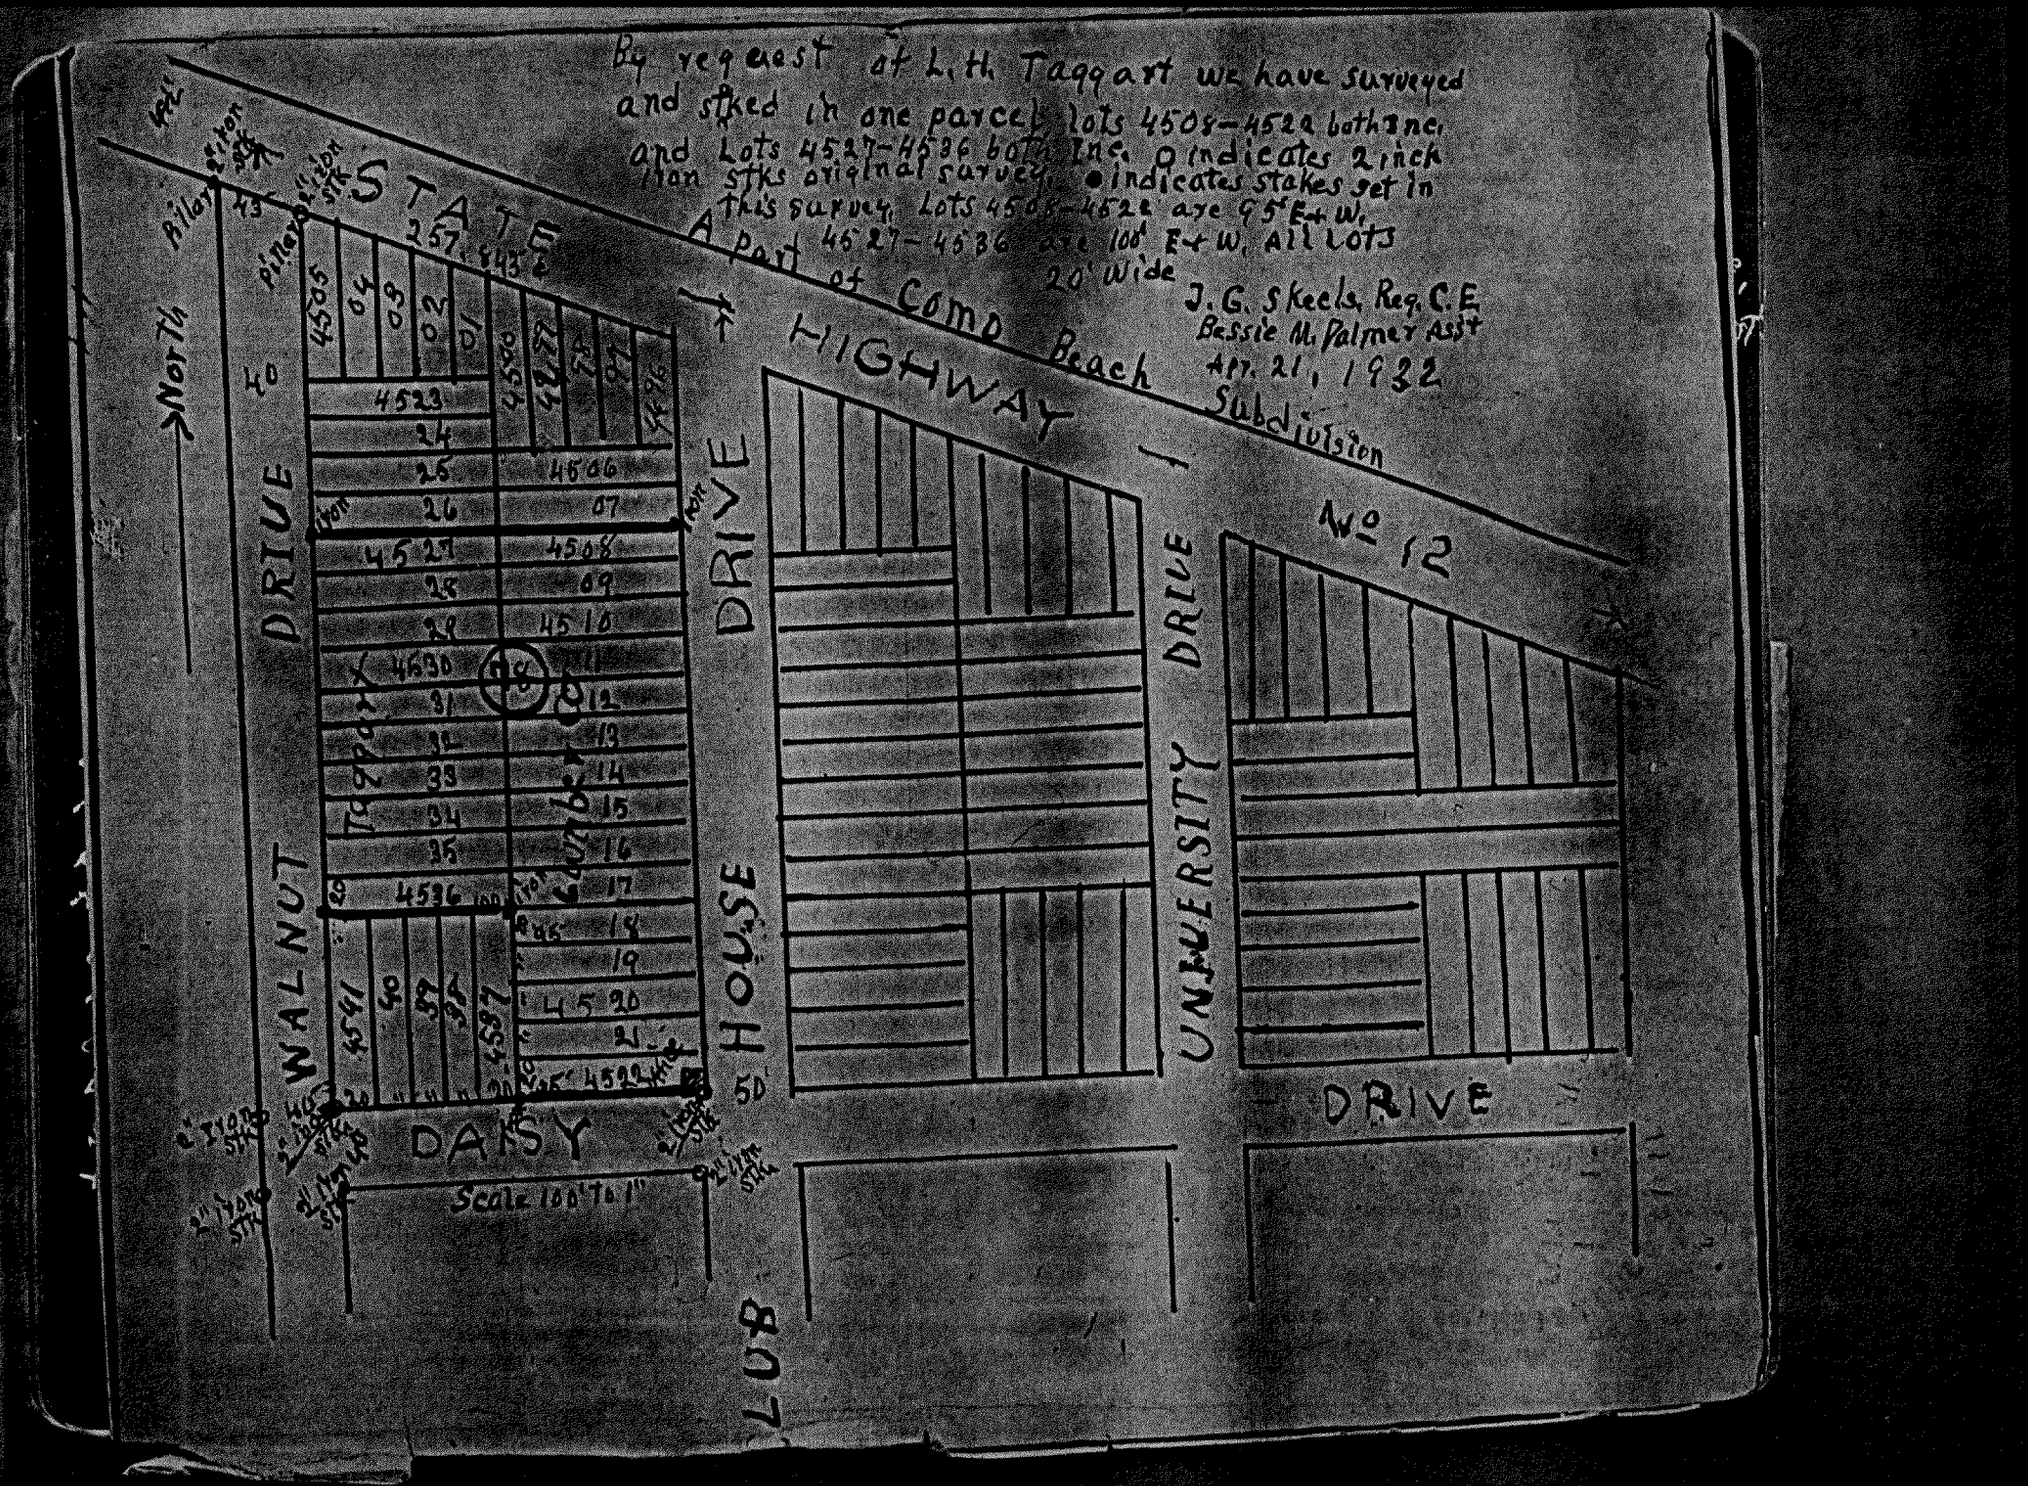
By request of L. H. Taggart we have surveyed and staked in one parcel, lots 4508–4522 both inc. and Lots 4527–4536 both inc. O indicates 2 inch iron stks original survey. ● indicates stakes set in this survey. Lots 4508–4522 are 95' E & W. 4527–4536 are 100' E & W. All lots 20' Wide
J. G. Skeels, Reg. C.E.
Bessie M. Palmer Ass't
Apr. 21, 1932
A part of Como Beach Subdivision No 12
STATE HIGHWAY
DRIVE
WALNUT
DRIVE
HOUSE
DRIVE
UNIVERSITY
DRIVE
DAISY
LUB
North
Scale 100' to 1"
4505
4506
4507
4508
4509
4510
4511
4512
4513
4514
4515
4516
4517
4518
4519
4520
4521
4522
4523
4524
4525
4526
4527
4528
4529
4530
4531
4532
4533
4534
4535
4536
4537
4538
4539
4540
4541
257.4 ft
Pilot station
Pilot station
2" iron stks