
ABELL
SURVEYING & MAPPING
DELAVAN, WISCONSIN 53115
414-728-6737

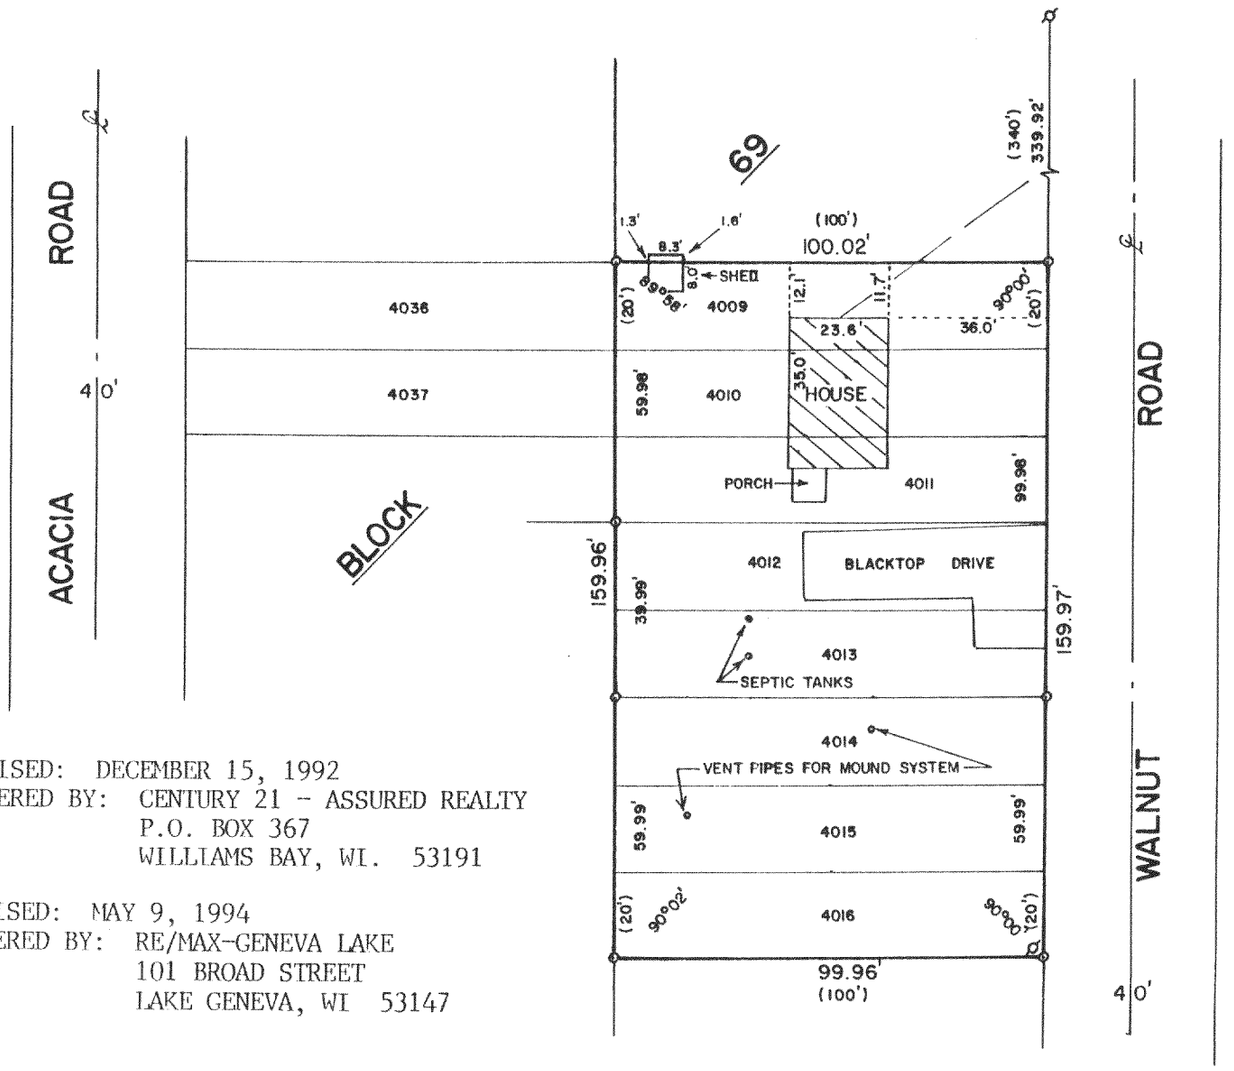

REVISED: DECEMBER 15, 1992
ORDERED BY: CENTURY 21 - ASSURED REALTY
P.O. BOX 367
WILLIAMS BAY, WI. 53191

REVISED: MAY 9, 1994
ORDERED BY: RE/MAX-GENEVA LAKE
101 BROAD STREET
LAKE GENEVA, WI 53147

PLAT OF SURVEY OF

LOTS 4009-4016, BLOCK 69, LAKE COMO BEACH SUBDIVISION, T2N,R17E, WALWORTH COUNTY, WISCONSIN.

ORDERED BY: CENTURY 21 - GENEVA LAKE
503 CENTER ST.
LAKE GENEVA, WI. 53147

RECEIVED
JUN 2 2 1994

SCALE - 1"=40'

LEGEND
⌀ - IRON PIPE FOUND
o - IRON ROD SET, FOUND 12/15/92
( )- RECORDED AS
——— ———- OVERHEAD UTILITY LINES

I HEREBY CERTIFY THAT I HAVE SURVEYED THE ABOVE DESCRIBED PROPERTY AND THAT THE ABOVE MAP IS A TRUE REPRESENTATION THEREOF AND SHOWS THE SIZE AND LOCATION OF THE PROPERTY, ITS EXTERIOR BOUNDARIES, THE LOCATION OF ALL VISIBLE STRUCTURES AND DIMENSIONS OF ALL PRINCIPAL BUILDINGS THEREON, BOUNDARY FENCES, APPARENT EASEMENTS, ROADWAYS AND VISIBLE ENCROACHMENTS, IF ANY, TO THE BEST OF MY KNOWLEDGE AND BELIEF.

THIS SURVEY IS MADE FOR THE USE OF THE PRESENT OWNERS OF THE PROPERTY, AND ALSO THOSE WHO PURCHASE, MORTGAGE, OR GUARANTEE THE TITLE THERETO WITHIN ONE (1) YEAR FROM DATE HEREON.

David F. Abell
DAVID F. ABELL
WISCONSIN REGISTERED LAND SURVEYOR, S-1596

May 11, 1988
DATE JOB NUMBER - 88030

NOTE: THIS IS NOT A CERTIFIED COPY UNLESS SEALED.

JLCB-769

217-1241