
KOLB LAND CONSULTING, INC.

LAND SURVEYING · SUBDIVIDING · LAND PLANNING

929 WILLIAMS STREET LAKE GENEVA, WISCONSIN 53147 414-248-3697

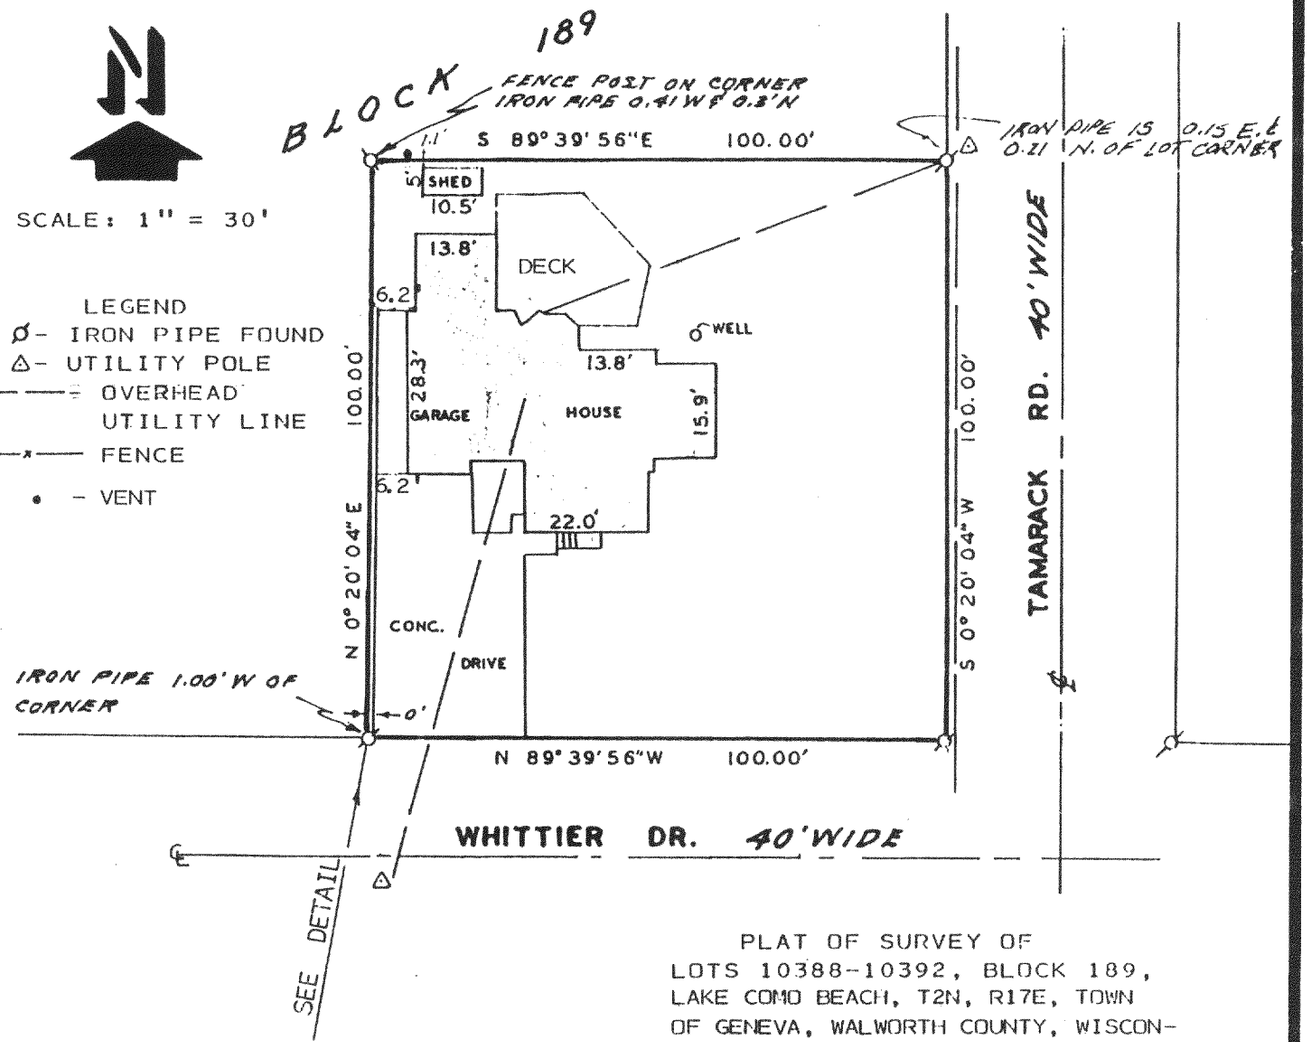

SCALE: 1" = 30'

LEGEND
- ⌀ - IRON PIPE FOUND
- △ - UTILITY POLE
- ——— OVERHEAD UTILITY LINE
- —x— FENCE
- • - VENT


PLAT OF SURVEY OF LOTS 10388-10392, BLOCK 189, LAKE COMO BEACH, T2N, R17E, TOWN OF GENEVA, WALWORTH COUNTY, WISCONSIN.

ORDERED BY: BANK OF BURLINGTON
ATTN. JACK CORBETT
200 S. PINE ST.
BURLINGTON WI. 53105

NOTE: BEARINGS ARE ASSUMED AS SHOWN ON THE RECORDED PLAT OF LAKE COMO BEACH.

NOTE: SURVEY NOY VALID UNLESS SURVEYOR'S SIGNATURE IS IN RED.

NOT TO SCALE

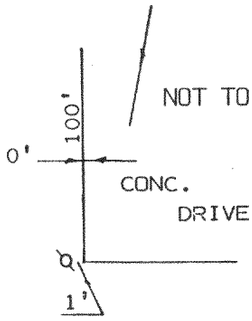

I HEREBY CERTIFY THAT I HAVE SURVEYED THE ABOVE DESCRIBED PROPERTY AND THAT THE ABOVE MAP IS A TRUE REPRESENTATION THEREOF AND SHOWS THE SIZE AND LOCATION OF THE PROPERTY, ITS EXTERIOR BOUNDARIES, THE LOCATION OF ALL VISIBLE STRUCTURES AND DIMENSIONS OF ALL PRINCIPAL BUILDINGS THEREON, BOUNDARY FENCES, APPARENT EASEMENTS, ROADWAYS AND VISIBLE ENCROACHMENTS, IF ANY, TO THE BEST OF MY KNOWLEDGE AND BELIEF. THIS SURVEY IS MADE FOR THE USE OF THE PRESENT OWNERS OF THE PROPERTY, AND ALSO THOSE WHO PURCHASE, MORTGAGE, OR GUARANTEE THE TITLE THERETO WITHIN ONE (1) YEAR FROM DATE HEREOF.



Harold H. Kolb

HAROLD H. KOLB

WISCONSIN REGISTERED LAND SURVEYOR, S-187

DATE JUNE 14, 1985

REVISED MARCH 22, 1994

REVISED _____

RECEIVED
NOV 15 1994

JLCB-0225Ø

2-17- JLCB-2250 217-1264