
DUNHAM SURVEYING, S.C.
SURVEYING & SUBDIVIDING
DELAVAN, WISCONSIN 53115

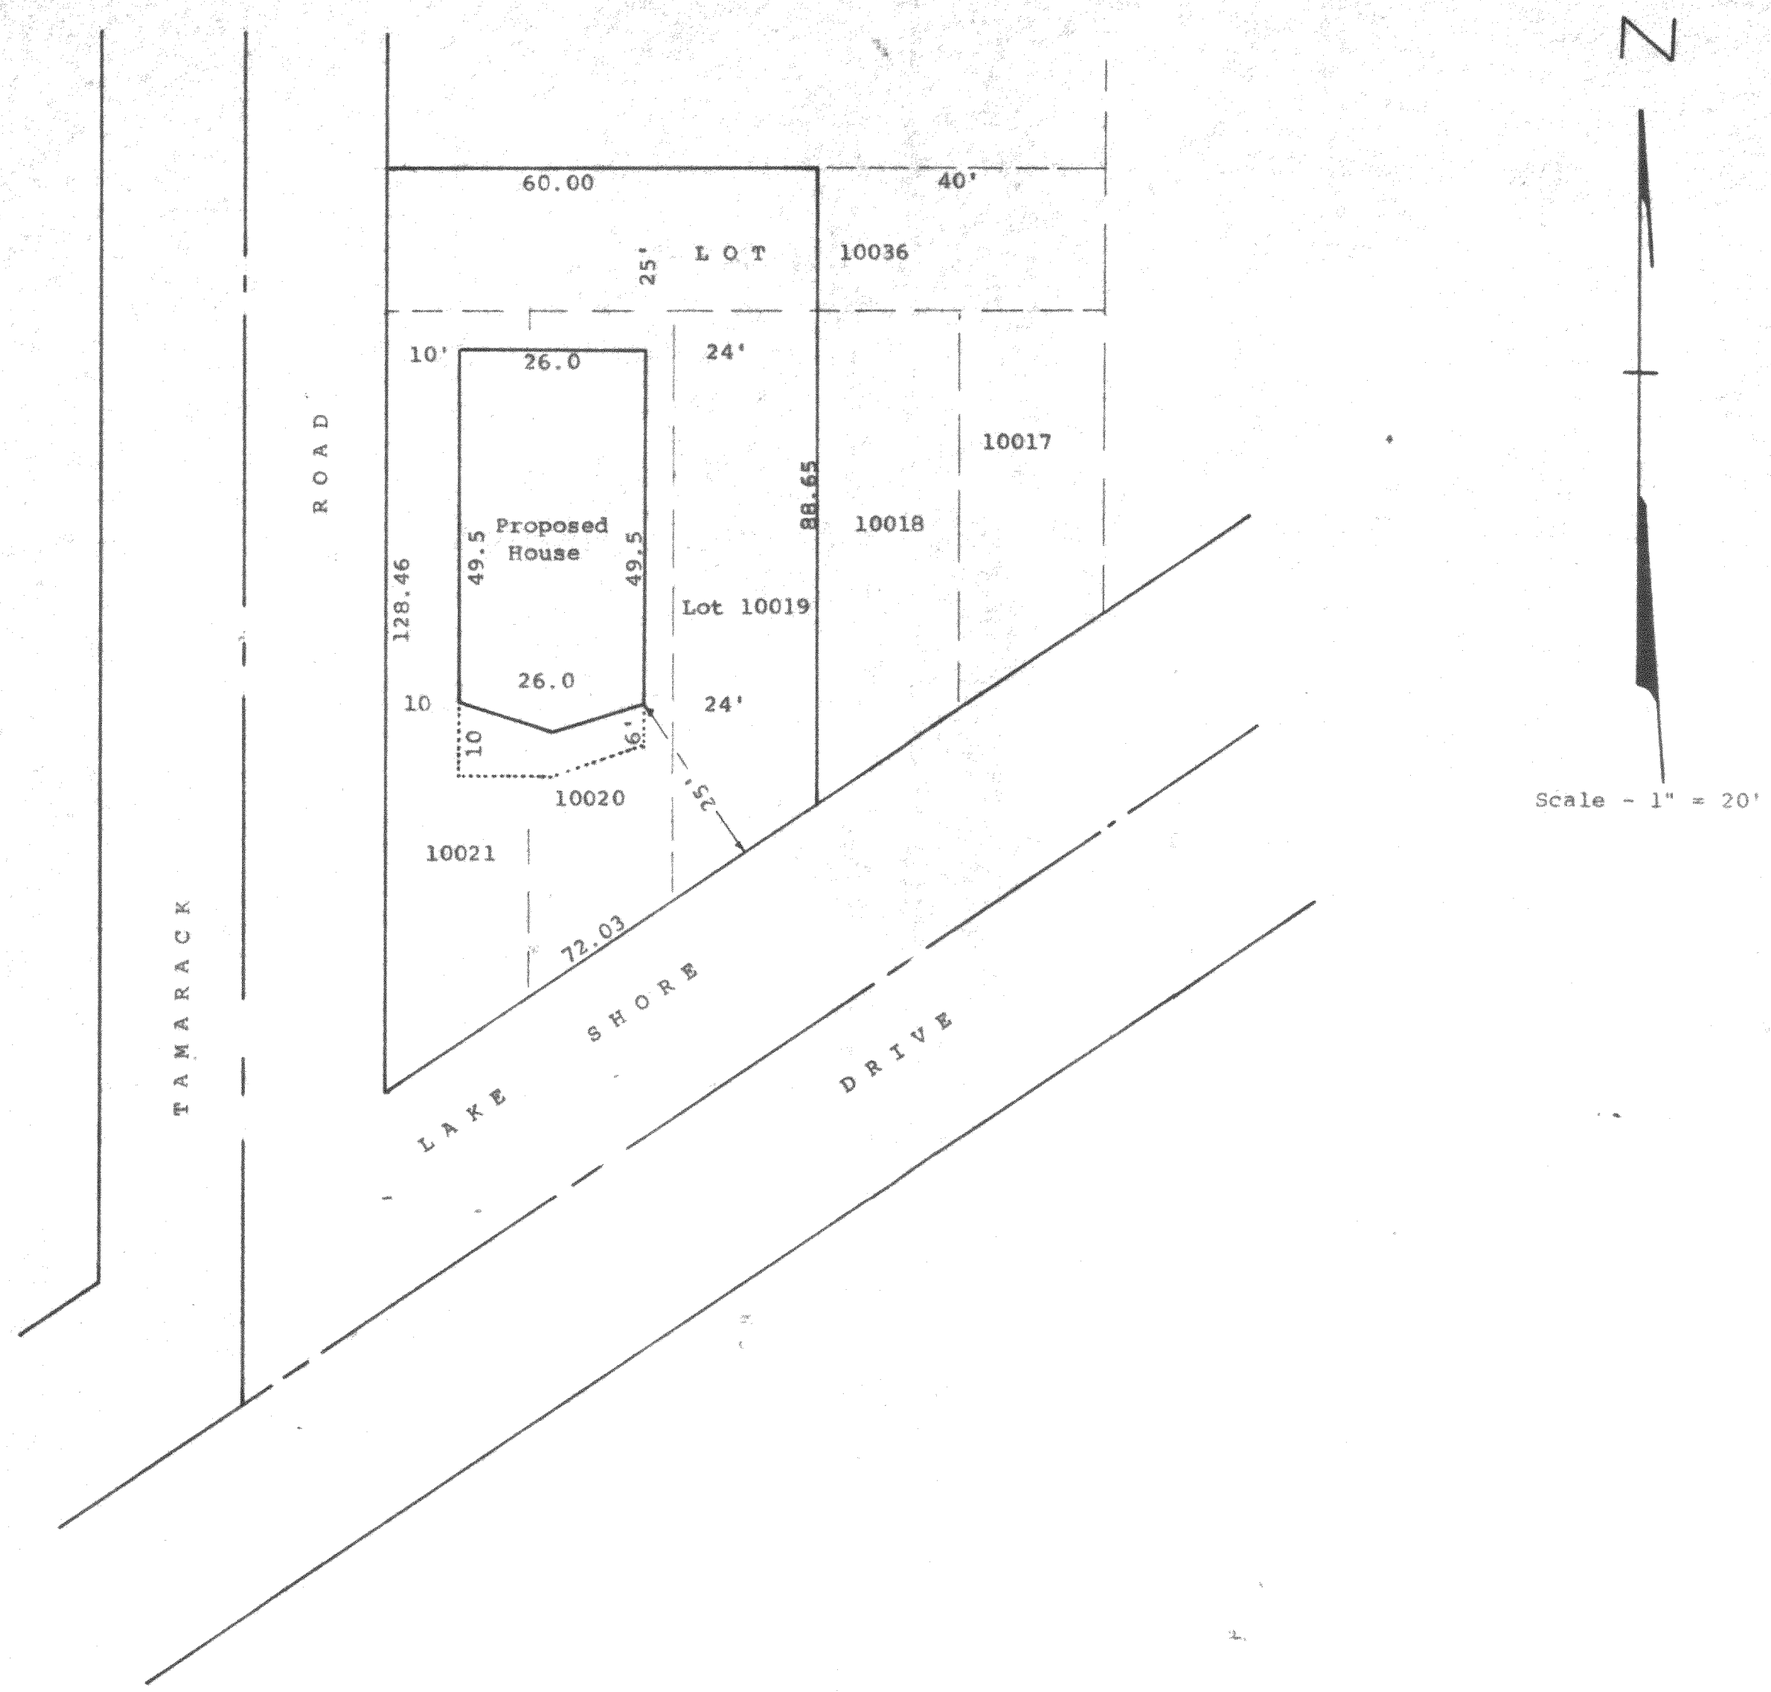

Plat of the proposed location of the proposed house to be built on Lots 10019, 10020, 10021 and the West 60.00 feet of Lot 10036, all in Block 183 of Lake Como Beach, a subdivision located in the Town of Geneva, Walworth County, Wisconsin
March 22, 1994

George T. Dunham, Surveyor

WISCONSIN
GEORGE T. DUNHAM
S-306
DELAVAN WIS.
LAND SURVEYOR


RECEIVED
MAR 24 1995

GMB 1020

DUNHAM SURVEYING, S.C.

SURVEYING & SUBDIVIDING

DELAVAN, WISCONSIN 53115

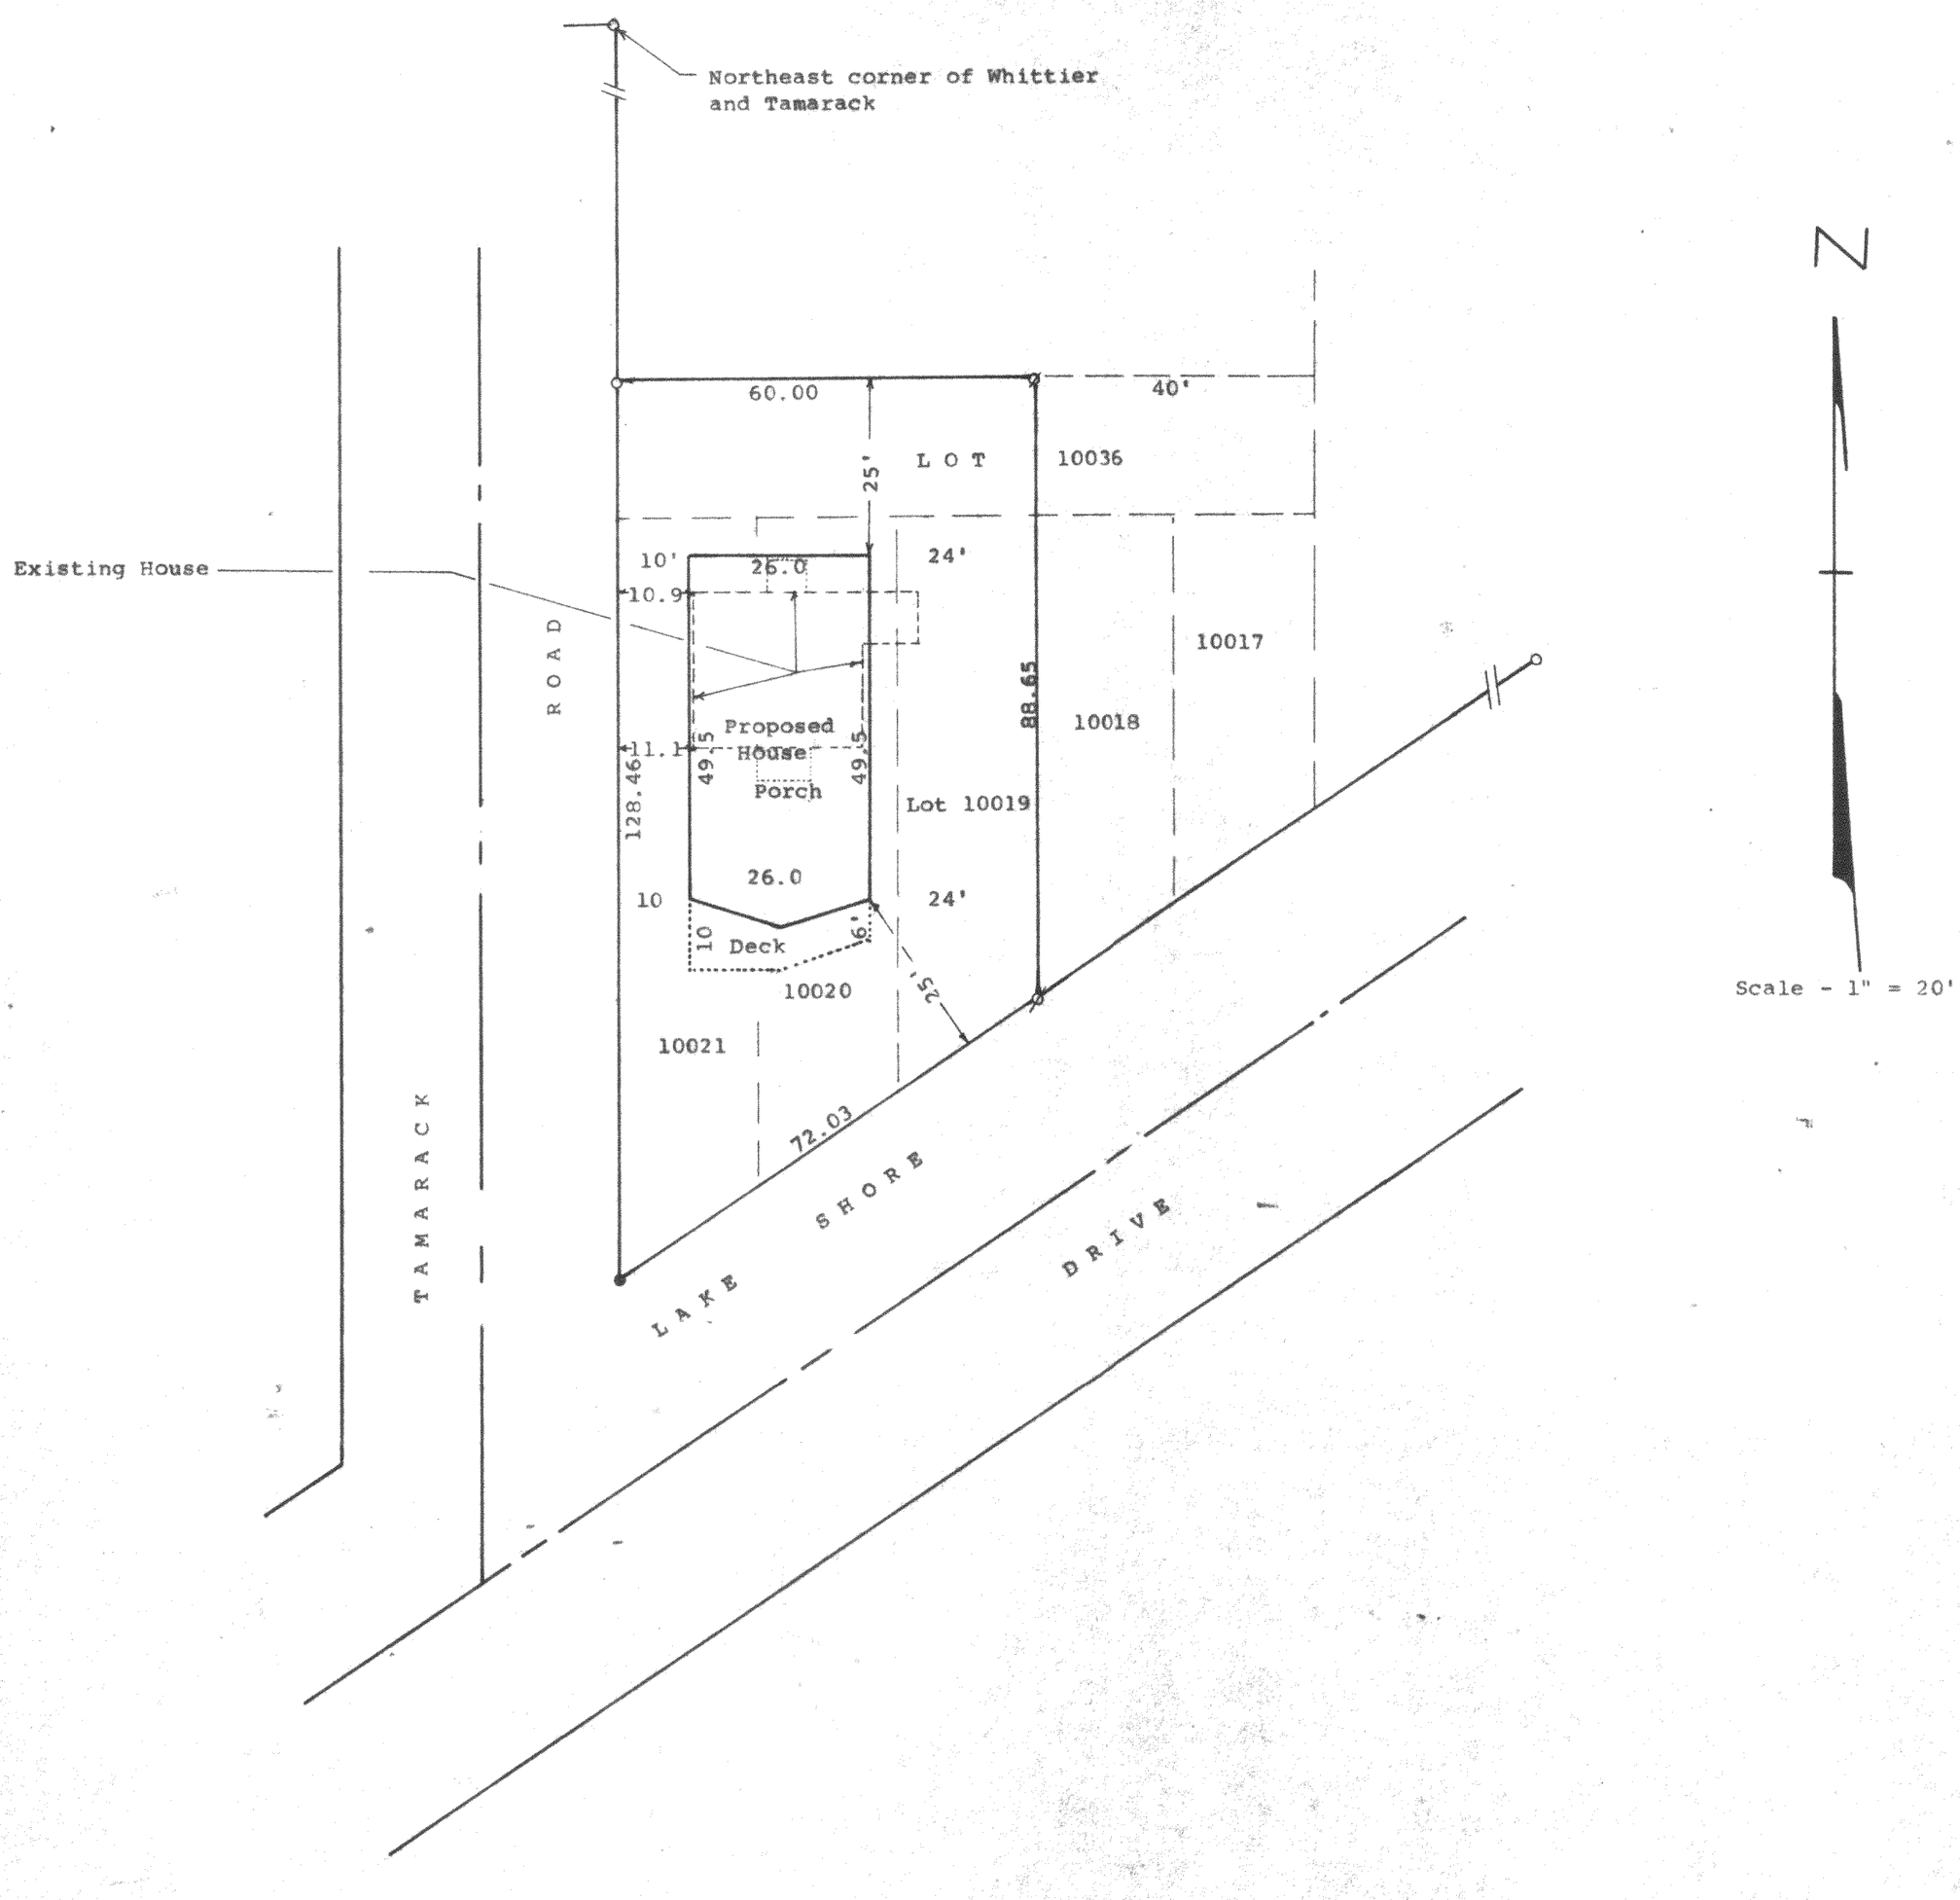

Plat of the proposed location of the proposed house to be built on Lots 10019, 10020, 10021 and the West 60.00 feet of Lot 10036, all in Block 183 of Lake Como Beach, a subdivision located in the Town of Geneva, Walworth County, Wisconsin

March 22, 1994

Revised April 11, 1994 to show Existing House

George T. Dunham, Surveyor

WISCONSIN
GEORGE T. DUNHAM
S-306
DELAVAN WIS.
LAND SURVEYOR

RECEIVED
MAR 24 1995
JC

JLCB-2160

27-1303