
KOLB LAND CONSULTING, INC.

LAND SURVEYING · SUBDIVIDING · LAND PLANNING

929 WILLIAMS STREET LAKE GENEVA, WISCONSIN 53147 414 248-3697

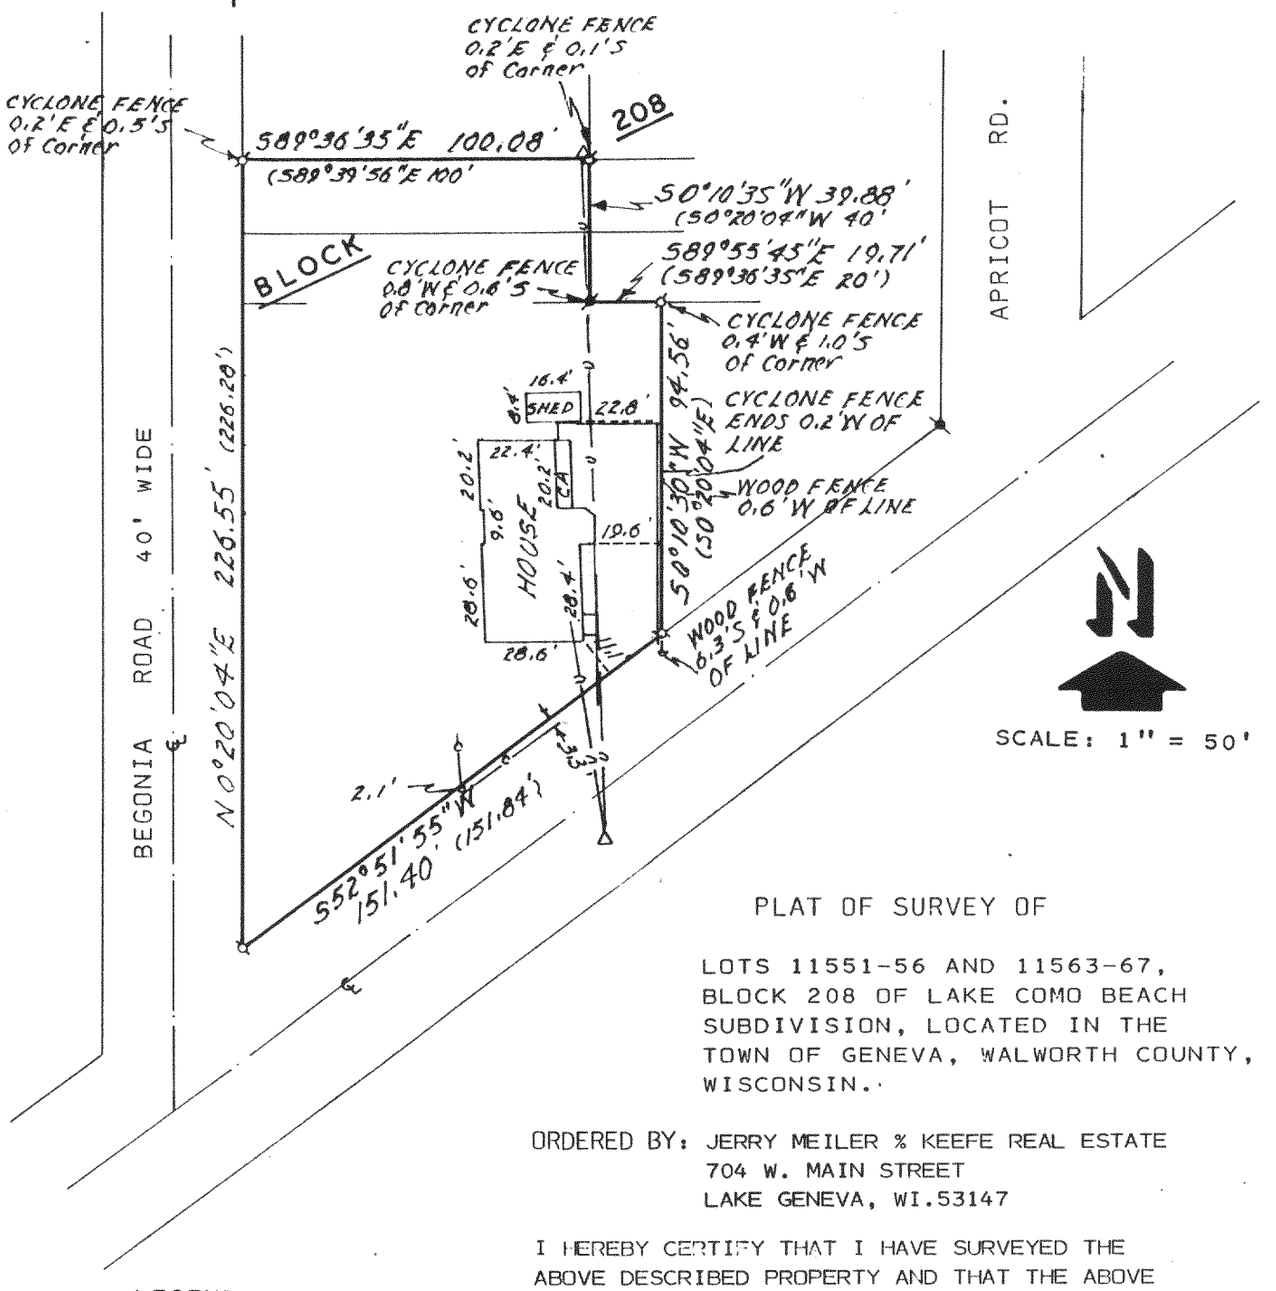

SCALE: 1" = 50'

PLAT OF SURVEY OF

LOTS 11551-56 AND 11563-67, BLOCK 208 OF LAKE COMO BEACH SUBDIVISION, LOCATED IN THE TOWN OF GENEVA, WALWORTH COUNTY, WISCONSIN.

ORDERED BY: JERRY MEILER % KEEFE REAL ESTATE
704 W. MAIN STREET
LAKE GENEVA, WI.53147

I HEREBY CERTIFY THAT I HAVE SURVEYED THE ABOVE DESCRIBED PROPERTY AND THAT THE ABOVE MAP IS A TRUE REPRESENTATION THEREOF AND SHOWS THE SIZE AND LOCATION OF THE PROPERTY, ITS EXTERIOR BOUNDARIES, THE LOCATION OF ALL VISIBLE STRUCTURES AND DIMENSIONS OF ALL PRINCIPAL BUILDINGS THEREON, BOUNDARY FENCES, APPARENT EASEMENTS, ROADWAYS AND VISIBLE ENCROACHMENTS, IF ANY, TO THE BEST OF MY KNOWLEDGE AND BELIEF.
THIS SURVEY IS MADE FOR THE USE OF THE PRESENT OWNERS OF THE PROPERTY AND ALSO THOSE WHO PURCHASE, MORTGAGE OR GUARANTEE THE TITLE THERETO WITHIN ONE (1) YEAR FROM DATE HEREOF.
SURVEY NOT VALID UNLESS SURVEYOR'S SIGNATURE IS IN RED.

LEGEND

- ⌀ - IRON PIPE FOUND
- ⌀ - CONC. MONUMENT FOUND
- △ - UTILITY POLE
- —u— - OVERHEAD UTILITY LINE
- CS - CONC. STOOP
- CA - CONC. APRON
- ( ) - AS RECORDED

NOTE: BEARINGS ON THE EAST SIDE OF BEGONIA ROAD ARE ASSUMED AS SHOWN ON THE RECORDED PLAT OF LAKE COMO BEACH.

RECEIVED
MAY 12 1995

HAROLD H. KOLB
WISCONSIN REGISTERED LAND SURVEYOR, S-187
DATE MARCH 23, 1995
REVISED
REVISED

JLCB-2508

217-1321 2-17/259