ABERNATHY and ASSOCIATES
Kenneth B. Abernathy Jr.
Wisconsin Registered Land Surveyor S-1594

Rt. 3, Box 273
Elkhorn, Wisconsin 53121
Phone: (414) 723-4260 (office)
(414) 723-7209 (FAX)

PLAT OF SURVEY

Lot 10916, Lot 10917, and the East 1/2 of Lot 10918 of Block 196 of the Fifth Map of Lake Como Beach Subdivision, located in part of the Northwest 1/4 of Section 28, Town 2 North, Range 17 East, Town of Geneva, County of Walworth, State of Wisconsin.

Ordered by: Myron J. Mathison
RE/MAX Geneva Realty, Ltd.
101 Broad Street, Suite 102
Lake Geneva, Wisconsin
53147

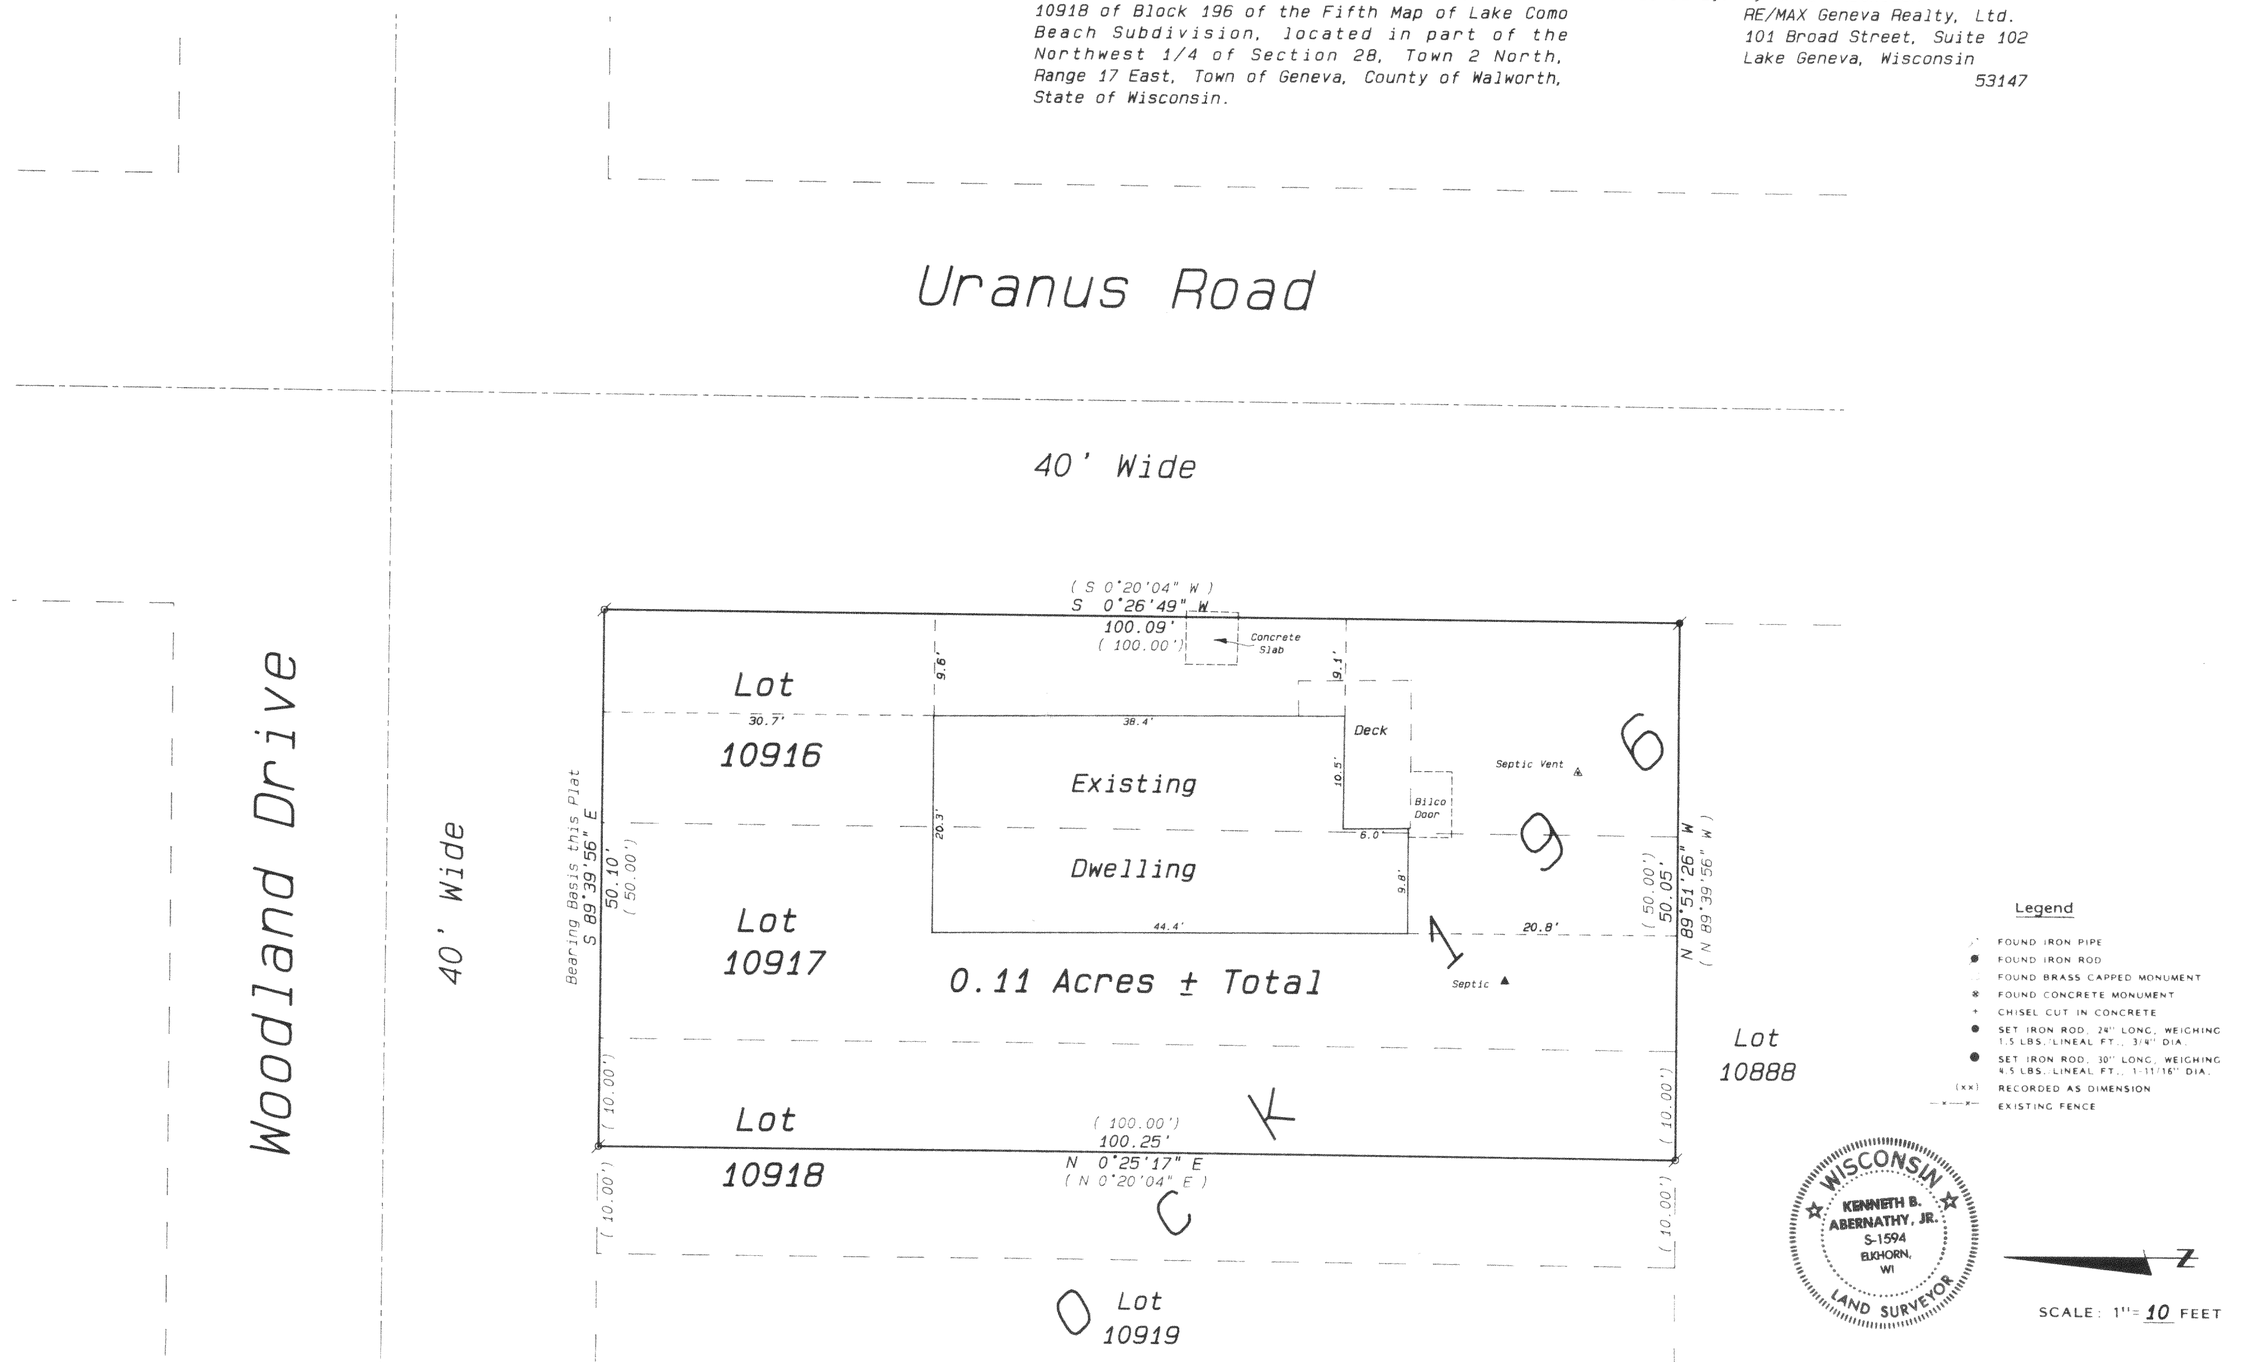

"I hereby certify that the above described property has been surveyed by me or under my direction and that the above map is a true representation thereof and shows the size and location of the property, its exterior boundaries, the location of all visible structures and dimensions of all principal buildings thereon, boundary fences, apparent easements, roadways and visible encroachments, if any."

"This survey is made for the use of the present owners of the property, and also those who purchase, mortgage, or guarantee the title thereto within one year from date hereof."

RECEIVED
JUL 20 1995

KENNETH B. ABERNATHY, JR.
WISCONSIN REGISTERED LAND SURVEYOR,
S-1594

Date: May 16, 1995 Job No. 1995.512

JLCB-2378

217-1347