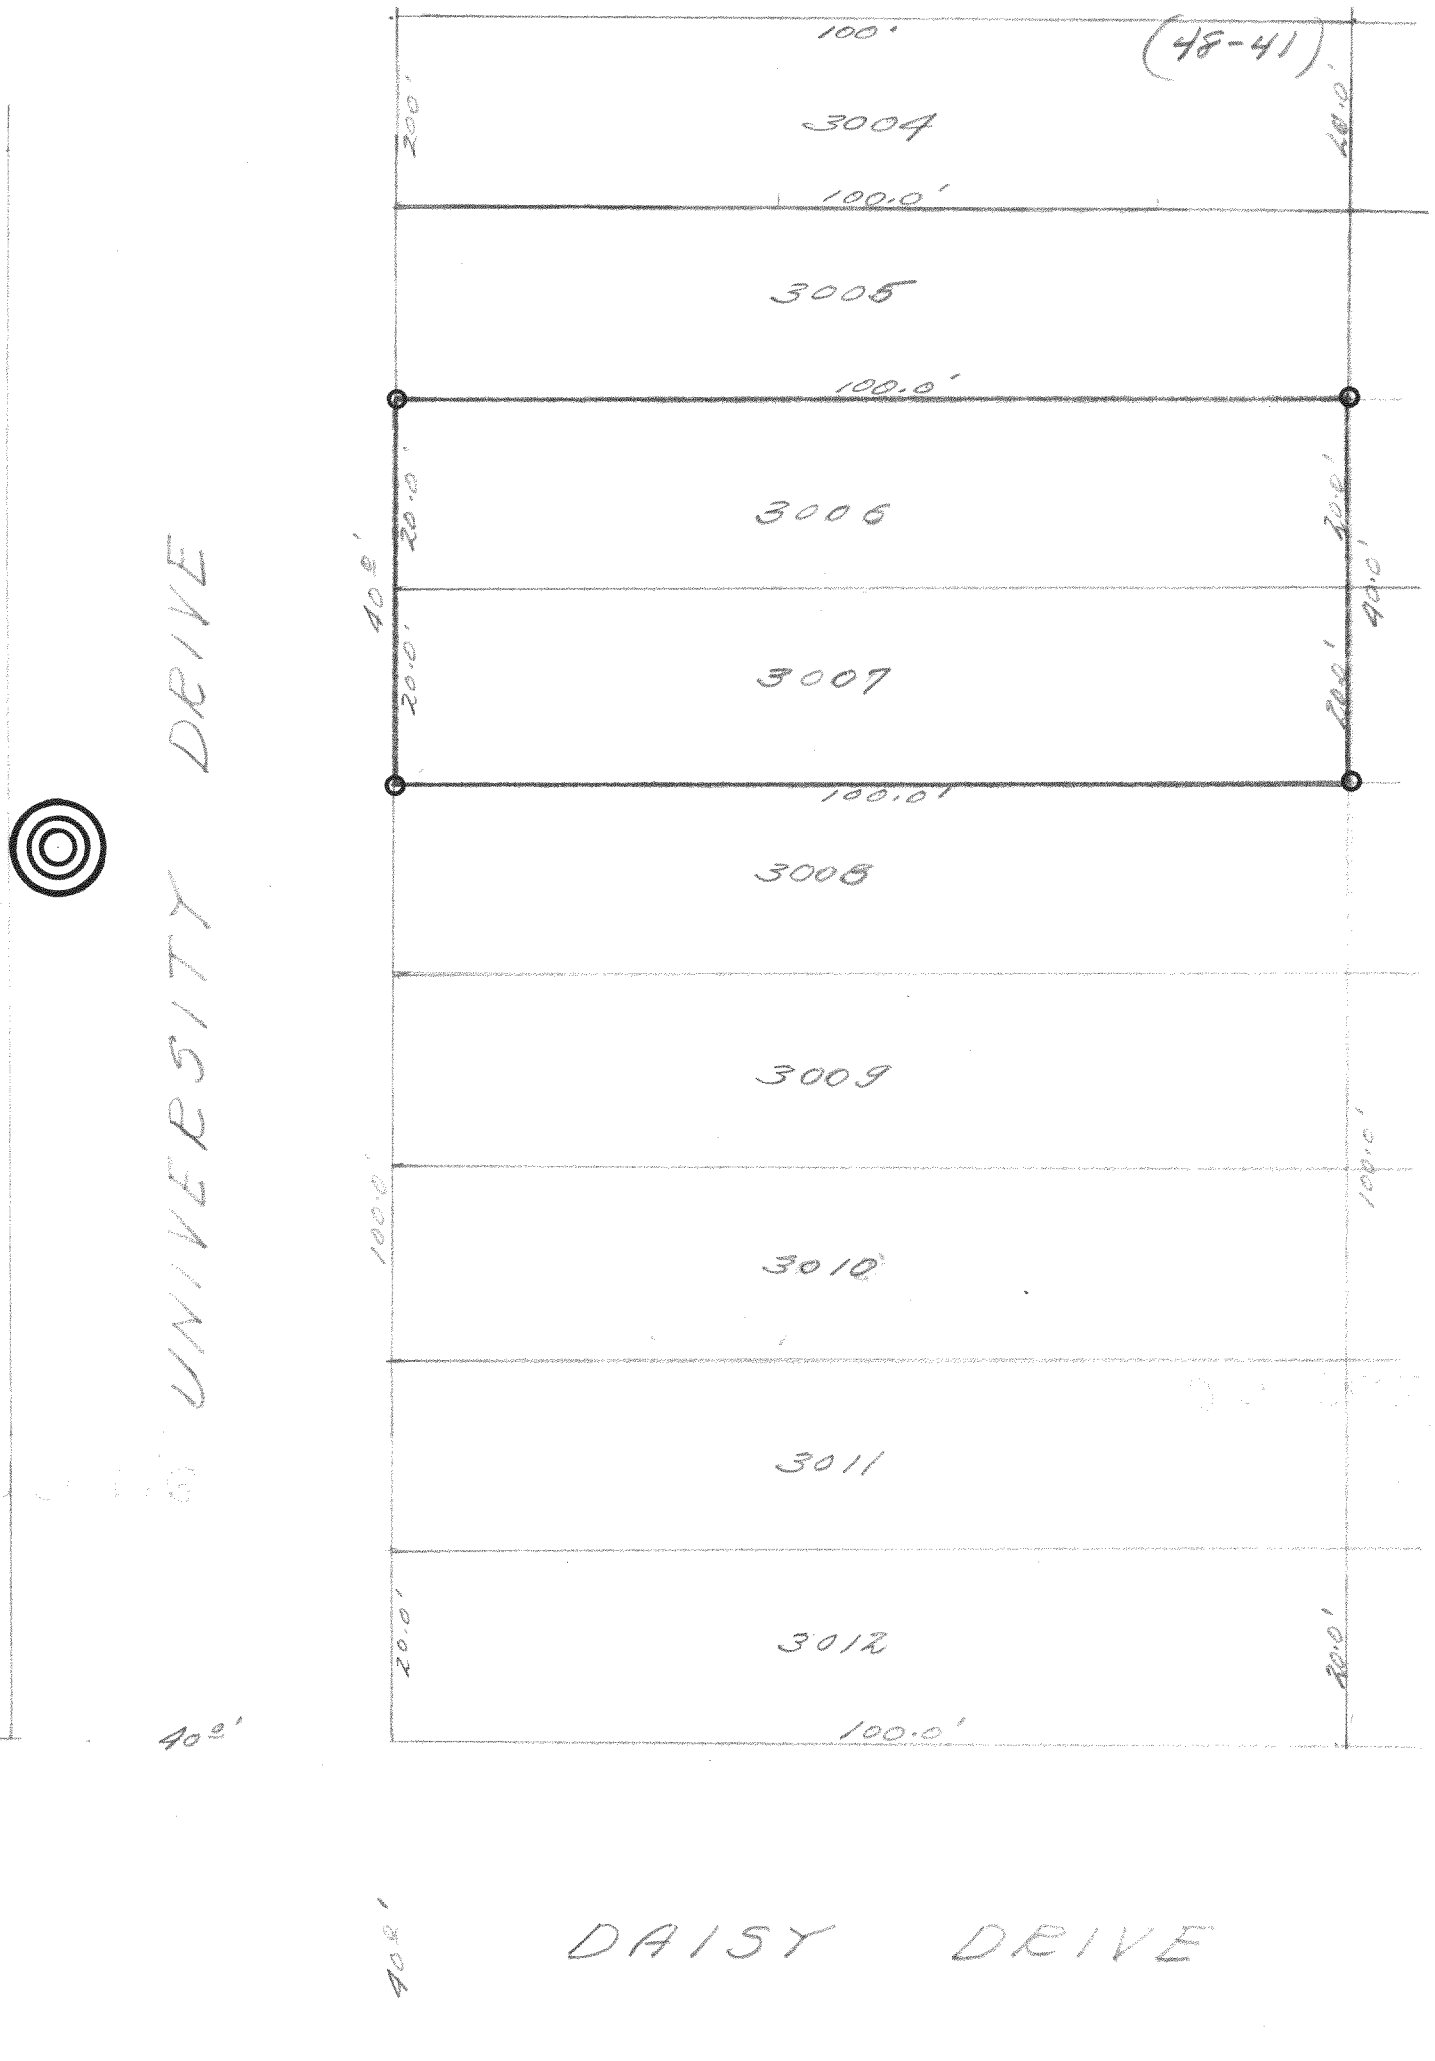


DESCRIPTION: Lots 3006 and 3007, Lake Como Beach Subdivision of a portion of Sections 21, 22, 27, and 28 Town 2 north, Range 17 east of the 4th Principal Meridian.

CERTIFICATE: I, hereby certify that I have on this the 10th day of April surveyed the above described property according to the official records on file in the office of the Recorder of Deeds in and for Walworth County, Wisconsin and find that the measurements and bearings of the boundary lines of said property as taken at the site on this day substantially agree with those in the above description and that no encroachments exist.
SIGNED AND SEALED THIS 12THDAY OF APRIL 1948.

Joseph M. Biagi.

Joseph M. Biagi. Professional Engineer.
Elkhorn Wisconsin.

JMB-537

217-136B