PLAT OF SURVEY

UNIT 04-01

GENEVA NATIONAL CONDOMINIUM

LOCATED IN THE SE 1/4 SECTION 30

TOWN 2 NORTH, RANGE 17 EAST

WALWORTH COUNTY, WISCONSIN

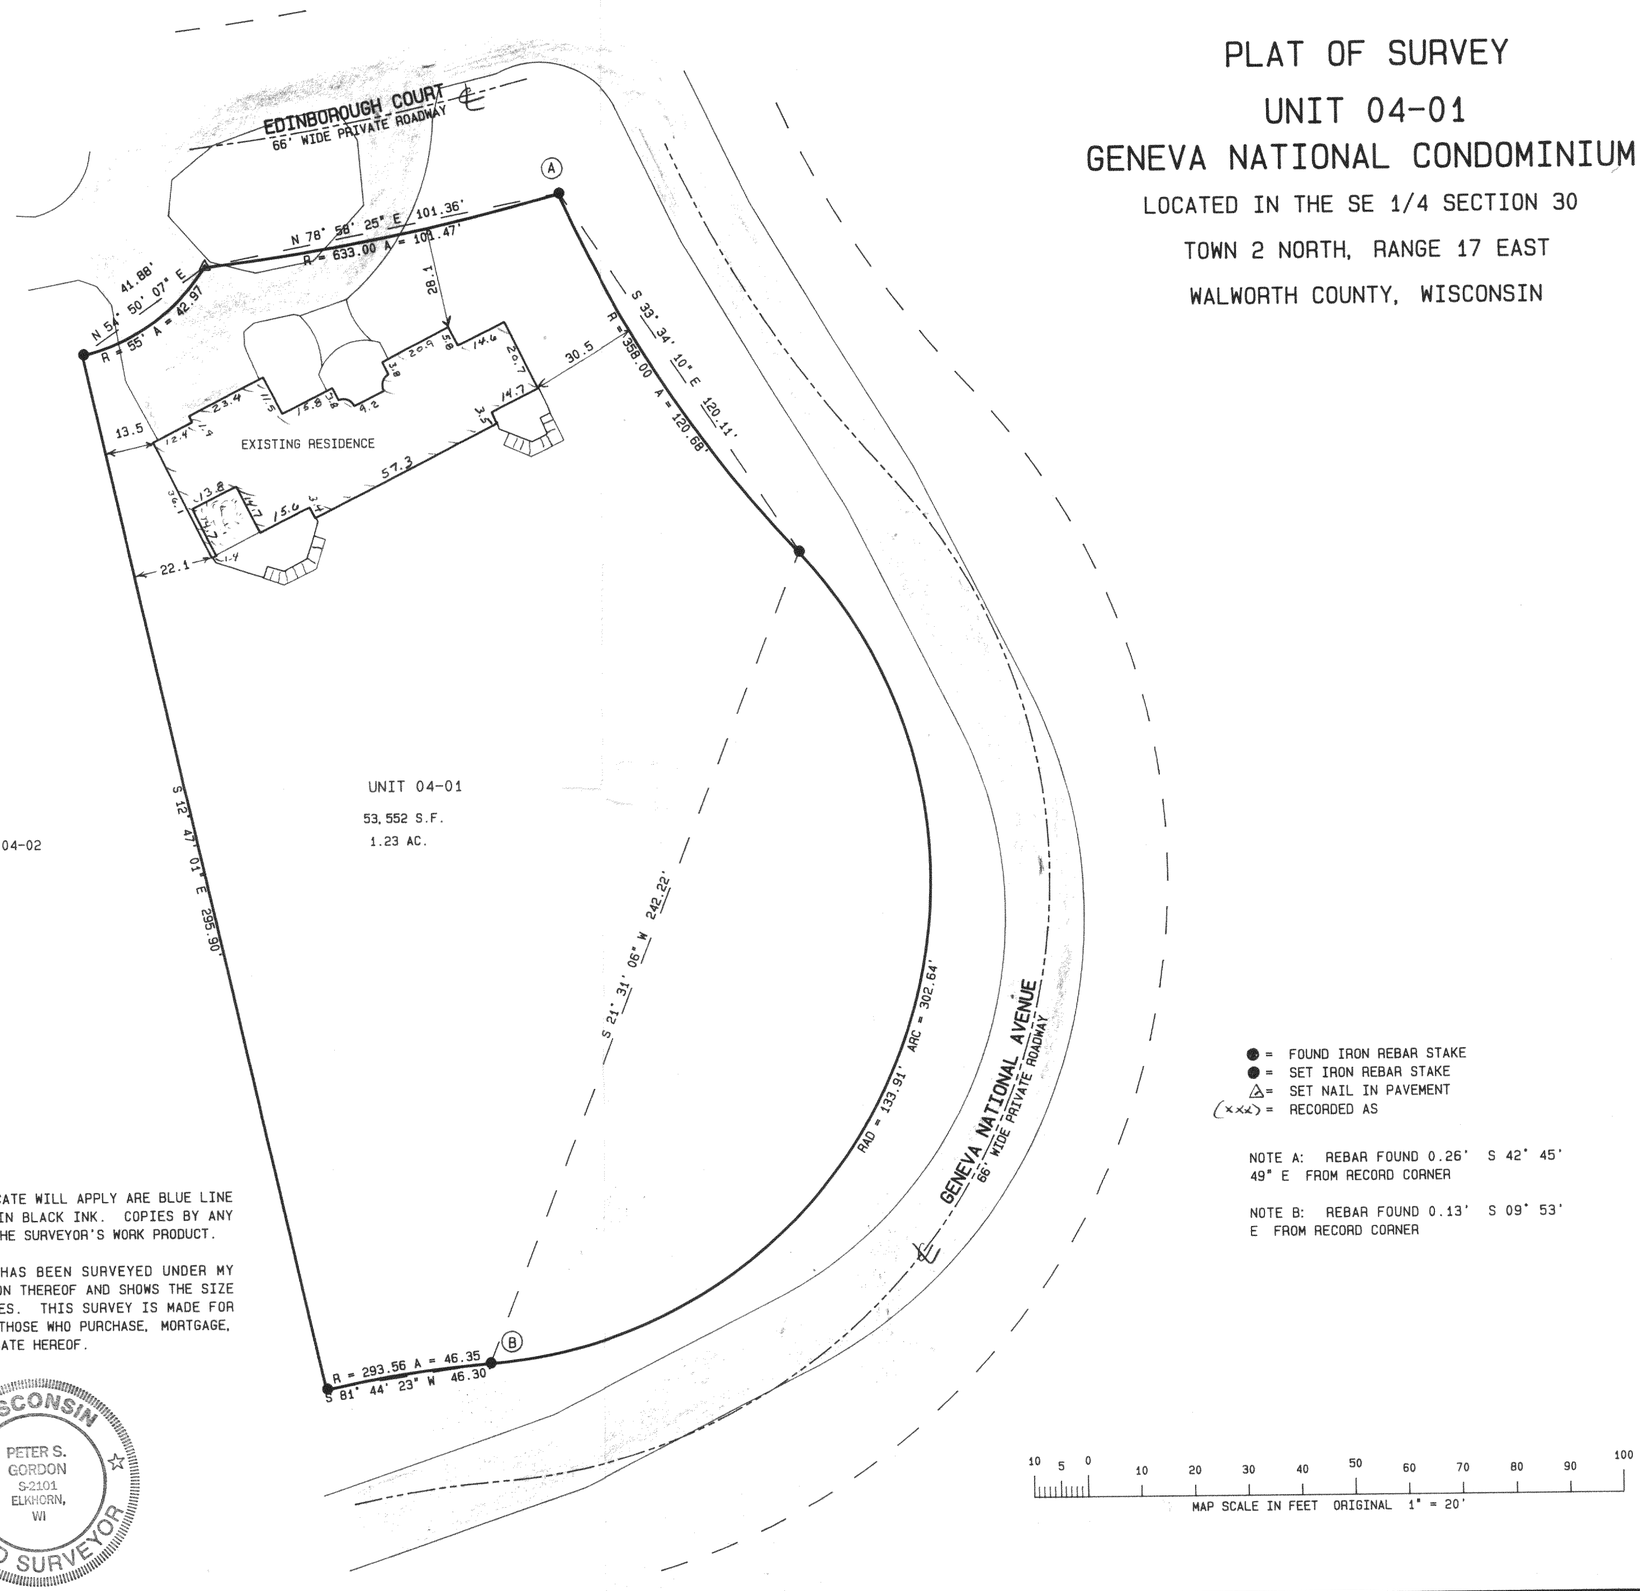

● = FOUND IRON REBAR STAKE
● = SET IRON REBAR STAKE
△ = SET NAIL IN PAVEMENT
(xxx) = RECORDED AS

NOTE A: REBAR FOUND 0.26' S 42° 45' 49" E FROM RECORD CORNER

NOTE B: REBAR FOUND 0.13' S 09° 53' E FROM RECORD CORNER

10 5 0 10 20 30 40 50 60 70 80 90 100

MAP SCALE IN FEET ORIGINAL 1" = 20'

RECEIVED
AUG 20 1996

NOTE: COPIES OF THIS MAP TO WHICH THE FOLLOWING CERTIFICATE WILL APPLY ARE BLUE LINE PRINTS SHOWING SURVEYOR'S ORIGINAL SEAL AND SIGNATURE IN BLACK INK. COPIES BY ANY OTHER MEANS MAY HAVE ALTERATIONS WHICH DO NOT REPRESENT THE SURVEYOR'S WORK PRODUCT.

I HEREBY CERTIFY THAT THE ABOVE DESCRIBED PROPERTY HAS BEEN SURVEYED UNDER MY DIRECTION AND THAT THE ABOVE MAP IS A TRUE REPRESENTATION THEREOF AND SHOWS THE SIZE AND LOCATION OF THE PROPERTY AND ITS EXTERIOR BOUNDARIES. THIS SURVEY IS MADE FOR THE USE OF THE PRESENT OWNERS OF THE PROPERTY, AND ALSO THOSE WHO PURCHASE, MORTGAGE, OR GUARANTEE THE TITLE THERETO WITHIN ONE YEAR FROM THE DATE HEREOF.

DATED: 7-16-1996

PETER S. GORDON R.L.S. 2101

WISCONSIN PETER S. GORDON S-2101 ELKHORN, WI LAND SURVEYOR

JGN 4-1

WORK ORDERED BY: TOM JAWORT
JAWORT-LOWELL
150 N. WALWORTH AVE
WILLIAMS BAY, WISCONSIN

FARRIS, HANSEN & ASSOCIATES, INC.
Engineering, Architecture, Surveying
7 Ridgeway Court P.O. Box 437
ELKHORN, WISCONSIN 53121
Office: (414) 723-2098
Fax: (414) 723-5886

REVISIONS

PROJECT NO. 3269.0401
DATE 07/15/96
SHEET NO. 1 OF 1

217-1376