
#117-69

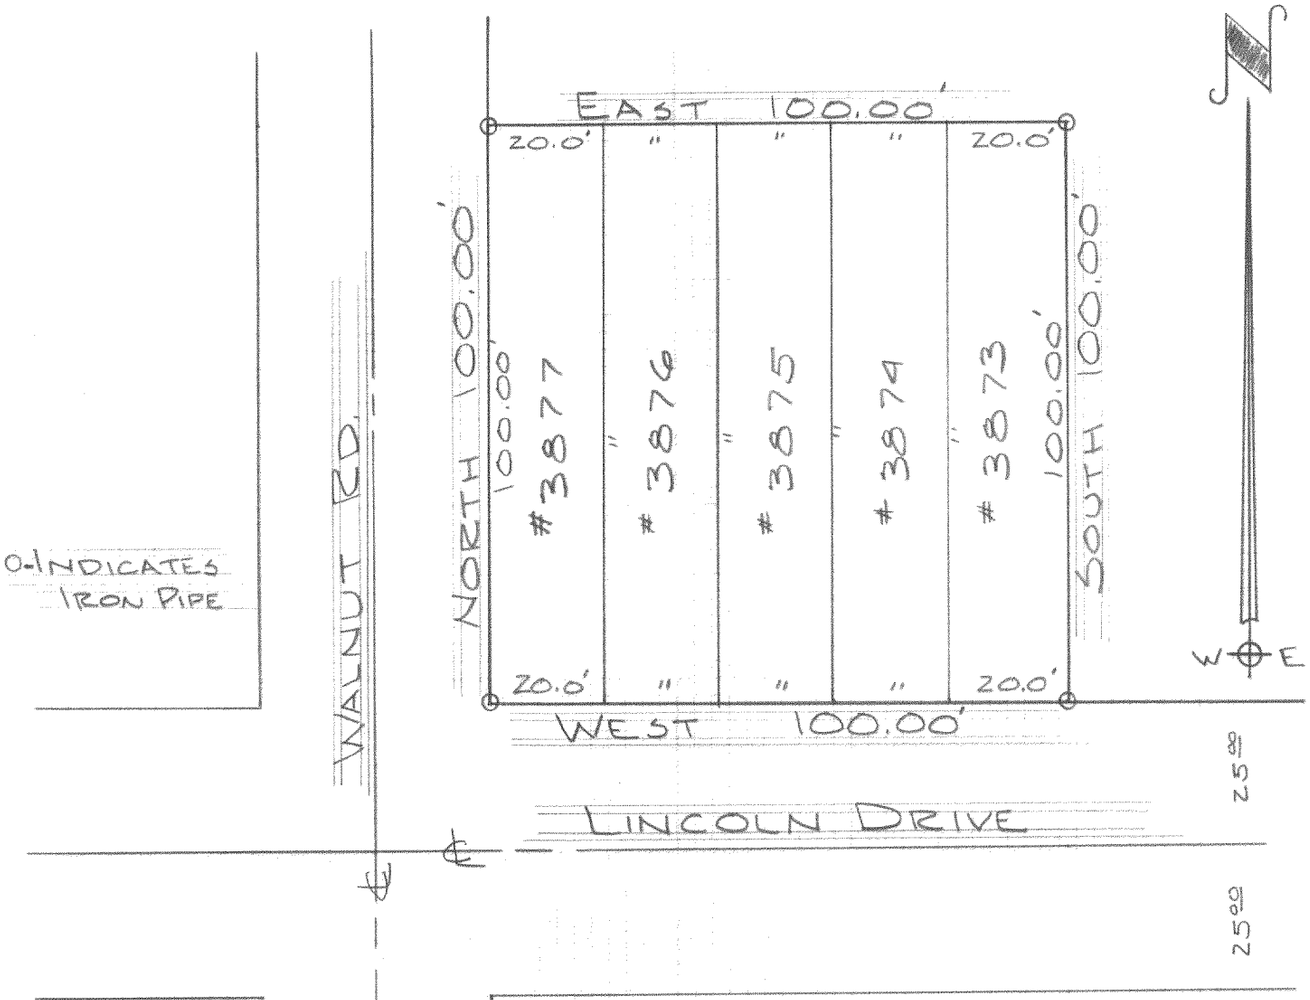

Description:

Lots 3873 through 3877, Lake Como Beach Subdivision 2nd Map, of a portion of Sections 27 and 28, Town 2 north, Range 17 east, Geneva Township, Walworth County, Wisconsin.

Certificate:

I, James F. Biagi, surveyor do hereby certify that I, have surveyed the above described property.

James F. Biagi

James F. Biagi. RLS 272 Wis.
Elkhorn, Wisconsin.

WISCONSIN JAMES F. BIAGI LAND SURVEYOR

Dated: August 19th 1969.

JLCB-790

217-144B