PLAT OF SURVEY

PATHFINDER SURVEYING
929 WILLIAMS LAKE GENEVA, WI 53147
(414) 248-3697

OWNER: RUDOLPH J. ANDERSON

DATE: 5/10/1997

DESCRIPTION: LOTS 10323 THROUGH 10327 LAKE COMO BEACH, A SUBDIVISION LOCATED IN T 2 N, R 17 E, TOWN OF GENEVA, COUNTY OF WALWORTH, STATE OF WISCONSIN.

LEGEND

⊕ FOUND CONCRETE MONUMENT


o FOUND 1 IN. IRON PIPE

▪ SET 1 IN. IRON PIPE

● WATER WELL

○ SEPTIC LID

NOTE: BASIS OF BEARINGS. WEST LINE TAKEN TO BE NORTH.

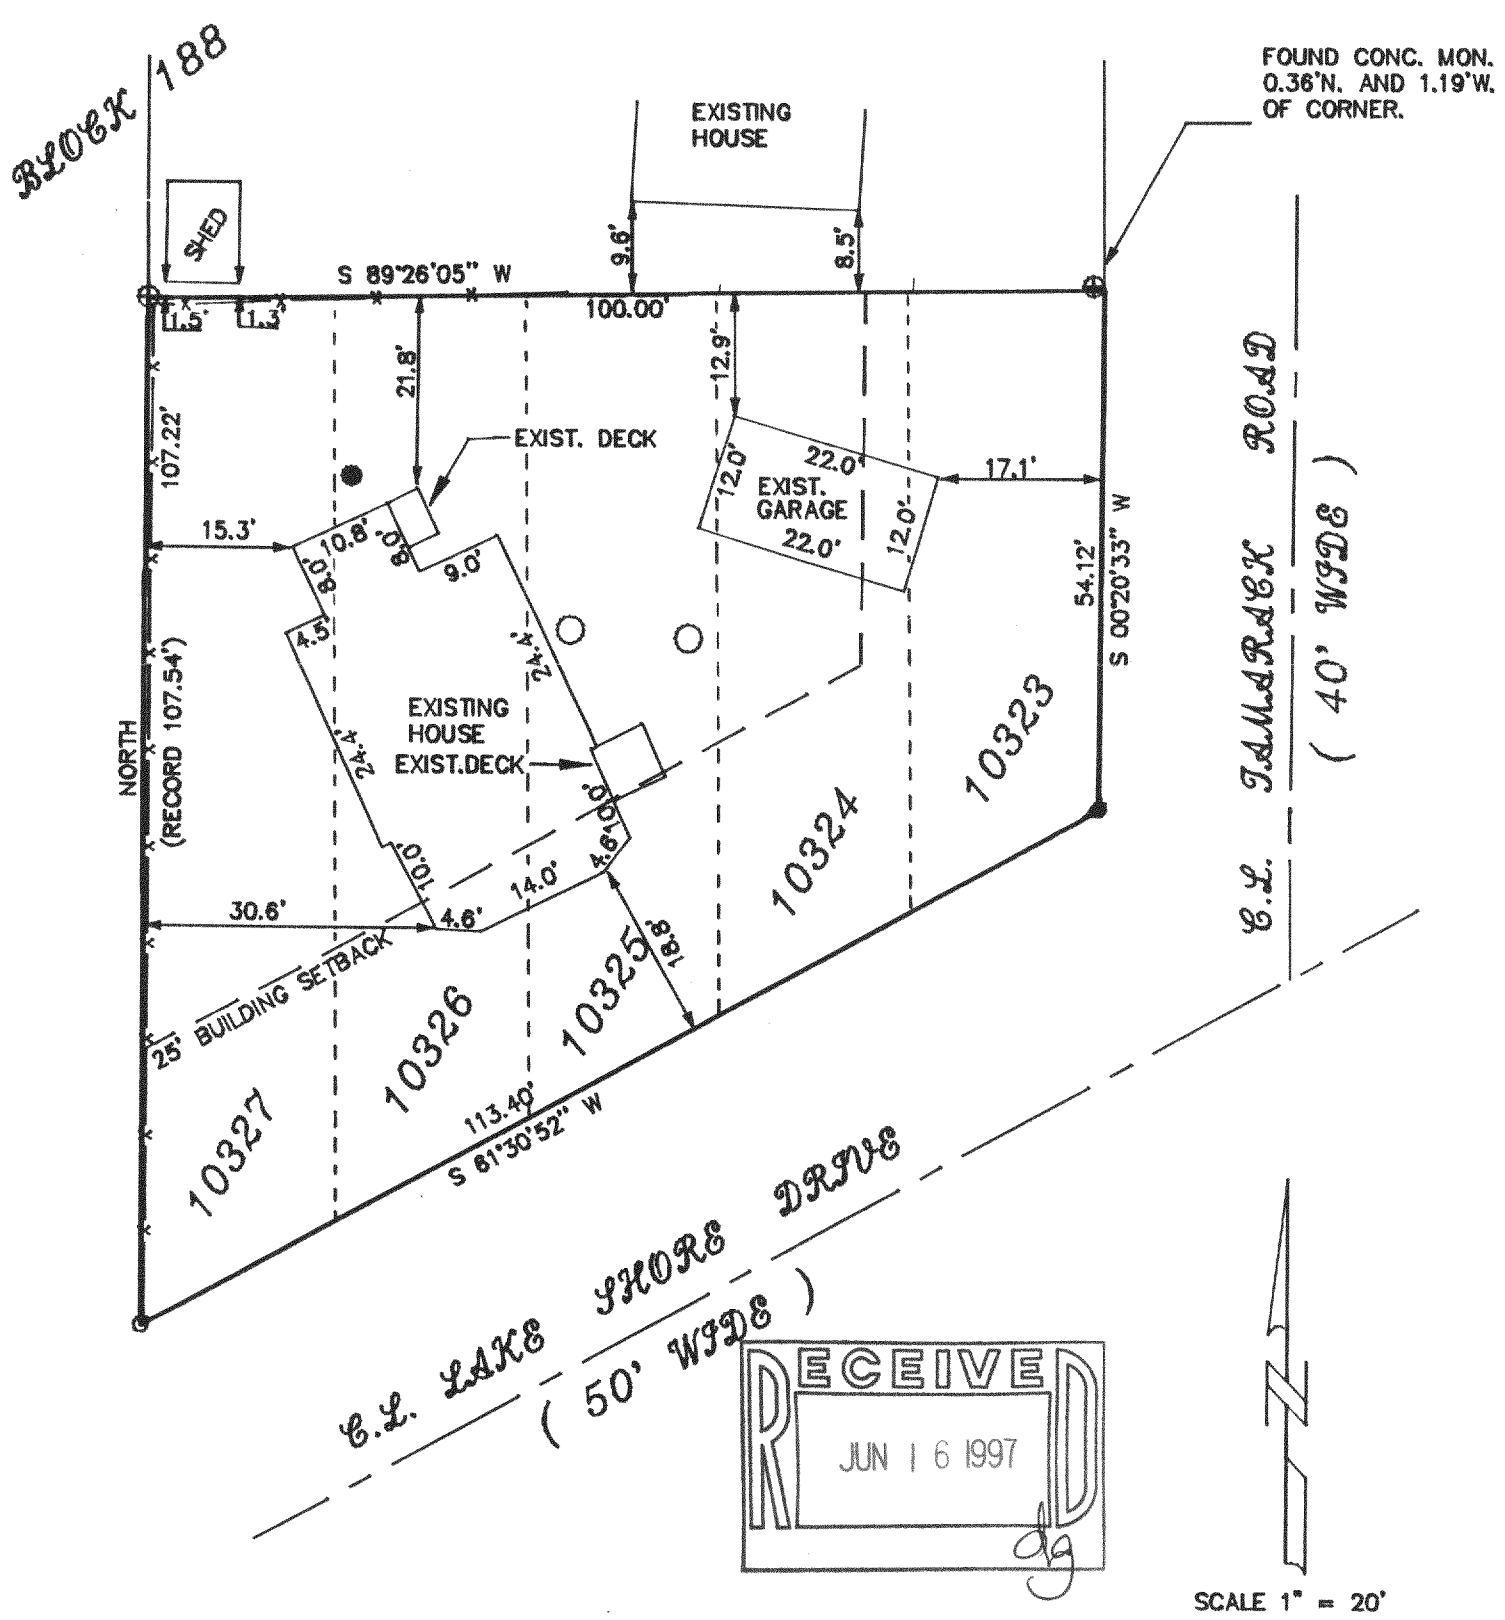

RECEIVED
JUN 16 1997

THE ABOVE MAP IS A TRUE REPRESENTATION THEREOF AND SHOWS THE SIZE AND LOCATION OF ALL THE PROPERTY, EXTERIOR BOUNDARIES, THE LOCATION OF ALL VISIBLE BOUNDARY FENCES , APPARENT EASEMENTS , ROADWAYS AND VISIBLE ENCROACHMENTS , IF ANY.

THIS SURVEY IS MADE FOR THE USE OF THE PRESENT OWNERS OF THE PROPERTY , AND ALSO THOSE WHO PURCHASE , MORTGAGE OR GURANTEE TITLE THERETO WITHIN ONE (1) YEAR FROM DATE HERETO.

WISCONSIN
JOHN P. KROTT
S-2258
MUKWONAGO, WIS.
LAND SURVEYOR

John P Krott
JOHN P. KROTT , R.L.S. 2258

NOTE: THIS IS NOT A CERTIFIED COPY UNLESS SEAL IS IN RED.

JOB NUMBER JLCB2233

JLCB-2233
217-1489