
HAROLD H. KOLB
REGISTERED PROFESSIONAL LAND SURVEYOR
LAKE GENEVA, WISCONSIN

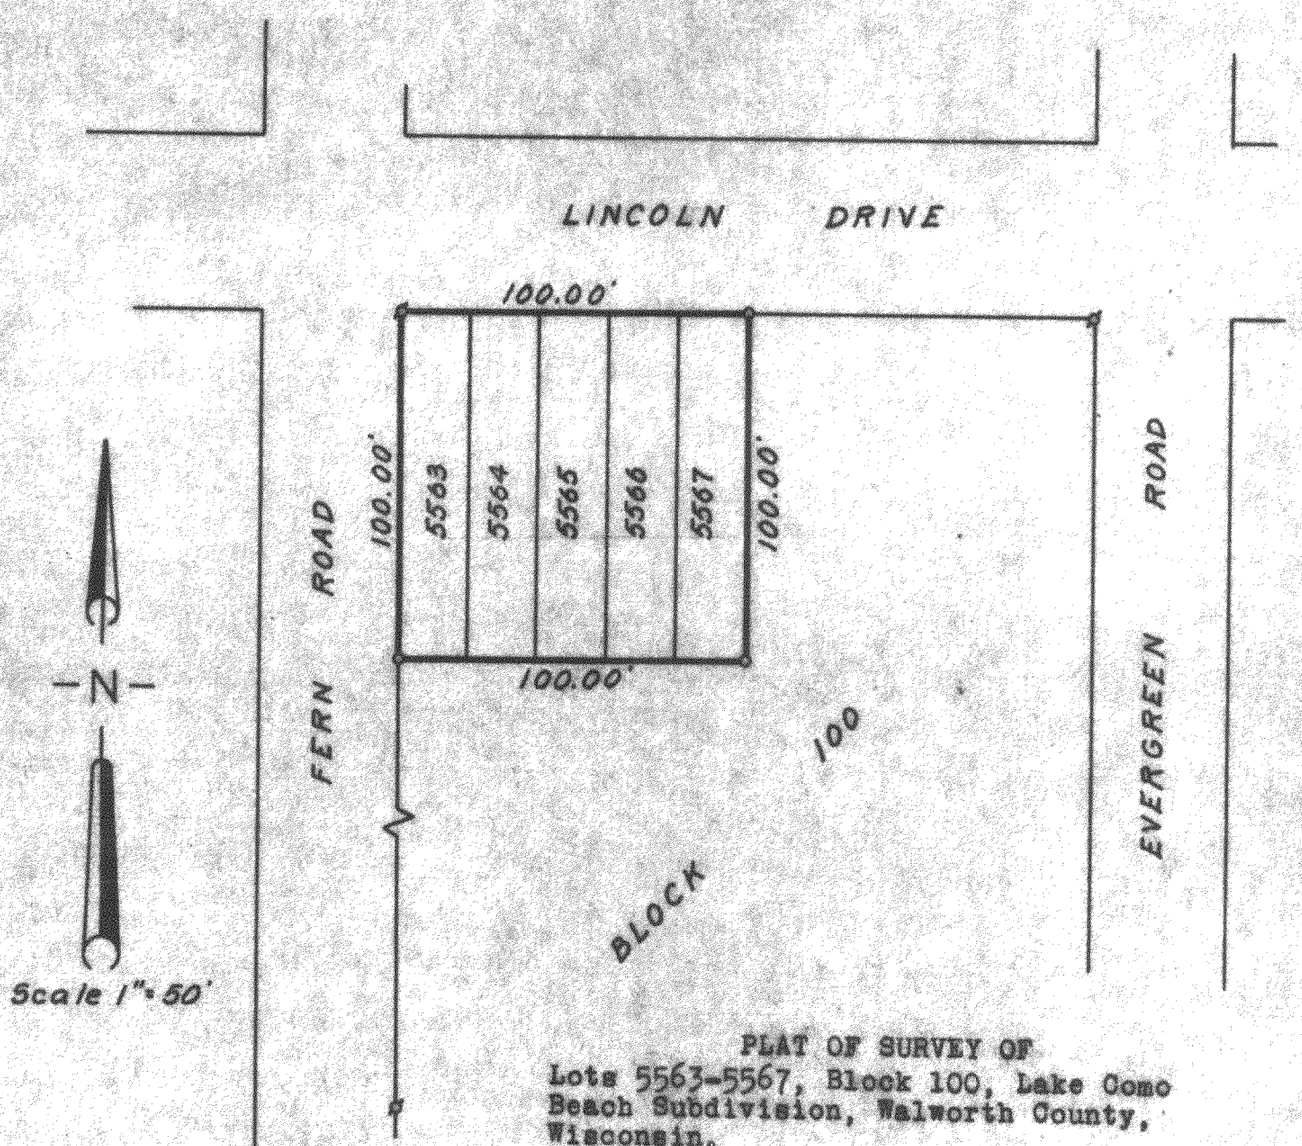

PLAT OF SURVEY OF
Lots 5563-5567, Block 100, Lake Como Beach Subdivision, Walworth County, Wisconsin.

Harold H. Kolb
Harold H. Kolb
Wisconsin Surveyor, S-187

⌀ - Iron Pipe Found
○ - Iron Pipe Placed

9-21-62

217-157

JLC B-1131