15-170

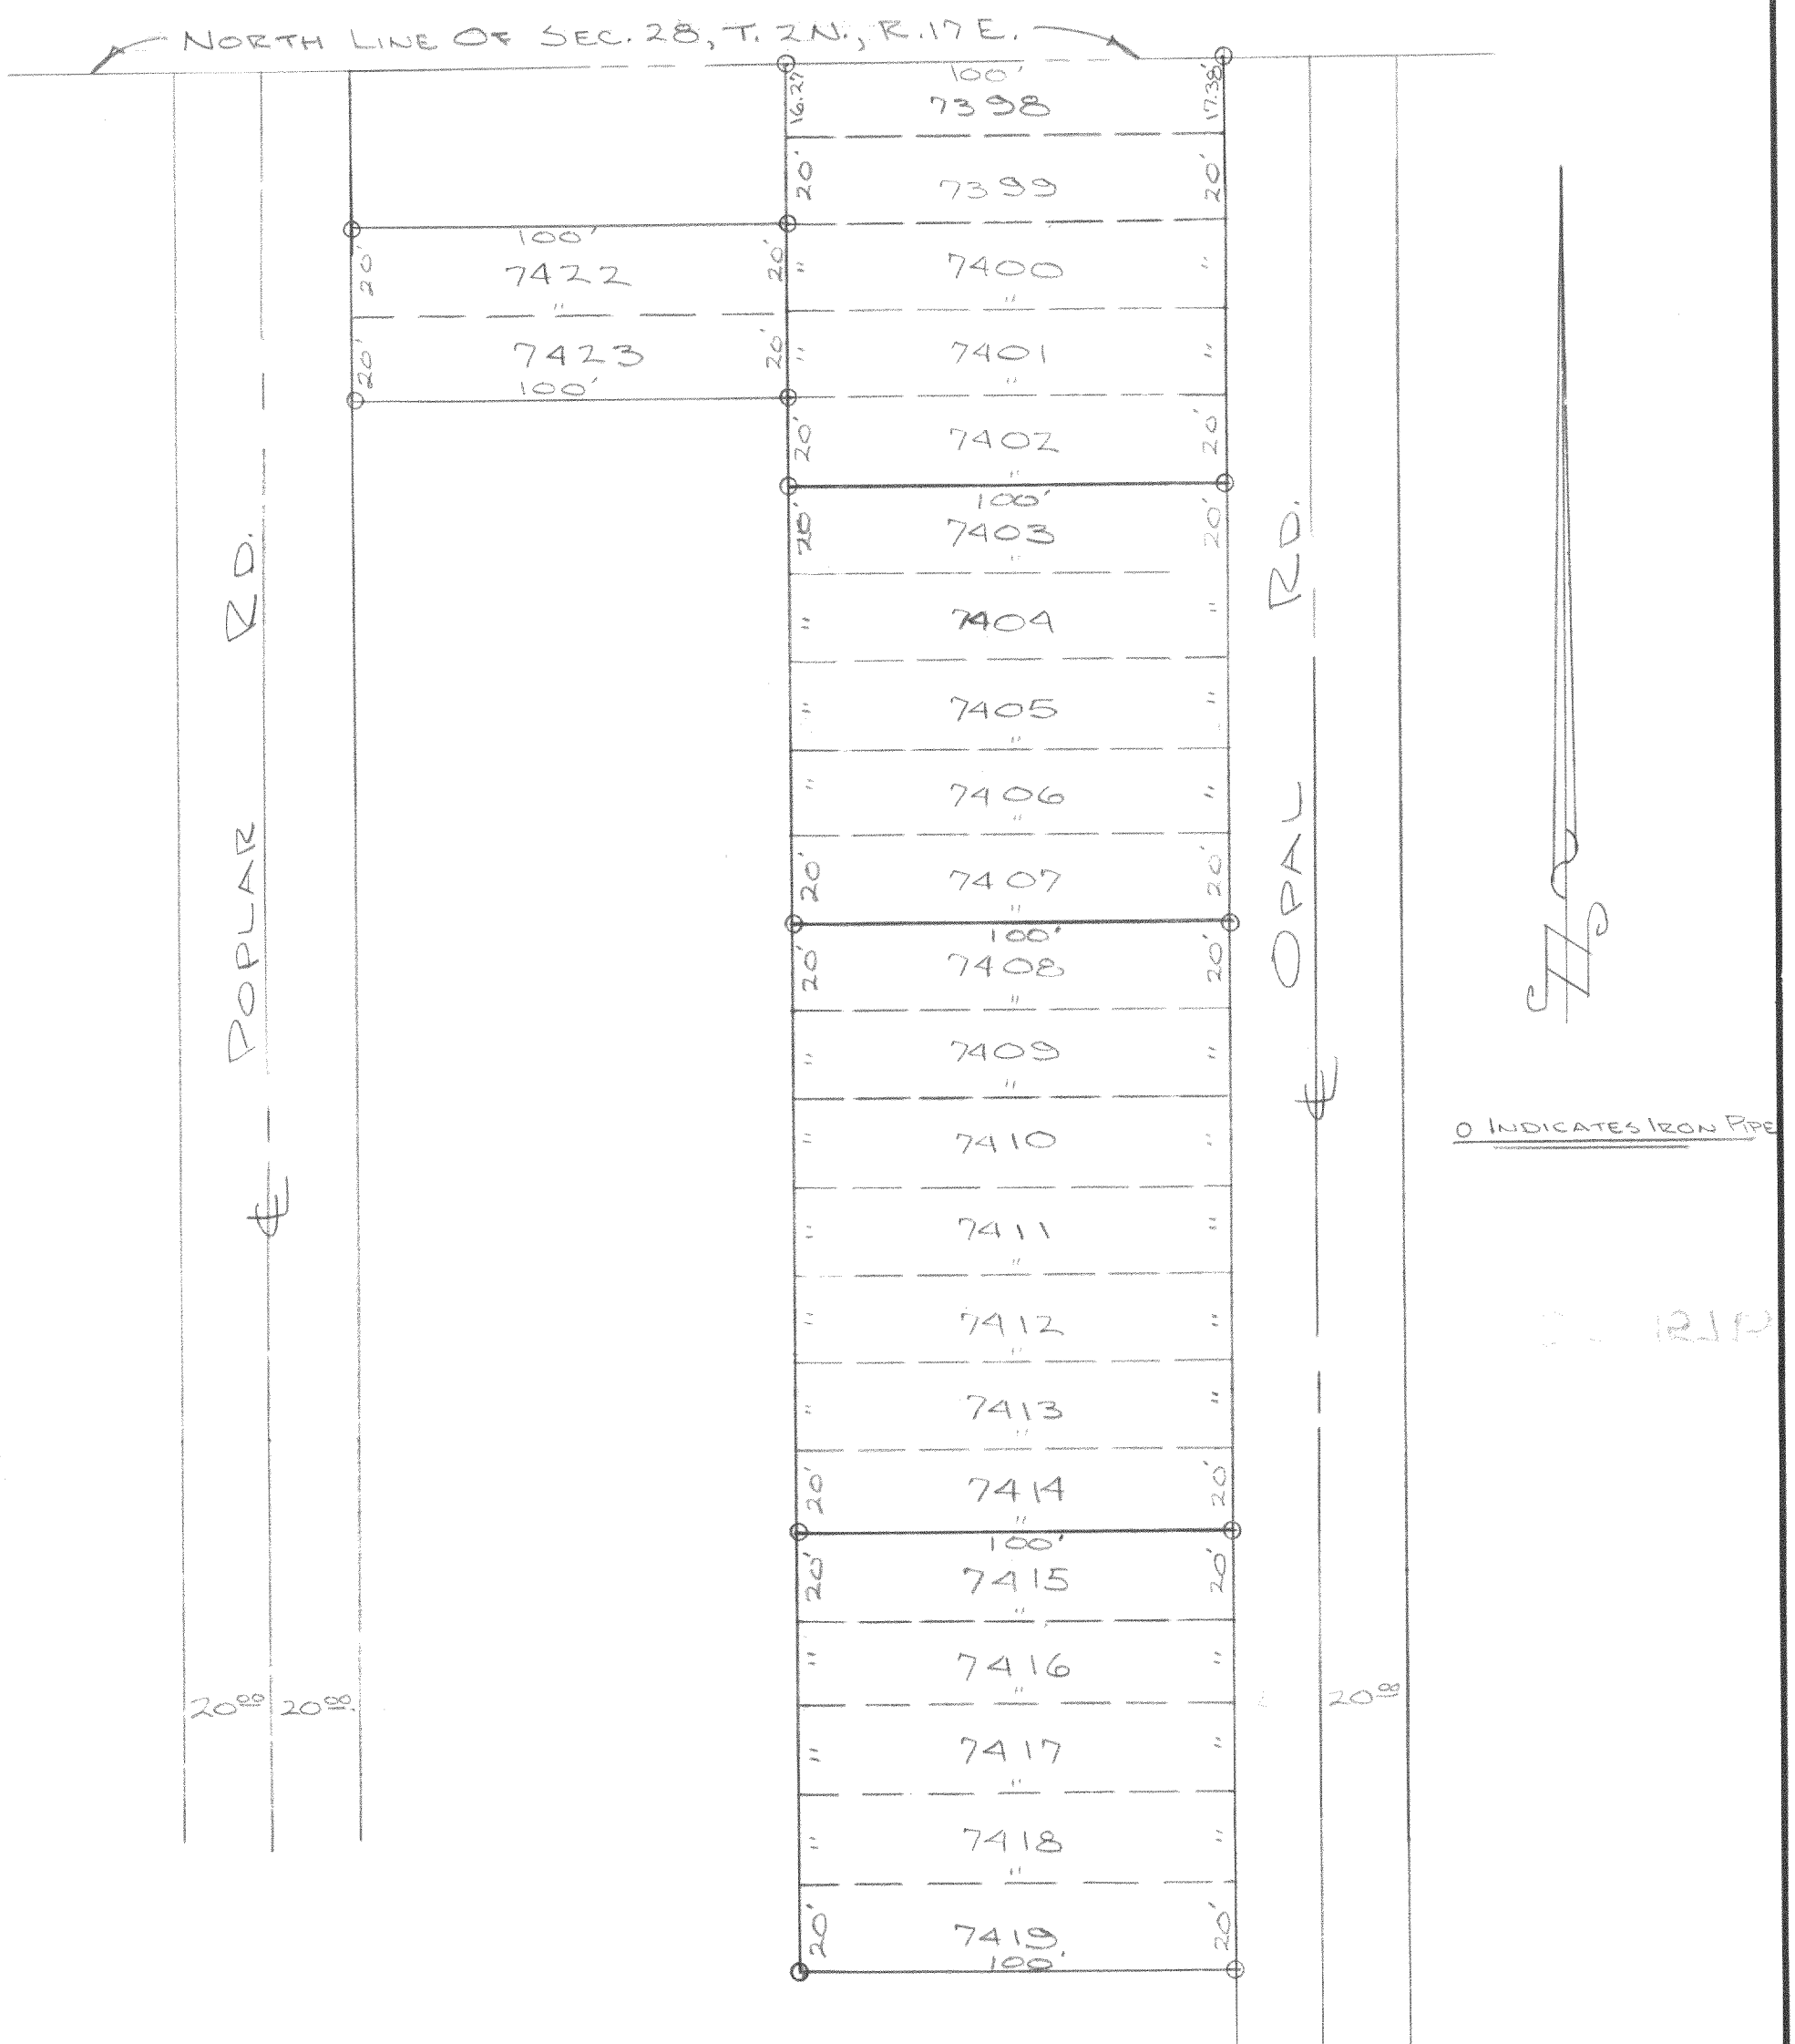

DESCRIPTION: Lots 7422 and 7423; Lots 7398 thru 7402 inclusive; Lots 7403 thru 7407 inclusive; Lots 7408 thru 7414 inclusive; and Lots 7415 thru 7419 inclusive of Block 127 of the First Map of Lake Como Beach Subdivision of a portion of Section 28, Town 2 north, Range 17 east, Geneva Township. Walworth County, Wisconsin.

CERTIFICATE: I, James F. Biagi, Surveyor hereby certify that I have surveyed the property hereon described.

James F. Biagi RLS 272
Elkhorn, Wisconsin.

Date: August 10th 1970.

WISCONSIN
JAMES F. BIAGI
MILWAUKEE, WIS.
LAND SURVEYOR

REVISIONS		
NO.	DATE	BY
1		
2		
3		
4		
5		

FOUR LOT PLAT FOR

JOE PALINSKY

DRAWN BY A.W.R.	SCALE 1"=40'-0"	MATERIAL
CHK'D	DATE	DRAWING NO.
TRACED	APP'D	

J.L.C. 8-1570, 1571, 1572, 1573, 1574

217-157 B