
HAROLD H. KOLB
REGISTERED PROFESSIONAL LAND SURVEYOR
LAKE GENEVA, WISCONSIN

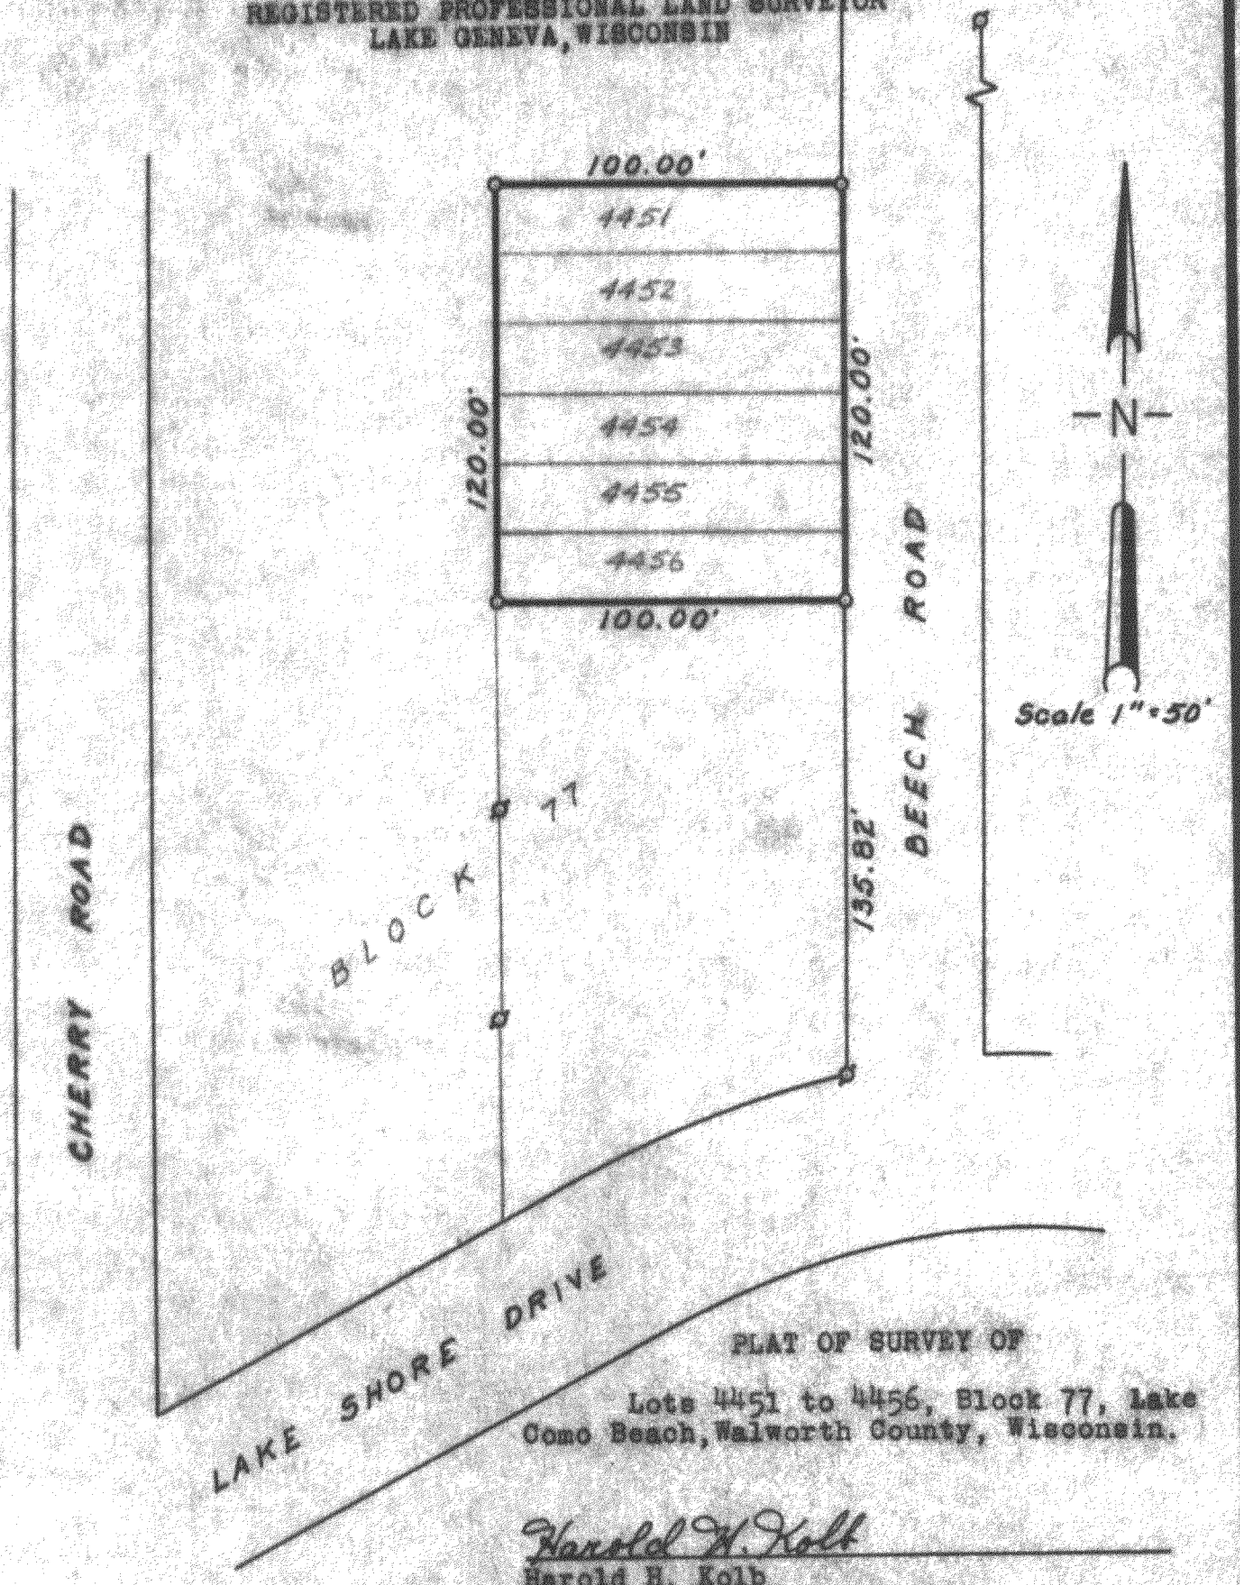

PLAT OF SURVEY OF

Lots 4451 to 4456, Block 77, Lake Como Beach, Walworth County, Wisconsin.

Harold H. Kolb
Harold H. Kolb
Wisconsin Surveyor, S-157

⊡ - Iron Pipe Found
○ - Iron Pipe Placed

7-24-68

JLLB-876

217-159