
PLAT OF SURVEY

PATHFINDER SURVEYING
FORMERLY KOLB LAND CONSULTING
929 WILLIAMS ST. LAKE GENEVA, WI.
(414) 248-3697

ORDERED BY : TIM SWATEK

DATE: 4 / 2 / 1998


ALLEN HARRISON WILLIAMS
MCDONELL & SWATEK
527 CENTER STREET.
LAKE GENEVA, WI. 53147

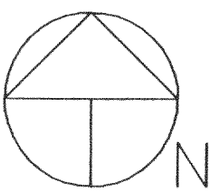

SCALE 1" = 20'

LEGEND

- ⊙ FOUND 1 IN. DIA. IRON PIPE
- ⊙ SEPTIC MANHOLE
- (XXXX) RECORDED AS
- ——x—— FENCE

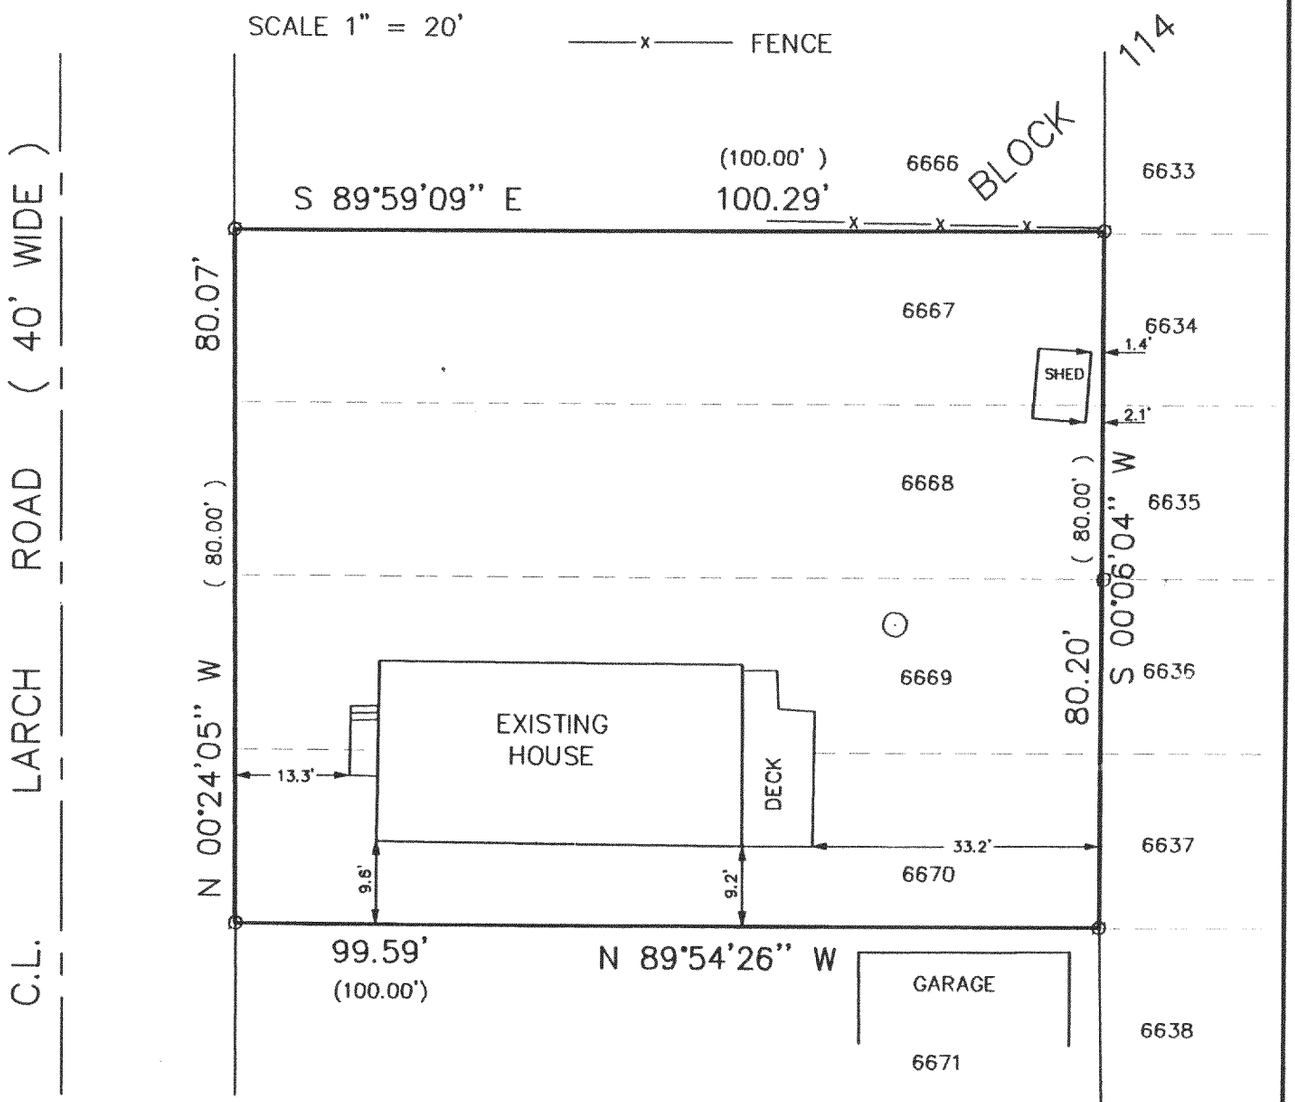

DESCRIPTION;

LOTS 6667, 6668, 6669, AND 6670 OF LAKE COMO BEACH SUBDIVISION, LOCATED IN SECTION 28, TOWN 2 NORTH, RANGE 17 EAST , WALWORTH COUNTY, WISCONSIN.


THE ABOVE MAP IS A TRUE REPRESENTATION THEREOF AND SHOWS THE SIZE AND LOCATION OF ALL THE PROPERTY, EXTERIOR BOUNDARIES, THE LOCATION OF ALL VISIBLE BOUNDARY FENCES , APPARENT EASEMENTS , ROADWAYS AND VISIBLE ENCROACHMENTS , IF ANY.

THIS SURVEY IS MADE FOR THE USE OF THE PRESENT OWNERS OF THE PROPERTY , AND ALSO THOSE WHO PURCHASE , MORTGAGE OR GURANTEE TITLE THERETO WITHIN ONE (1) YEAR FROM DATE HERETO.



John P Krott

JOHN P. KROTT , R.L.S. 2258

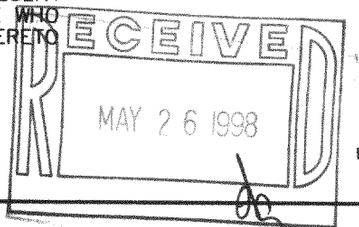

NOTE: THIS IS NOT A CERTIFIED COPY UNLESS SEAL IS IN RED.

JOB NUMBER 98052 2-17-JLCB01396

JLCB-1396 217-1636