
PLAT OF SURVEY

PATHFINDER SURVEYING
FORMERLY KOLB LAND CONSULTING
929 WILLIAMS ST. LAKE GENEVA, WI.
(414) 248-3697

ORDERED BY : FLORENCE NETZEL
514 FREE CHURCH DRIVE WILLIAMS BAY WISCONSIN 53191

DATE: 7/7/1998

DESCRIPTION: OUT-LOT 1 CERTIFIED SURVEY MAP NUMBER 368 LOCATED IN THE NORTHWEST 1/4 OF SECTION 35, T 2 N, R 17 E, WALWORTH COUNTY, WISCONSIN

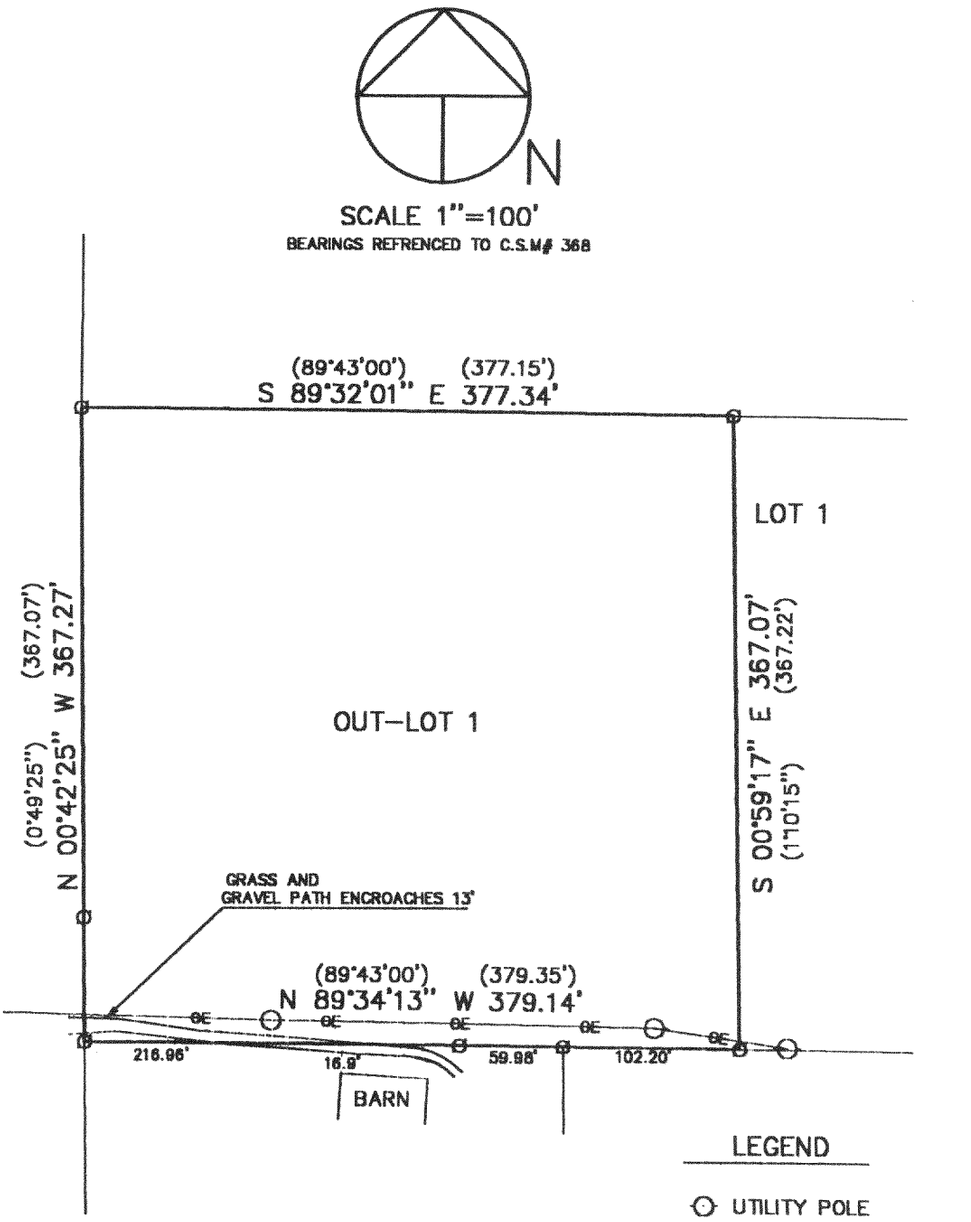

LEGEND

- UTILITY POLE
- ⌀ IRON PIPE FOUND
- (XXX) RECORDED AS
- — OE — OVER HEAD UTILITIES

RECEIVED
AUG 4 1998

THE ABOVE MAP IS A TRUE REPRESENTATION THEREOF AND SHOWS THE SIZE AND LOCATION OF ALL THE PROPERTY, EXTERIOR BOUNDARIES, THE LOCATION OF ALL VISIBLE BOUNDARY FENCES , APPARENT EASEMENTS , ROADWAYS AND VISIBLE ENCROACHMENTS , IF ANY.

THIS SURVEY IS MADE FOR THE USE OF THE PRESENT OWNERS OF THE PROPERTY , AND ALSO THOSE WHO PURCHASE , MORTGAGE OR GURANTEE TITLE THERETO WITHIN ONE (1) YEAR FROM DATE HERETO.

WISCONSIN
JOHN P. KROTT
S-2258
WALWORTH CO., WIS.
LAND SURVEYOR

John P Krott

JOHN P. KROTT , R.L.S. 2258

NOTE: THIS IS NOT A CERTIFIED COPY UNLESS SEAL IS IN RED.
JOB NUMBER 98071 2-17-JA36800002

JA-368-2

217-1644