
HAROLD H. KOLB

REGISTERED PROFESSIONAL LAND SURVEYOR
LAKE GENEVA, WISCONSIN

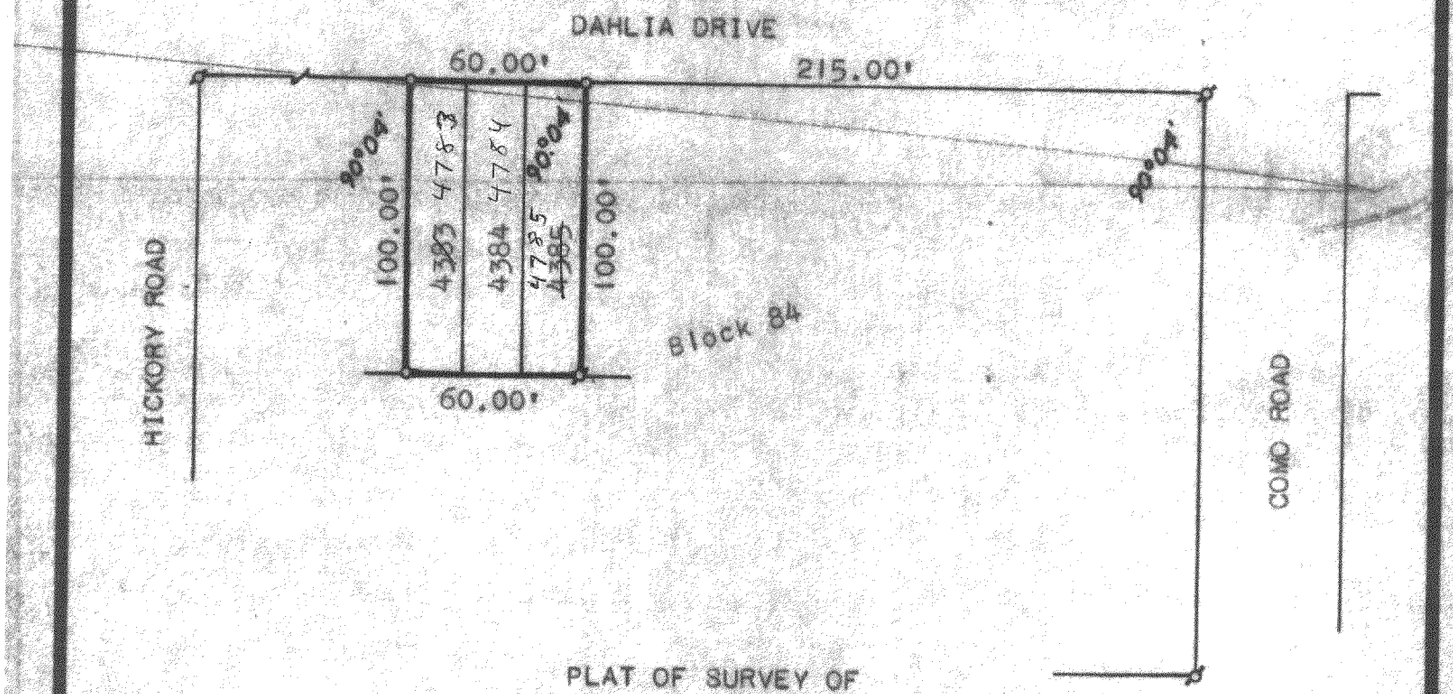

PLAT OF SURVEY OF
4783-4785
Lots ~~4383-4385~~, Block 84, Lake Como Beach Subdivision, located in Section 21, T 2 N, R 17 E, Walworth County, Wisconsin.

N

Scale: 1"=60'

LEGEND

- ⌀ — IRON PIPE FOUND
- ○ — IRON PIPE PLACED
- ● — CONCRETE MONUMENT
- x — SPIKE

I, HAROLD H. KOLB, DO HEREBY CERTIFY THAT I HAVE SURVEYED THE PROPERTY HEREON DESCRIBED ACCORDING TO THE OFFICIAL RECORDS, AND THAT THE PLAT HEREON IS A CORRECT REPRESENTATION OF THE LOT LINES.

Harold H. Kolb
HAROLD H. KOLB
WISCONSIN REGISTERED LAND SURVEYOR, S-187
DATE May 10, 1966

JLCB-950

217-170