PLAT OF SURVEY

PATHFINDER SURVEYING
FORMERLY KOLB LAND CONSULTING
929 WILLIAMS STREET LAKE GENEVA, WI. 53147
(414) 248-3697


DATE: 1/18/1999

ORDERED BY: MIKRUT REALTY
N 3443 CLUBHOUSE DR.
LAKE GENEVA, WI. 53147

DESCRIPTION: LOTS 9520-9524, BLOCK 172
LAKE COMO BEACH SUBDIVISON,
LOCATED IN T2N, R17E, WALWORTH
COUNTY, WISCONSIN.

N

SCALE 1"=20'
BEARINGS REFERNCED TO RECORD
PLAT LAKE COMO BEACH SUB.

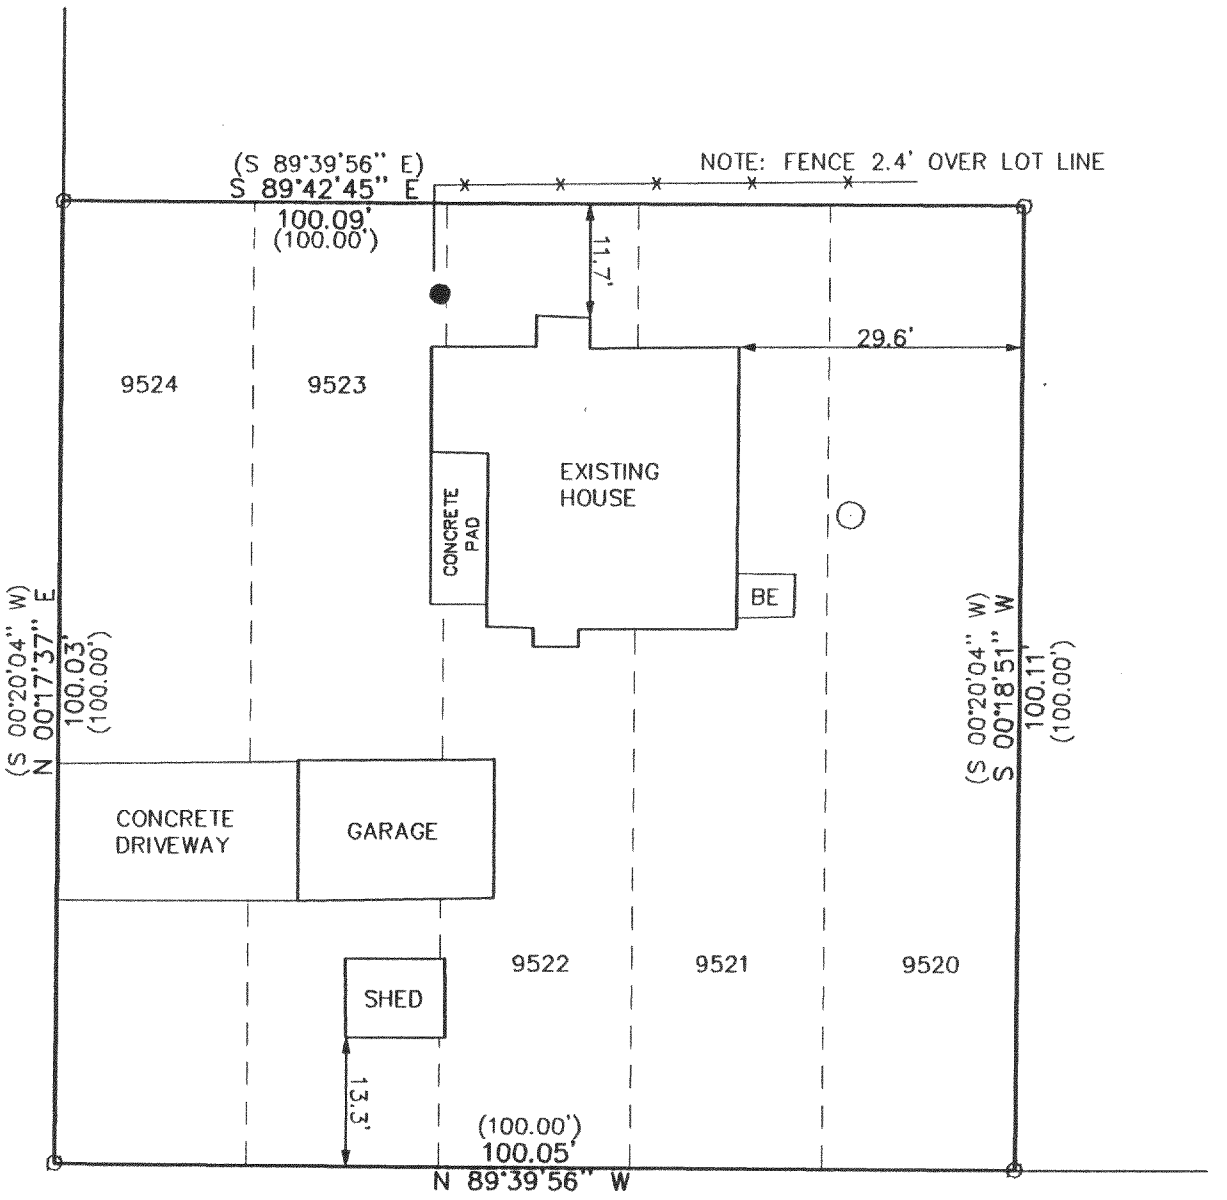

LEGEND

o	FOUND IRON PIPE
○	MANHOLE
●	WELL
—x—	FENCE
(XXXX)	RECORDED AS

RECEIVED
MAR 11 1999

THE ABOVE MAP IS A TRUE REPRESENTATION THEREOF AND SHOWS THE SIZE AND LOCATION OF ALL THE PROPERTY, EXTERIOR BOUNDARIES, THE LOCATION OF ALL VISIBLE BOUNDARY FENCES , APPARENT EASEMENTS , ROADWAYS AND VISIBLE ENCROACHMENTS , IF ANY

THIS SURVEY IS MADE FOR THE USE OF THE PRESENT OWNERS OF THE PROPERTY , AND ALSO THOSE WHO PURCHASE , MORTGAGE OR GURANTEE TITLE THERETO WITHIN ONE (1) YEAR FROM DATE HERETO.

WISCONSIN
JOHN P. KROTT
S-2258
MUKWONAGO, WIS.
LAND SURVEYOR

John P Krott
JOHN P. KROTT , R.L.S. 2258

NOTE: THIS IS NOT A CERTIFIED COPY UNLESS SEAL IS IN RED.

JOB NUMBER 99008 2-17-JLCB2052

JLCB-2052

217-1700