
PLAT OF SURVEY

PATHFINDER SURVEYING
FORMERLY KOLB LAND CONSULTING
929 WILLIAMS STREET LAKE GENEVA, WI. 53147
(414) 248-3697

ORDERED BY: RE/MAX GENEVA REALTY
101 BROAD ST.
LAKE GENEVA, WI. 53147

DATE: 2-23-1999

DESCRIPTION: LOT 54 WILDWOOD ADDITION NUMBER ONE LOCATED IN THE NORTH 1/2 OF SECTIONS 34 T2N, R17E, WALWORTH COUNTY, WISCONSIN, EXCEPTING THAT PORTION OF LOT 54 RESERVED FOR ORNAMENTAL SHRUBBERY BEGINING AT THE NE CORNER OF SAID LOT 54, THENCE SOUTH ALONG THE EAST BOUNDARY LINE OF SAID LOT A DISTANCE OF 40 FEET TO A POINT AT THE SOUTHWEST CORNER OF THE LARGE STONE ENTRANCE POST, THENCE WEST PARALLEL WITH THE NORTH BOUNDARY LINE OF SAID LOT A DISTANCE OF OF 15 FEET, THENCE NORTHWESTERLY TO THE NORTH BOUNDARY LINE OF SAID LOT, TO A POINT 2 FEET WEST OF THE NORTH EAST CORNER OF SAID LOT, THENCE EAST TO THE POINT OF BEGINNING.

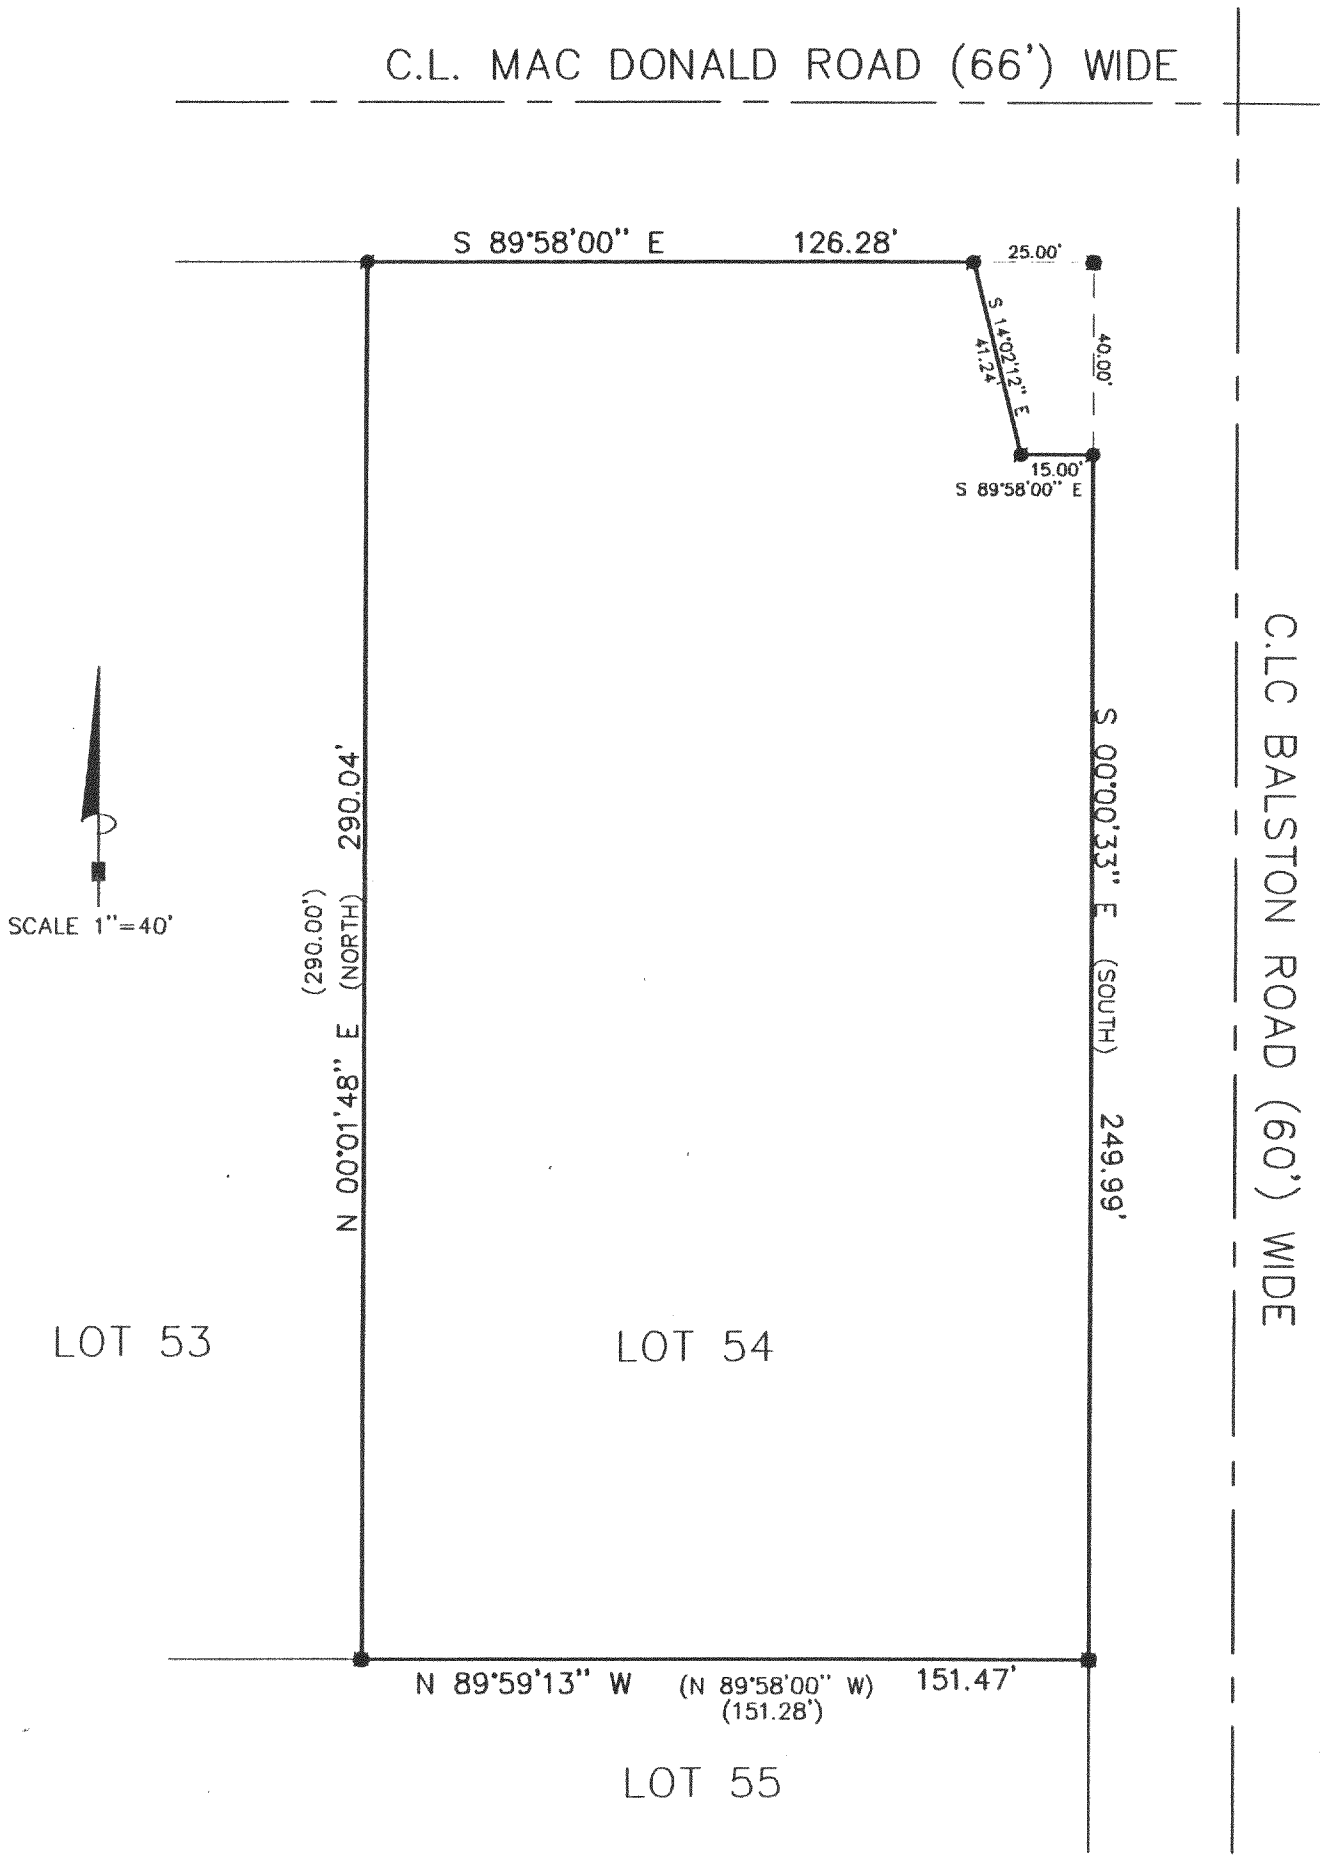

RECEIVED
MAR 1 1 1999

THE ABOVE MAP IS A TRUE REPRESENTATION THEREOF AND SHOWS THE SIZE AND LOCATION OF ALL THE PROPERTY, EXTERIOR BOUNDARIES, THE LOCATION OF ALL VISIBLE BOUNDARY FENCES , APPARENT EASEMENTS , ROADWAYS AND VISIBLE ENCROACHMENTS , IF ANY

THIS SURVEY IS MADE FOR THE USE OF THE PRESENT OWNERS OF THE PROPERTY , AND ALSO THOSE WHO PURCHASE , MORTGAGE OR GURANTEE TITLE THERETO WITHIN ONE (1) YEAR FROM DATE HERETO.

LEGEND

- ● FOUND IRON PIN
- ● SET IRON PIPE
- (XXX) RECORDED AS

WISCONSIN
JOHN P. KROTT
S-2258
MUKWONAGO, WIS.
LAND SURVEYOR

John P Krott
JOHN P. KROTT , R.L.S. 2258

NOTE: THIS IS NOT A CERTIFIED COPY UNLESS SEAL IS IN RED.

JOB NUMBER 99028C 2-17-JWSA-3

JWSA-3 217-1703