
FARRIS, HANSEN, & ASSOCIATES, INC.

ENGINEERING, ARCHITECTURE, SURVEYING
7 RIDGWAY COURT – P.O. BOX 437, ELKHORN, WISCONSIN, 53121
PHONE: (414) 723–2098 FAX: (414) 723–5886

PLAT OF SURVEY

LOTS 6523 THRU 6529 OF BLOCK 112
LAKE COMO BEACH SUBDIVISION
PART OF THE NW 1/4 OF SECTION 28, TOWN 2 NORTH, RANGE 17 EAST
WALWORTH COUNTY, WISCONSIN

– WORK ORDERED BY –
FRED BOSS
3156 LARCH ROAD
LAKE GENEVA, WISCONSIN 53147

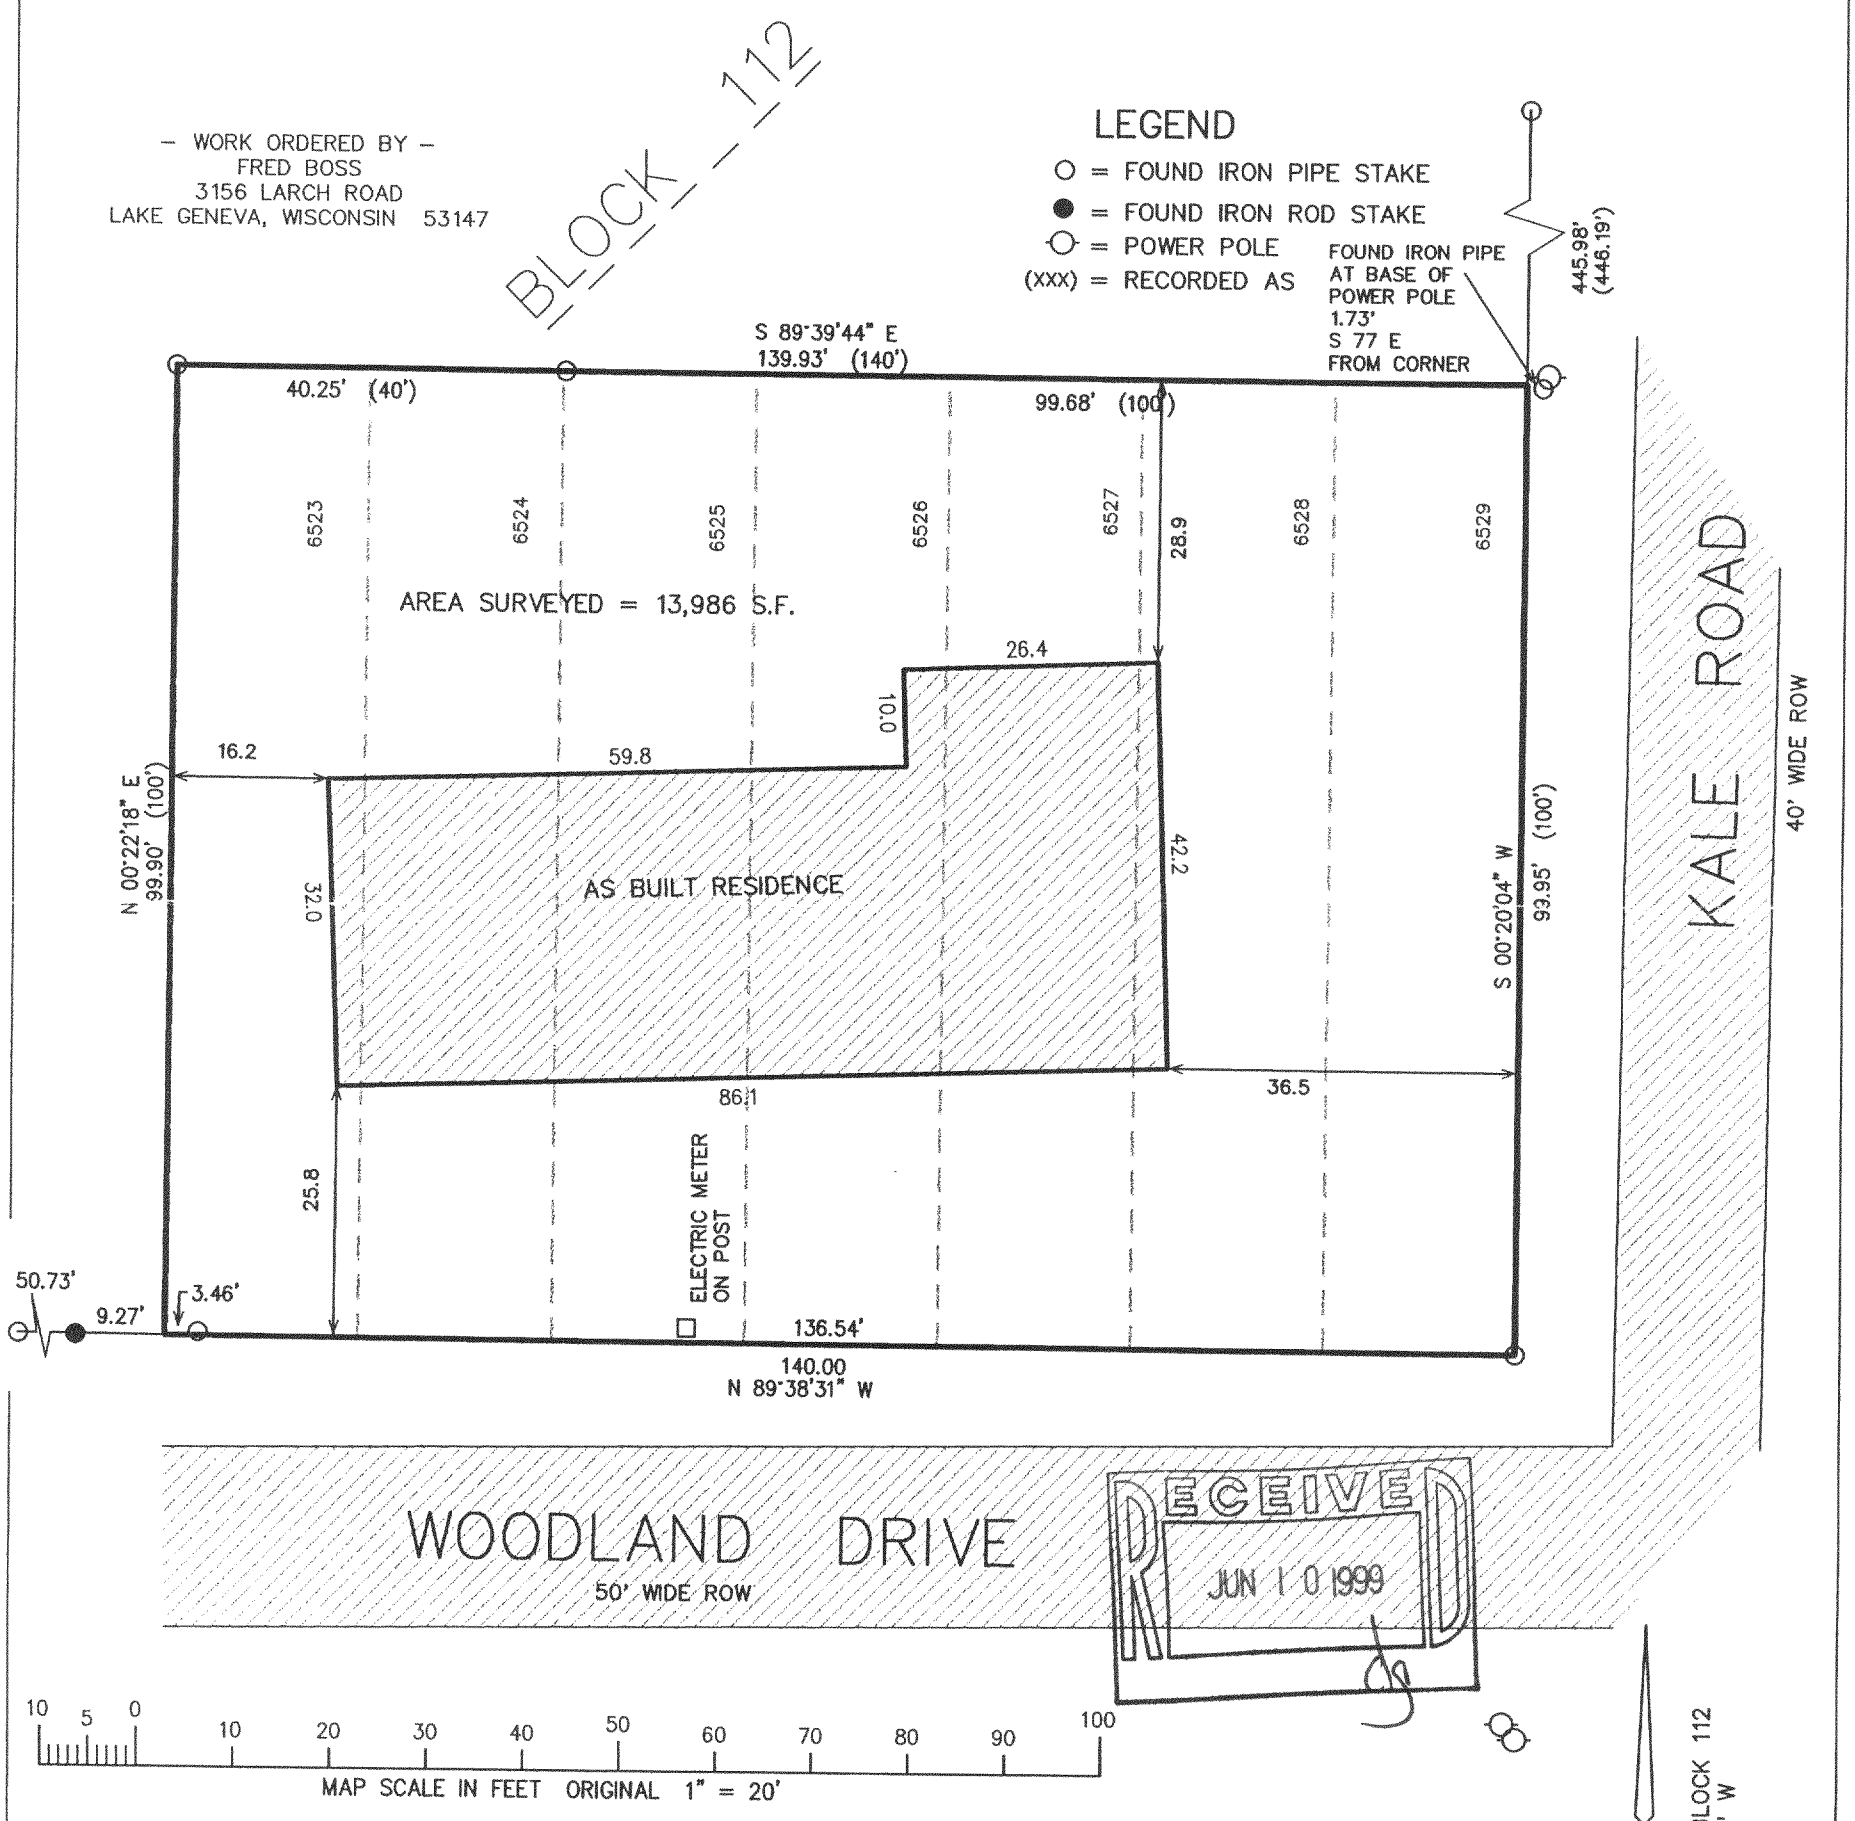

RECEIVED
JUN 10 1999

NOTE: COPIES OF THIS MAP TO WHICH THE FOLLOWING CERTIFICATE WILL APPLY SHOW SURVEYOR'S ORIGINAL SEAL AND SIGNATURE IN RED INK. COPIES BY ANY OTHER MEANS MAY HAVE ALTERATIONS WHICH DO NOT REPRESENT THE SURVEYOR'S WORK PRODUCT.

I HEREBY CERTIFY THAT THE ABOVE DESCRIBED PROPERTY HAS BEEN SURVEYED UNDER MY DIRECTION AND THAT THE ABOVE MAP IS A TRUE REPRESENTATION THEREOF AND SHOWS THE SIZE AND LOCATION OF THE PROPERTY AND ITS EXTERIOR BOUNDARIES. THIS SURVEY IS MADE FOR THE USE OF THE PRESENT OWNERS OF THE PROPERTY, AND ALSO THOSE WHO PURCHASE, MORTGAGE, OR GUARANTEE THE TITLE THERETO WITHIN ONE YEAR FROM THE DATE HEREOF.

REVISED 05–25–99
TO SHOW SIZE & LOCATION
OF RESIDENCE AS BUILT

DATED: 01–29–99

PETER S. GORDON R.L.S. 2101

WISCONSIN PETER S. GORDON S-2101 ELKHORN, WI LAND SURVEYOR

PROJECT 5210
DATE: 01/27/1999
SHEET 1 OF 1

JLCB-1359

MAY 25 [illegible] 217-1737