ABERNATHY and ASSOCIATES
Kenneth B. Abernathy Jr.
Wisconsin Registered Land Surveyor S-1594

Rt. 3, Box 273
Elkhorn, Wisconsin 53121
Phone: (414) 723 4260 (office)
(414) 723 7209 (FAX)


PLAT OF SURVEY

LOTS 3216 THROUGH 3220 OF BLOCK 57 OF LAKE COMO BEACH SUBDIVISION, LOCATED IN TOWN 2 NORTH, RANGE 17 EAST, WALWORTH COUNTY, WISCONSIN.

OWNER: EUGENE VALLANGO
48 RIVERVIEW ST.
FOX LAKE, IL. 60020

NOTE
WOOD STAKES HAVE BEEN PLACED AT BUILDING CORNERS. BUILDER IS TO VERIFY DIMENSIONS WHICH HAVE BEEN ROUNDED TO THE NEAREST TENTH OF A FOOT TO INSURE PROPER PLAN INTERPRETATION AND CONTACT THIS OFFICE IMMEDIATELY IF ANY DISCREPANCY EXISTS. 10 FOOT OFFSETS WERE PROVIDED AT VARIOUS BUILDING CORNERS.

RESIDENCE WAS LOCATED ON 7/28/99 AND THE FOUNDATION WAS COMPLETE AND THIS PLAT IS REVISED TO SHOW FINAL LOCATION.

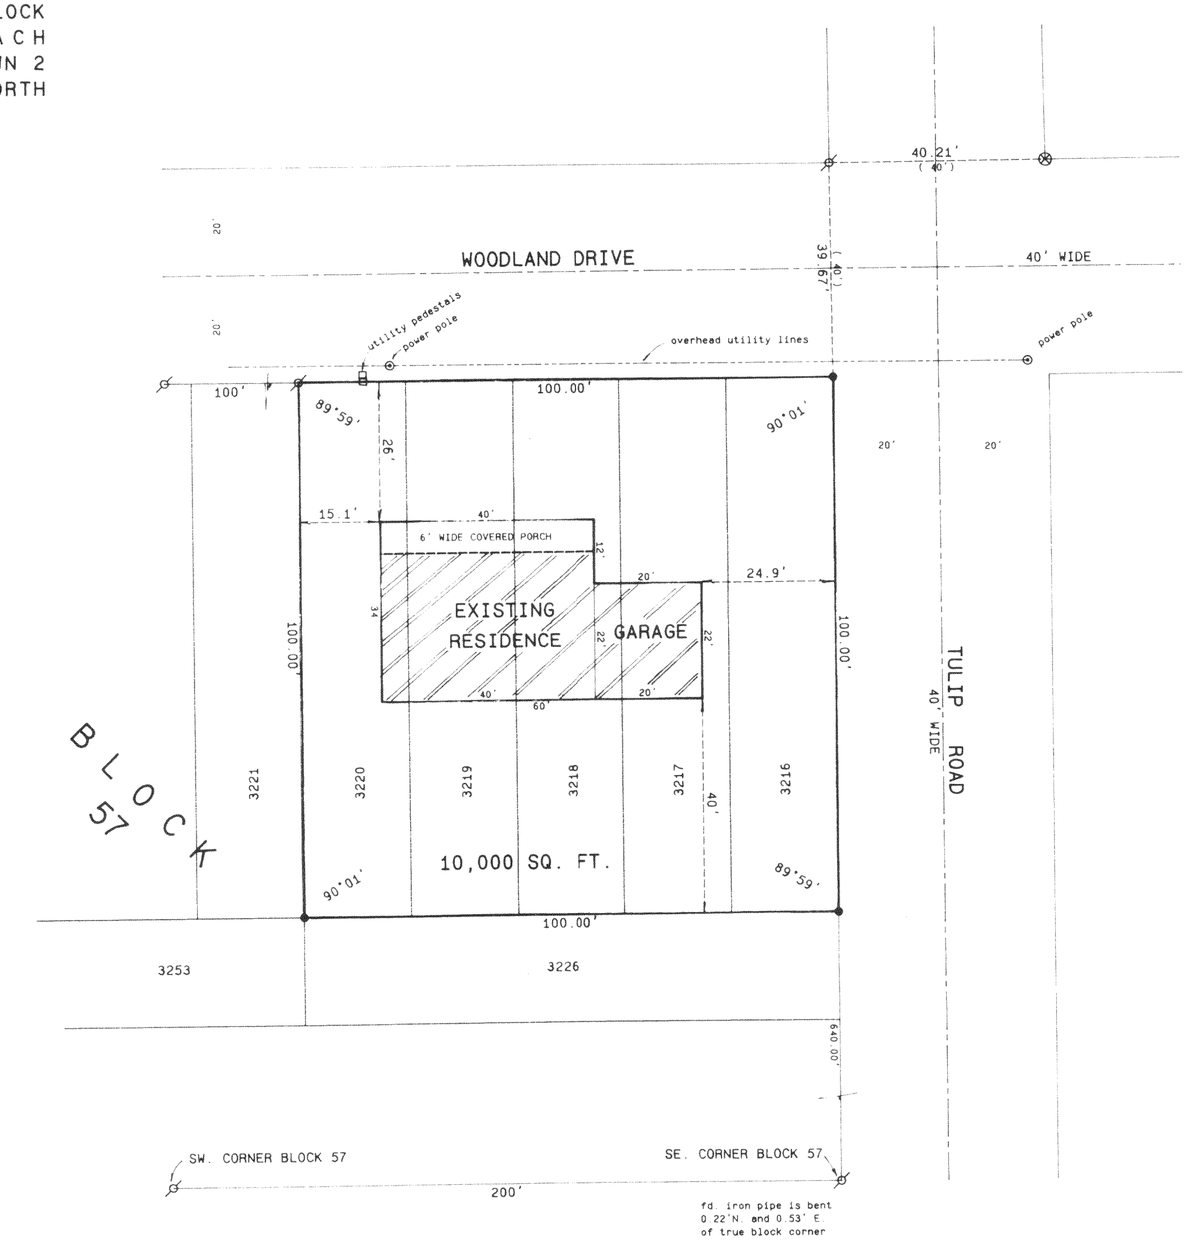



SCALE 1" = 20 FEET

Legend

- FOUND IRON PIPE
- FOUND IRON ROD
- FOUND BRASS CAPPED MONUMENT
- FOUND CONCRETE MONUMENT
- CHISEL CUT IN CONCRETE
- SET IRON ROD 24" LONG, WEIGHING 1.5 LBS/LINEAL FT. 3/4" DIA.
- SET IRON ROD 30" LONG, WEIGHING 4.5 LBS/LINEAL FT. 1 1/4" DIA.
- (xxx) RECORDED AS DIMENSION
- EXISTING FENCE

RECEIVED
AUG 12 1999

SCALE: 1" = 20 FEET

WISCONSIN
KENNETH B. ABERNATHY, JR.
S-1594
ELKHORN
WI
LAND SURVEYOR

I hereby certify that the above described property has been surveyed by me or under my direction and that the above map is a true representation thereof and shows the size and location of the property, its exterior boundaries, the location of all visible structures and dimensions of all principal buildings thereon, boundary fences, apparent easements, roadways, and visible encroachments, if any.

This survey is made for the use of the present owners of the property and also those who purchase, mortgage or guarantee the title thereto within one year from date hereof.

Kenneth B. Abernathy

KENNETH B. ABERNATHY, JR.
WISCONSIN REGISTERED LAND SURVEYOR,
S-1594

REVISED 7/29/99 Date: APRIL 16, 1999 Job No. 99-426

JLCB-586 217-1777

DESIGN PRODUCTS