ABERNATHY and ASSOCIATES
Kenneth B. Abernathy Jr.
Wisconsin Registered Land Surveyor S-1594

Rt. 3, Box 273
Elkhorn, Wisconsin 53121
Phone: (414) 723-4260 (office)
(414) 723-7209 (FAX)


PLAT OF SURVEY

UNIT 23 - 08 OF GENEVA NATIONAL CONDOMINIUM NO. 23, LOCATED IN THE SOUTHWEST 1/4 OF THE SOUTHWEST 1/4 OF SECTION 29, TOWN 2 NORTH, RANGE 17 EAST, WALWORTH COUNTY, WISCONSIN.

OWNERS: STEPHEN AND MARY KAY HAVEY
10222 WEST COLLEGE AVE.
HALES CORNERS, WI. 53130

SUBJECT PROPERTY ADDRESS: 1160 LAKEVIEW COURT

SCALE 1" = 20 FEET

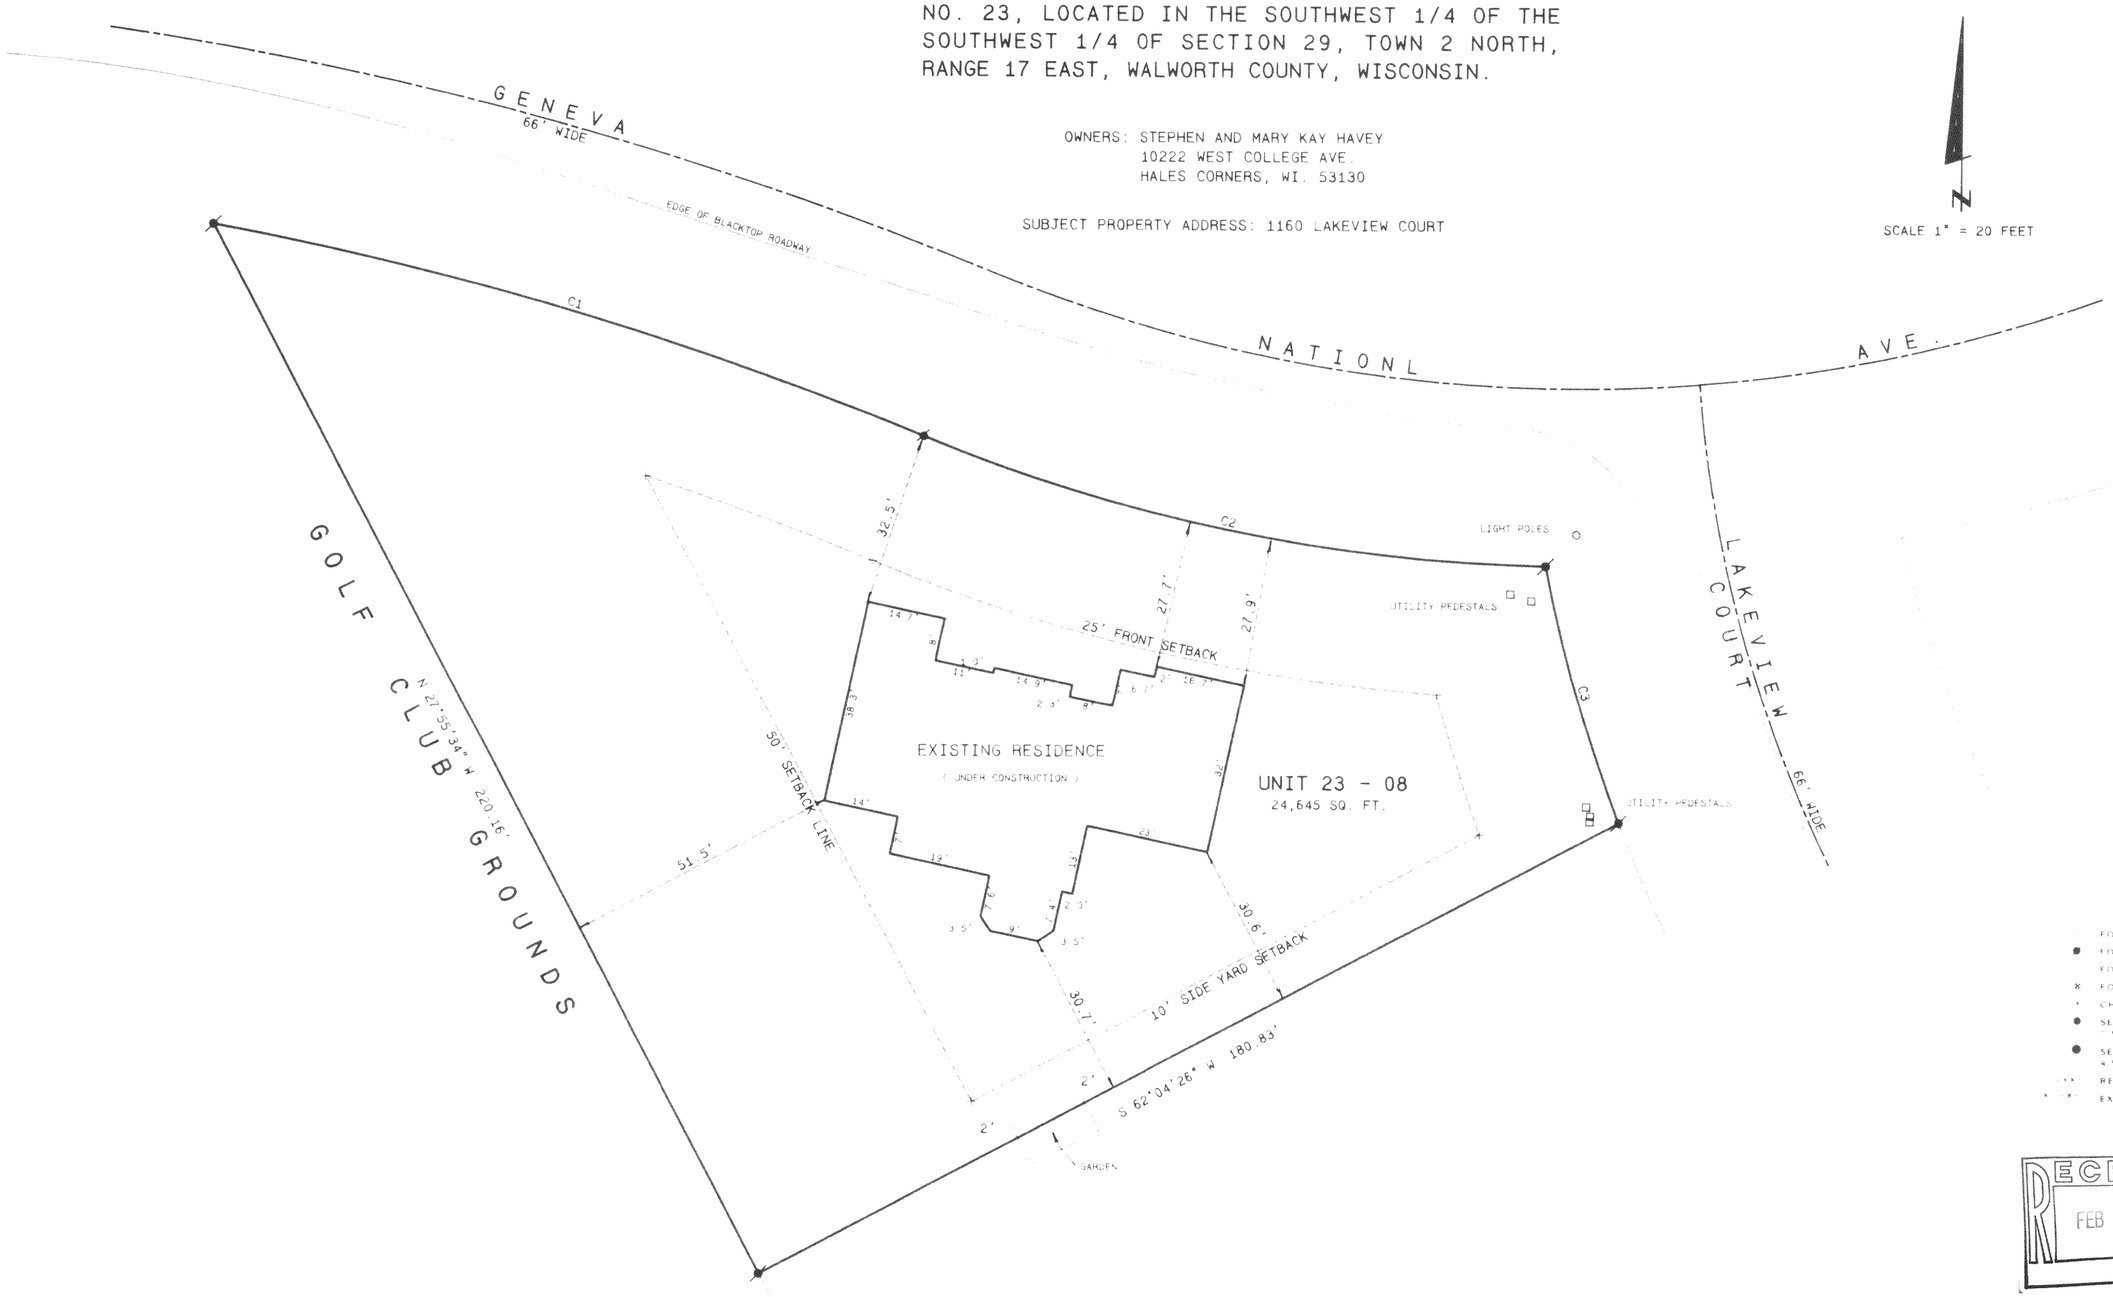

Legend

- FOUND IRON PIPE
- FOUND IRON ROD
- FOUND BRASS CAPPED MONUMENT
- FOUND CONCRETE MONUMENT
- CHISEL CUT IN CONCRETE
- SET IRON ROD 24" LONG, WEIGHING 1.5 LBS/LINEAL FT. 3/4" DIA
- SET IRON ROD 30" LONG, WEIGHING 4.5 LBS/LINEAL FT. 1 1/4" DIA
- (xxx) RECORDED AS DIMENSION
- x - x EXISTING FENCE

RECEIVED
FEB 3 2000

SCALE 1" = 20 FEET

CURVE	ARC	DELTA	RADIUS	CHORD LENGTH	CHORD BEARING
C1	138.46	11°53'38"	667.00	138.21	S 73°54'30" E
C2	119.22	21°08'54"	323.00	118.55	S 78°32'08" E
C3	50.00	10°07'23"	283.00	49.94	S 16°09'51" E

AS BUILT LOCATION REVISED 11/1/99

REVISED 8/10/99
REVISED 8/15/99
REVISED 8/22/99

WISCONSIN
KENNETH B. ABERNATHY, JR.
S-1594
ELKHORN
WI
LAND SURVEYOR

I hereby certify that the above described property has been surveyed under my direction and that the plat hereon is a true representation thereof and shows the size and location of the property, its exterior boundaries, the location of all visible structures and dimensions of visible buildings, the age, boundary fences, apparent encroachments, visible improvements, rights-of-way, easements, party walls and visible use of the property and the location of the property with respect to the nearest intersection of two streets.

Kenneth B. Abernathy

KENNETH B. ABERNATHY, JR.
WISCONSIN REGISTERED LAND SURVEYOR,
S-1594

Date June 28, 1999 Job No. 99-211

JGN-23-8 217-1877