

PLAT OF SURVEY

LAKE COMO BEACH SUBDIVISION
LOTS 9889 THRU 9893 OF BLOCK 181

TOWN 2 NORTH, RANGE 17 EAST,
WALWORTH COUNTY, WISCONSIN

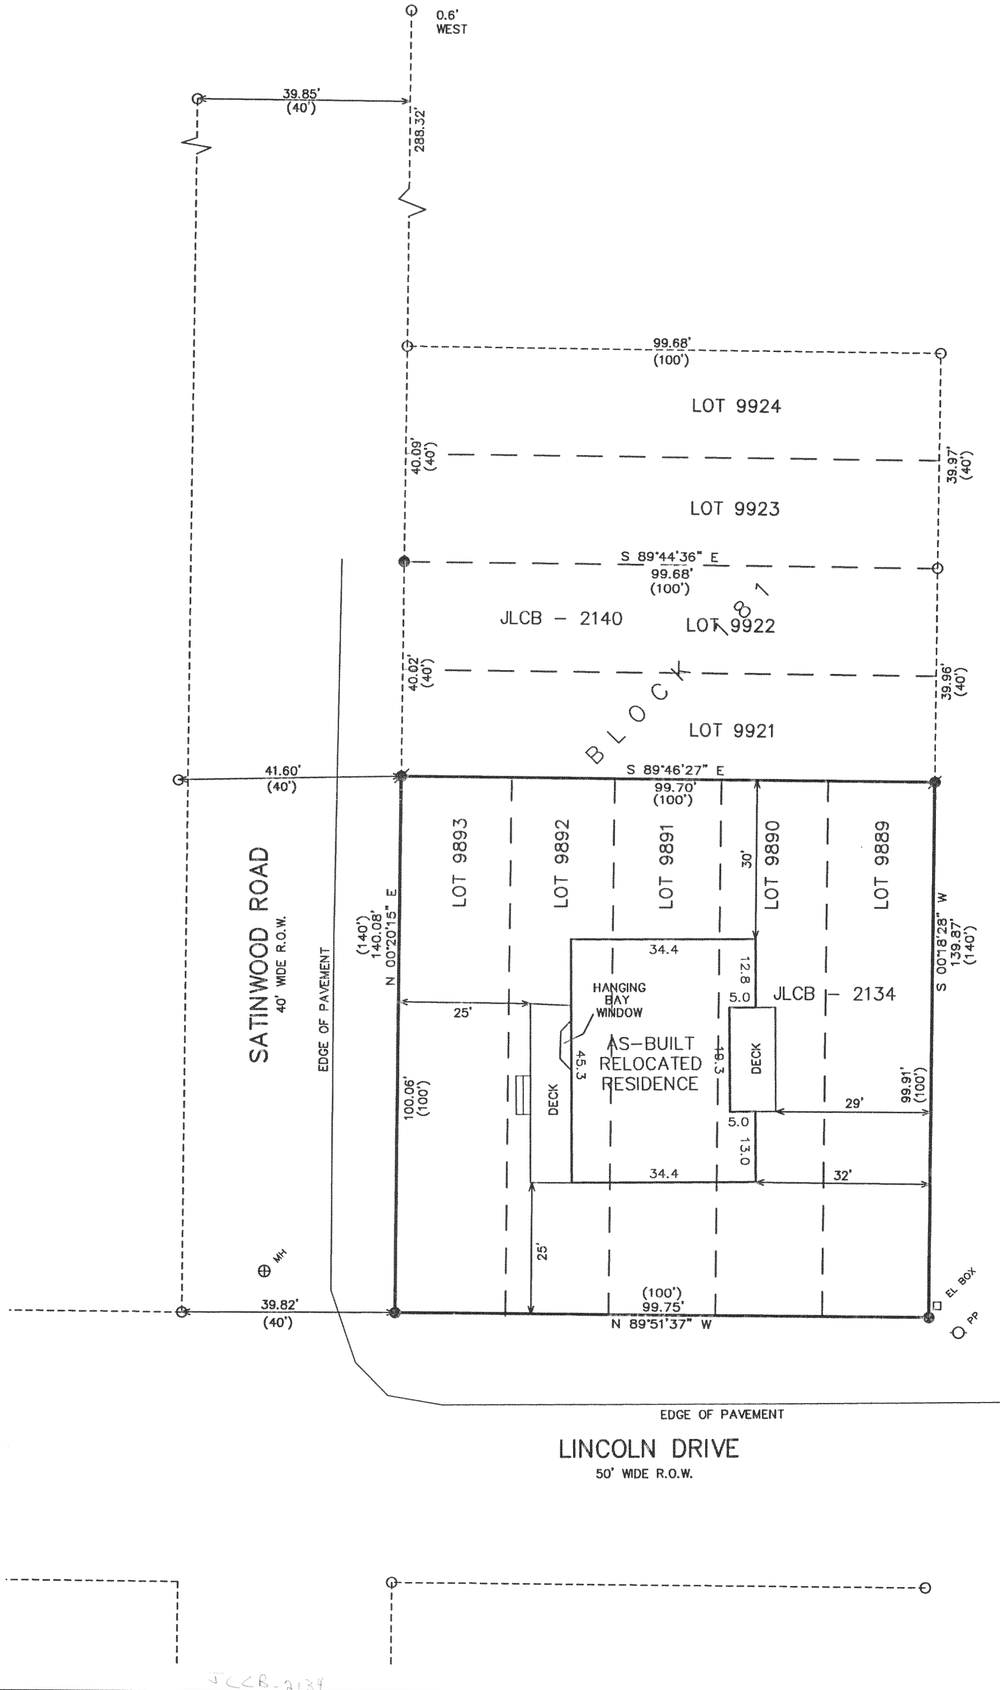

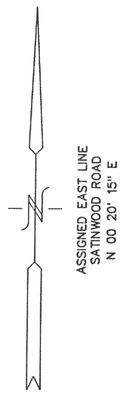

LEGEND

- ○ = FOUND IRON PIPE STAKE
- ● = FOUND IRON REBAR STAKE
- ⊘ = SET IRON REBAR STAKE
- (xxx) = RECORDED AS

10 5 0 10 20 30 40 50 60 70 80 90 100
MAP SCALE IN FEET ORIGINAL 1" = 20'

RECEIVED
JUN 2 7 2002

NOTE: COPIES OF THIS MAP TO WHICH THE FOLLOWING CERTIFICATE WILL APPLY SHOW SURVEYOR'S ORIGINAL SEAL AND SIGNATURE IN RED INK. COPIES BY ANY OTHER MEANS MAY HAVE ALTERATIONS WHICH DO NOT REPRESENT THE SURVEYOR'S WORK PRODUCT.

I HEREBY CERTIFY THAT THE ABOVE DESCRIBED PROPERTY HAS BEEN SURVEYED UNDER MY DIRECTION AND THAT THE ABOVE MAP IS A TRUE REPRESENTATION THEREOF AND SHOWS THE SIZE AND LOCATION OF THE PROPERTY AND ITS EXTERIOR BOUNDARIES. THIS SURVEY IS MADE FOR THE USE OF THE PRESENT OWNERS OF THE PROPERTY, AND ALSO THOSE WHO PURCHASE, MORTGAGE, OR GUARANTEE THE TITLE THERETO WITHIN ONE YEAR FROM THE DATE HEREOF.

DATED: 3-8-02

Revised 6-20-02 To show relocated 1120 Improvements

PETER S. GORDON R.L.S. 2101

WORK ORDERED BY:
DAN BAUMEISTER
250 SHANNON COURT
DES PLAINES, IL 60016

FARRIS, HANSEN & ASSOCIATES, INC.
Engineering, Architecture, Surveying
7 Ridgway Court P.O. Box 437
ELKHORN, WISCONSIN 53121
Office: (262) 723-2098
Fax: (262) 723-5886

REVISIONS
6/21/2002 LK
AS-BUILT

PROJECT NO. 5999
DATE: 03/08/02
SHEET NO. 1 OF 1

JUN 2 0 2002

JLCB-2134

217-2300