
HAROLD H. KOLB

REGISTERED PROFESSIONAL LAND SURVEYOR
LAKE GENEVA, WISCONSIN

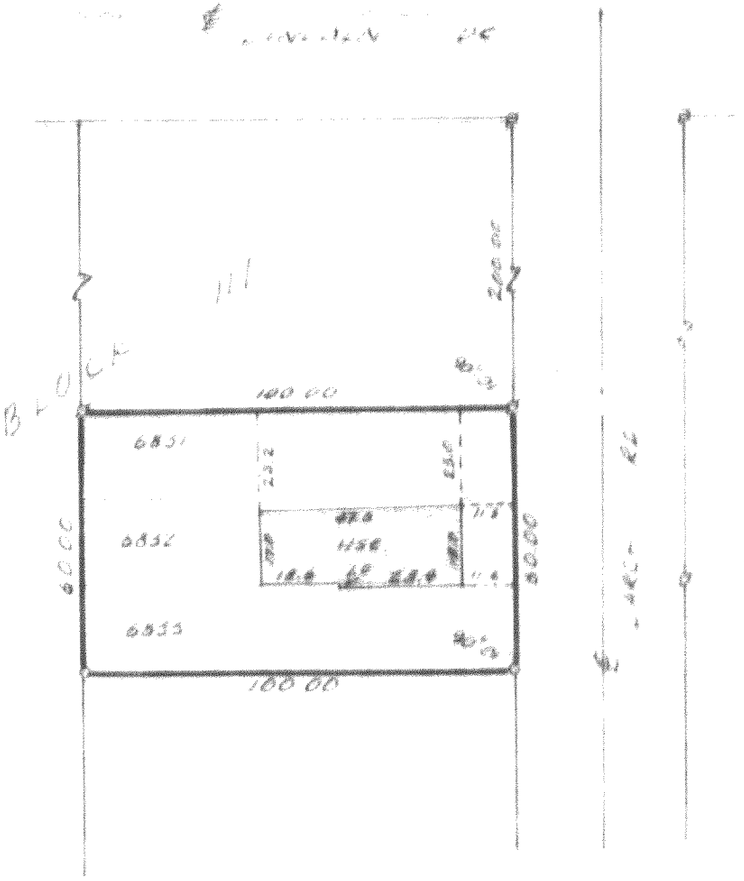

N

Plat of Survey of

Lots 6831-6833, Block 117, Lake Como Beach,
T 2 N, R 17 E, Walworth County, Wisconsin.

LEGEND

- ∅ — IRON PIPE FOUND
- o — IRON PIPE PLACED
- ● — CONCRETE MONUMENT
- x — SPIKE

SCALE 1" = 40'

WISCONSIN
HAROLD H. KOLB
S-187
LAKE GENEVA, WIS.
LAND SURVEYOR

I, HAROLD H. KOLB, DO HEREBY CERTIFY THAT I HAVE SURVEYED THE PROPERTY HEREON DESCRIBED ACCORDING TO THE OFFICIAL RECORDS, AND THAT THE PLAT HEREON IS A CORRECT REPRESENTATION OF THE LOT LINES, and the principle lines of the buildings thereon.

Harold H. Kolb

HAROLD H. KOLB
WISCONSIN REGISTERED LAND SURVEYOR, S-187
DATE August 26, 1969

JLLB-1435

217-234