
HAROLD H. KOLB

REGISTERED PROFESSIONAL LAND SURVEYOR
LAKE GENEVA, WISCONSIN

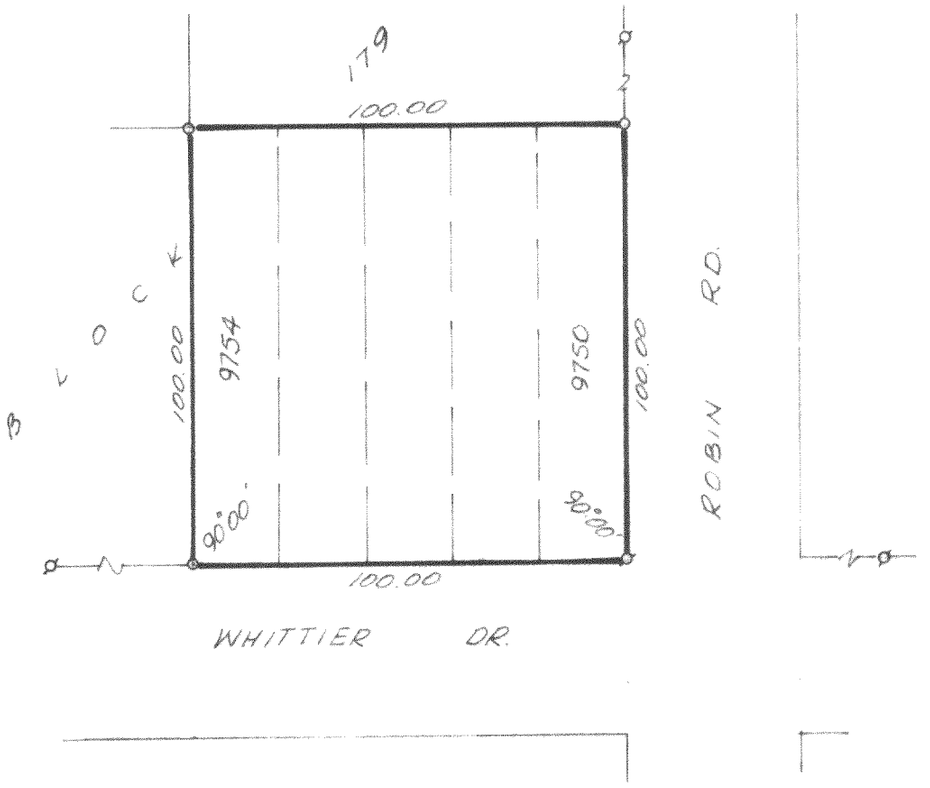

PLAT OF SURVEY OF

Lots 9750 to 9754, Block 179, Lake Como Beach Subd., T 2 N, R 17 E, Walworth County, Wisconsin.

N

LEGEND

- ⌀ — IRON PIPE FOUND
- o — IRON PIPE PLACED
- ● — CONCRETE MONUMENT
- x — SPIKE

SCALE - 1" = 40'

WISCONSIN
HAROLD H. KOLB
S-187
LAKE GENEVA, WIS.
LAND SURVEYOR

I, HAROLD H. KOLB, DO HEREBY CERTIFY THAT I HAVE SURVEYED THE PROPERTY HEREON DESCRIBED ACCORDING TO THE OFFICIAL RECORDS, AND THAT THE PLAT HEREON IS A CORRECT REPRESENTATION OF THE LOT LINES.

Harold H. Kolb

HAROLD H. KOLB
WISCONSIN REGISTERED LAND SURVEYOR, S—187
DATE NOV. 11, 1969

JLL B-2104

217-235