
ABELL
SURVEYING & MAPPING

1140 SEQUOIA STREET · DELAVAN, WISCONSIN 53115
262-728-6737

NOTE 1: 66' WIDE EASEMENT FOR INGRESS AND EGRESS TO LOTS 1 AND 2 OF C.S.M. NO. 2945 AND TO LOTS 1 AND 2 OF C.S.M. NO. 3281.

LOT 1 CERTIFIED SURVEY MAP NO. 2945

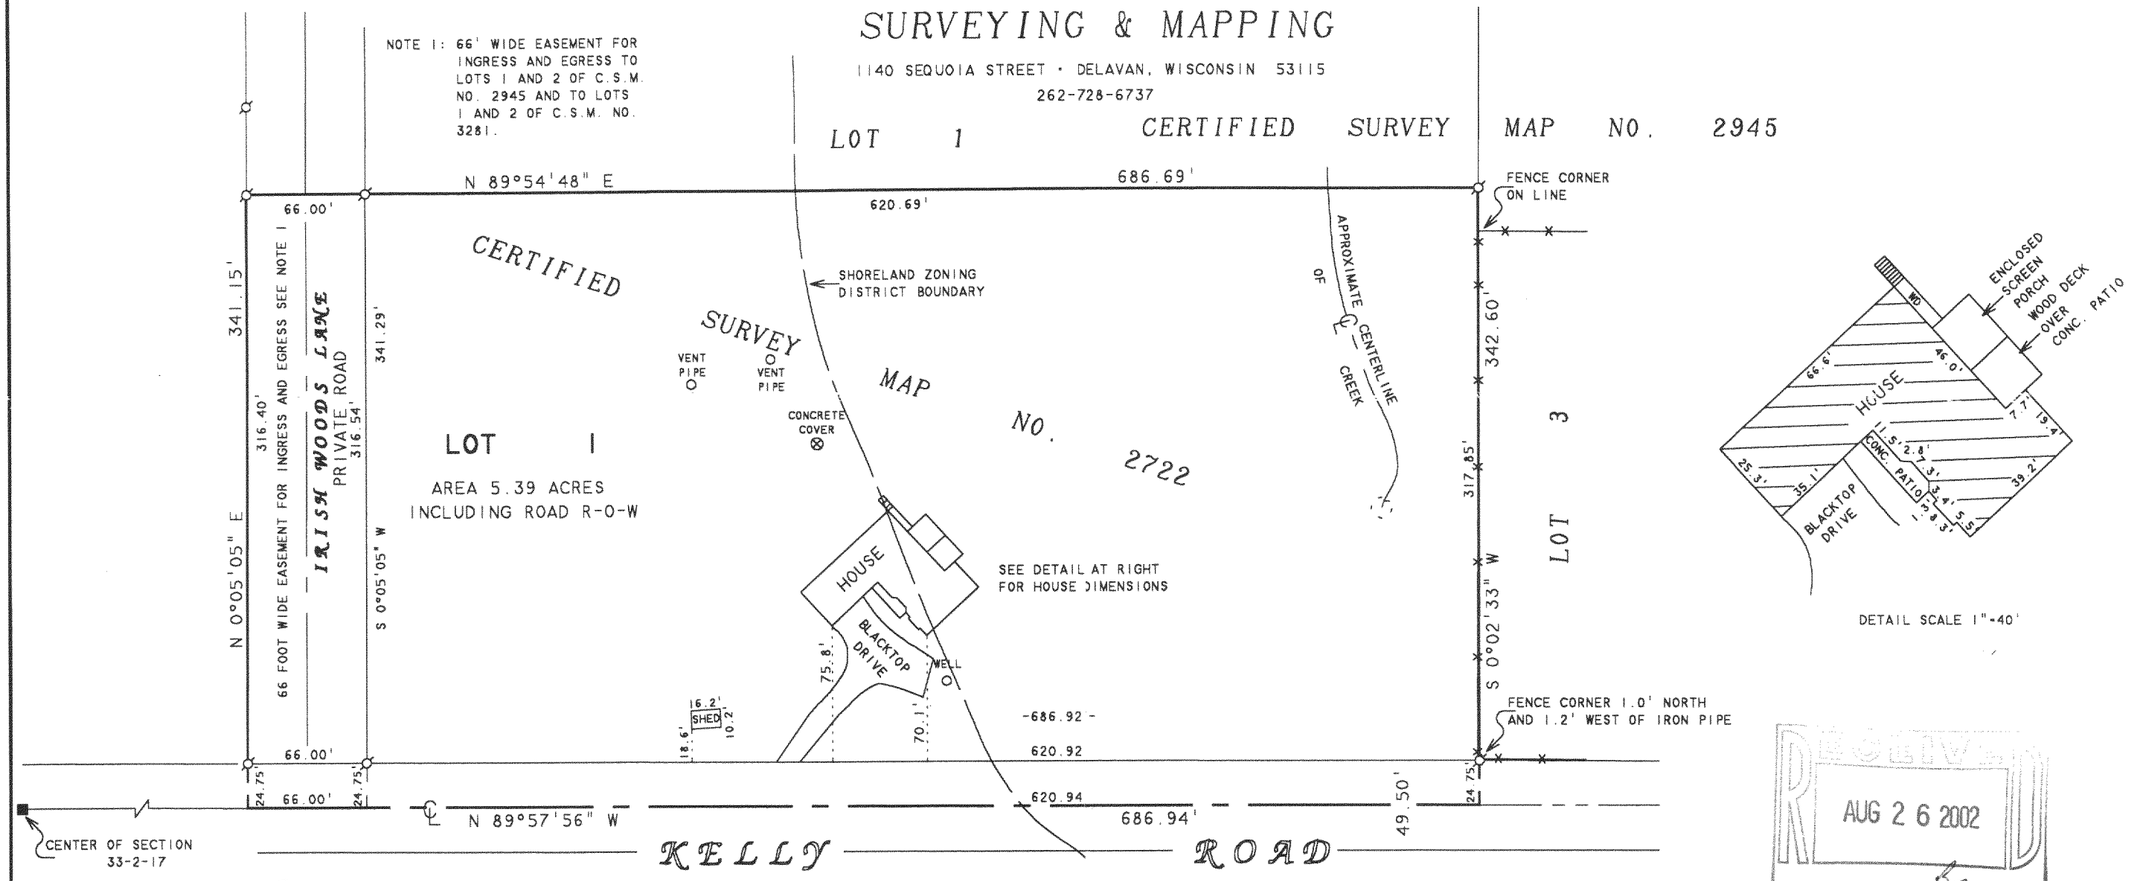

DETAIL SCALE 1"=40'

RECEIVED
AUG 26 2002

N

SCALE 1"=80'

LEGEND

- ■ -CONCRETE MONUMENT FOUND
- Ø -IRON PIPE FOUND
- WD -WOOD DECK
- -x-x-x- -WIRE FENCE

PLAT OF SURVEY OF

LOT 1, CERTIFIED SURVEY MAP NO. 2722, LOCATED IN THE SOUTHEAST 1/4 OF THE NORTHEAST 1/4 OF SECTION 33, T2N, R17E, WALWORTH COUNTY, WISCONSIN.

NOTE 2: BEARINGS ARE REFERENCED TO CERTIFIED SURVEY MAP NO. 2722.

ORDERED BY: SI ALLEN
C/O KEEFE REAL ESTATE
P.O. BOX 460
LAKE GENEVA, WI 53147

I HEREBY CERTIFY THAT I HAVE SURVEYED THE ABOVE DESCRIBED PROPERTY AND THAT THE ABOVE MAP IS A TRUE REPRESENTATION THEREOF AND SHOWS THE SIZE AND LOCATION OF THE PROPERTY, ITS EXTERIOR BOUNDARIES, THE LOCATION OF ALL VISIBLE STRUCTURES AND DIMENSIONS OF ALL PRINCIPAL BUILDINGS THEREON, BOUNDARY FENCES, APPARENT EASEMENTS, ROADWAYS AND VISIBLE ENCROACHMENTS, IF ANY, TO THE BEST OF MY KNOWLEDGE AND BELIEF.

THIS SURVEY IS MADE FOR THE USE OF THE PRESENT OWNERS OF THE PROPERTY, AND ALSO THOSE WHO PURCHASE, MORTGAGE, OR GUARANTEE THE TITLE THERETO WITHIN ONE (1) YEAR FROM DATE HEREON.

David F. Abell

DAVID F. ABELL
WISCONSIN REGISTERED LAND SURVEYOR, S-1596

July 11, 2002

DATE JOB NUMBER - 960560

NOTE: THIS IS NOT A CERTIFIED COPY UNLESS SEALED.

JA-2722-1

217-2373