JCO-5

Plat of Survey

of

Lot 5 of Lost Creek Estates,

a subdivision located in the Northeast 1/4 of Section 12, Town 2 North, Range 17 East, Town of Geneva, Walworth County, Wisconsin.

Surveyed for: **Steve & Kim Prince**
W894 Miramar Road
East Troy, Wisconsin. 53120

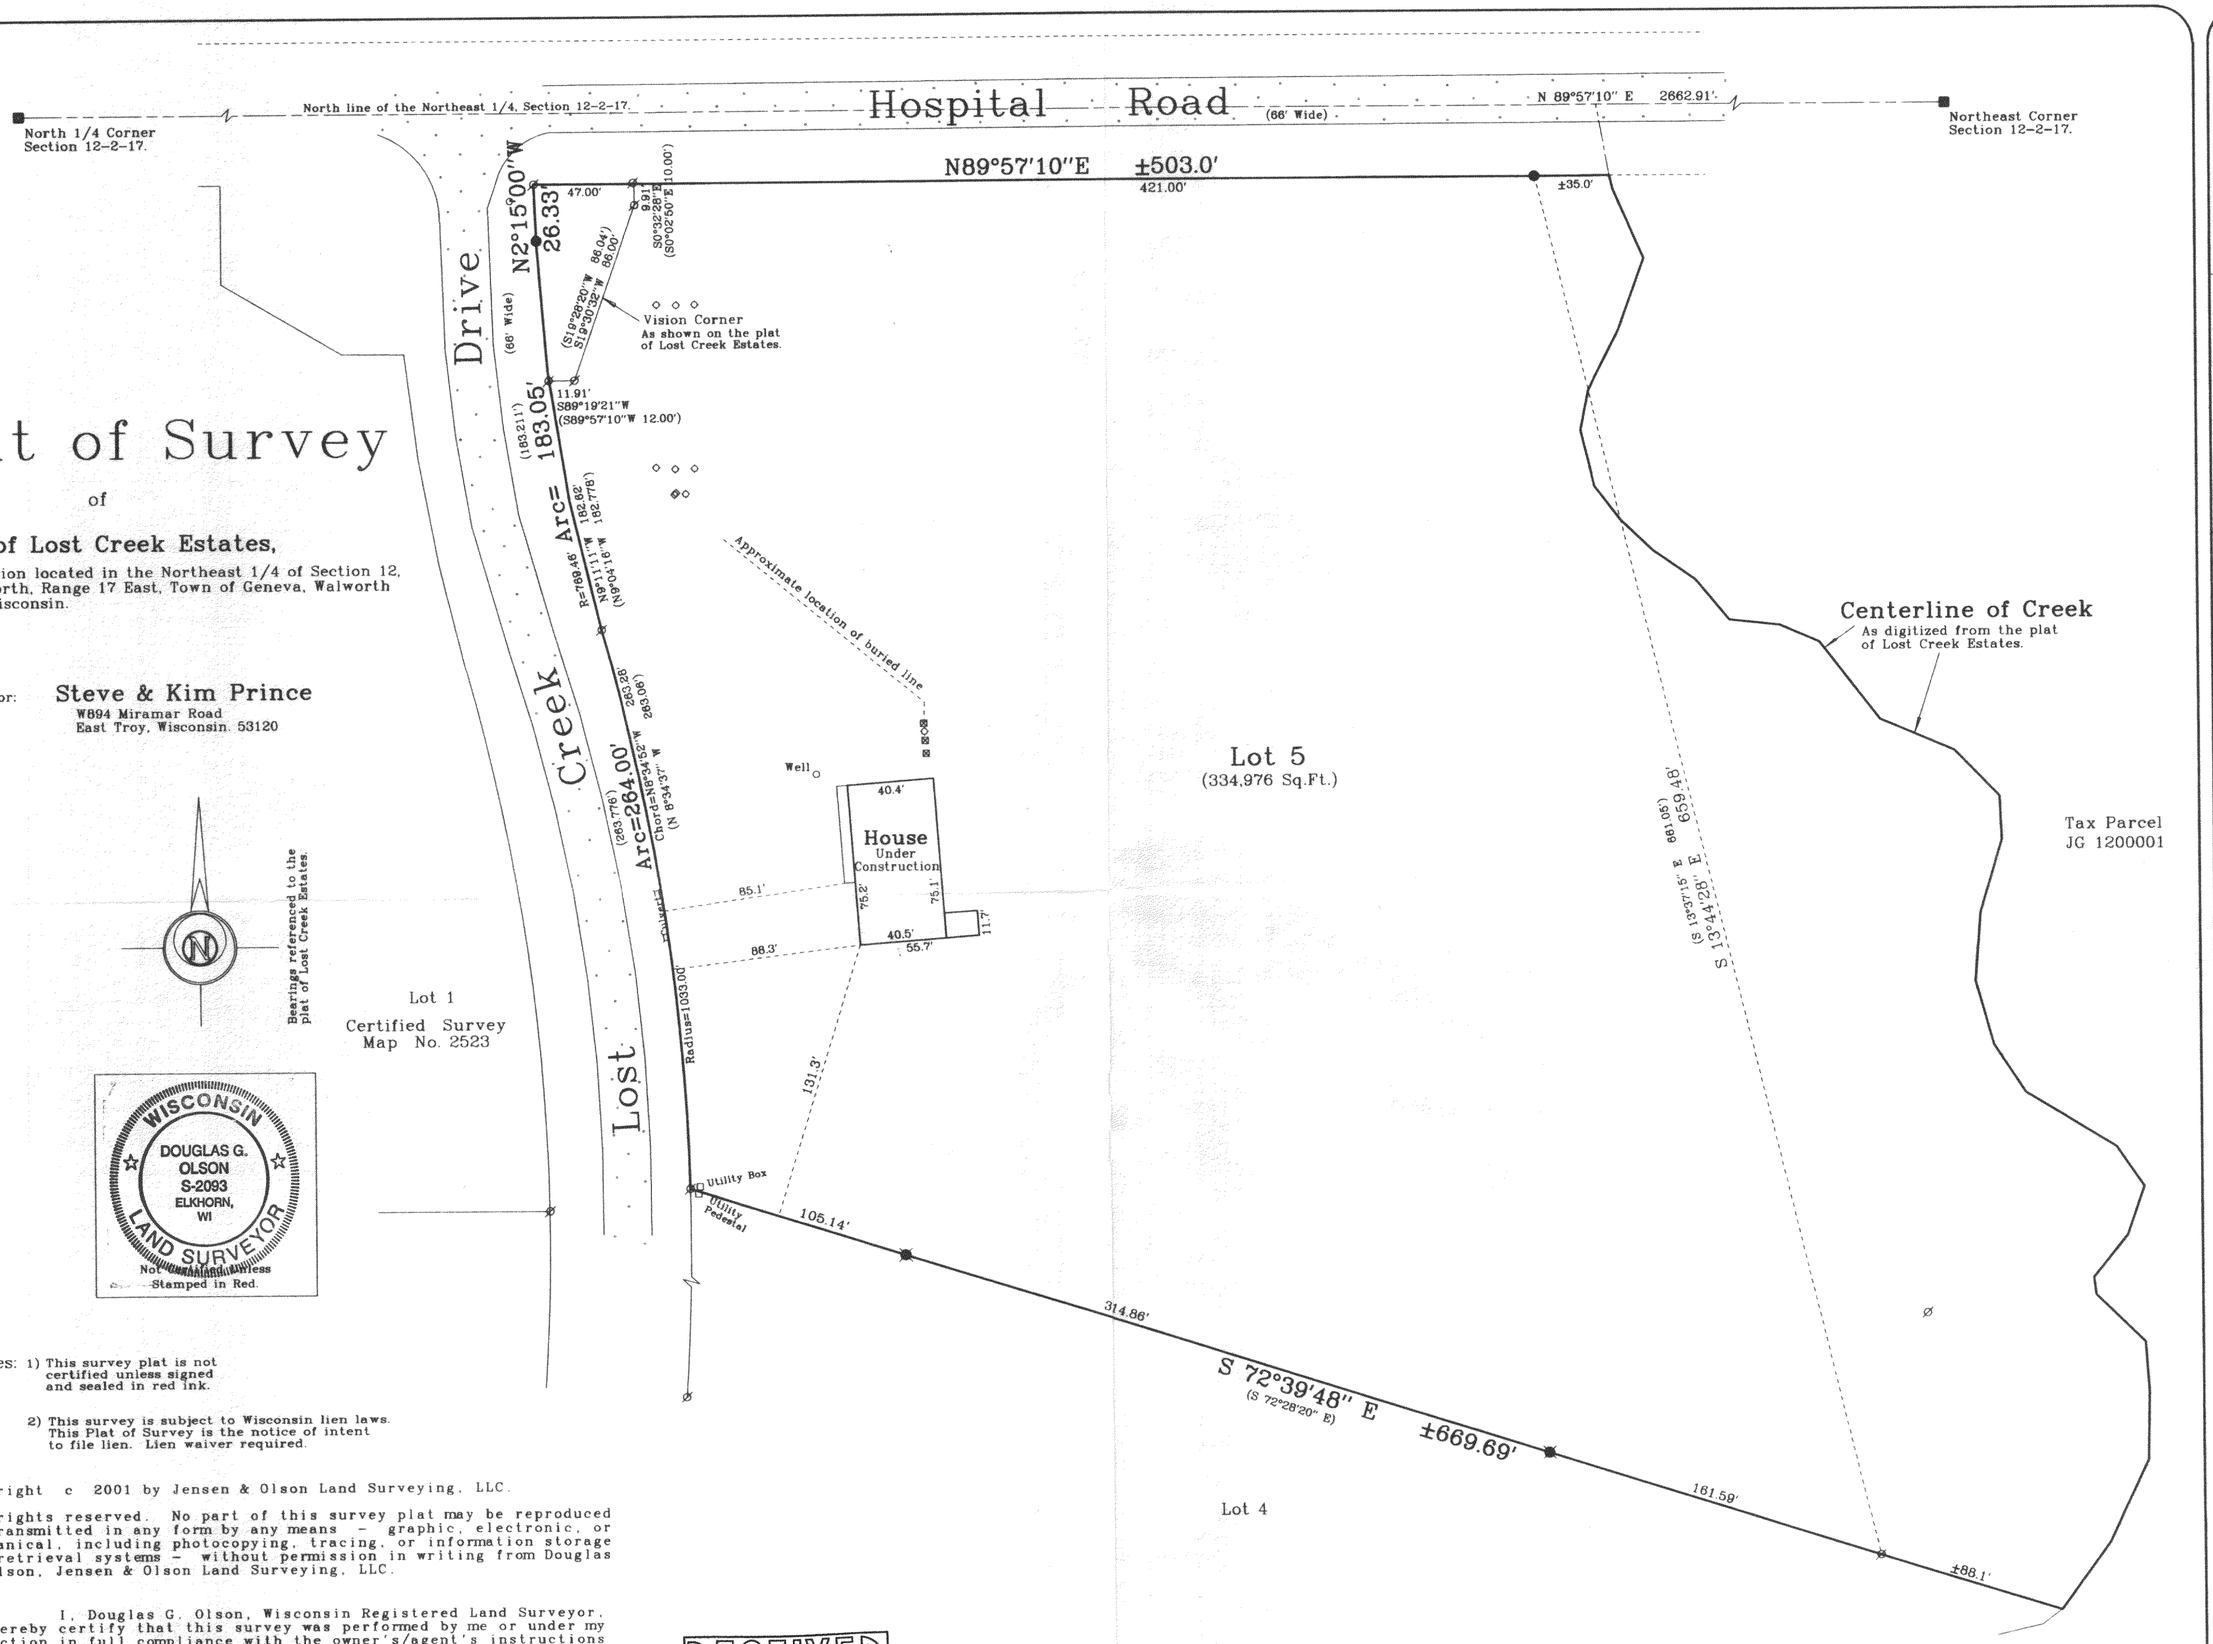

WISCONSIN
DOUGLAS G. OLSON
S-2093
ELKHORN, WI
LAND SURVEYOR
Not Valid Unless Stamped in Red.

Notes: 1) This survey plat is not certified unless signed and sealed in red ink.

2) This survey is subject to Wisconsin lien laws. This Plat of Survey is the notice of intent to file lien. Lien waiver required.

Copyright c 2001 by Jensen & Olson Land Surveying, LLC.

All rights reserved. No part of this survey plat may be reproduced or transmitted in any form by any means - graphic, electronic, or mechanical, including photocopying, tracing, or information storage and retrieval systems - without permission in writing from Douglas G. Olson, Jensen & Olson Land Surveying, LLC.

I, Douglas G. Olson, Wisconsin Registered Land Surveyor, do hereby certify that this survey was performed by me or under my direction in full compliance with the owner's/agent's instructions and Chapter A-E 7 of the Wisconsin Administrative Code "Minimum Standards for Property Surveys"; and that this map is an accurate representation thereof to the best of my knowledge and belief.

Douglas G. Olson
Wisconsin Registered Land Surveyor - 2093

RECEIVED
SEP 19 2002

Survey Date: 10-19-00
Revisions: No. 1 - Proposed House
No. 2 - 1 Contours
No. 3 - House Revisions
No. 4 - House & Drive Staking
No. 5 - Foundation

Scale in Feet
1" = 50'
0' 25' 50' 100'

Jensen & Olson Land Surveying, LLC
45 South Wisconsin Street P.O. Box 322
Elkhorn, Wisconsin. 53121
Telephone (262) 723-3434
Facsimile (262) 723-8044

Legend
- Found County Section Corner
- Found Iron Pipe
- Found Iron Rod
- Recorded Information
- Concrete Cover
- PVC Pipe
- Asphalt Surface

Sheet 1 of 1 Sheets

Job Reference Number
2001.060

2001.060

217-2386