
HAROLD H. KOLB

REGISTERED PROFESSIONAL LAND SURVEYOR
LAKE GENEVA, WISCONSIN

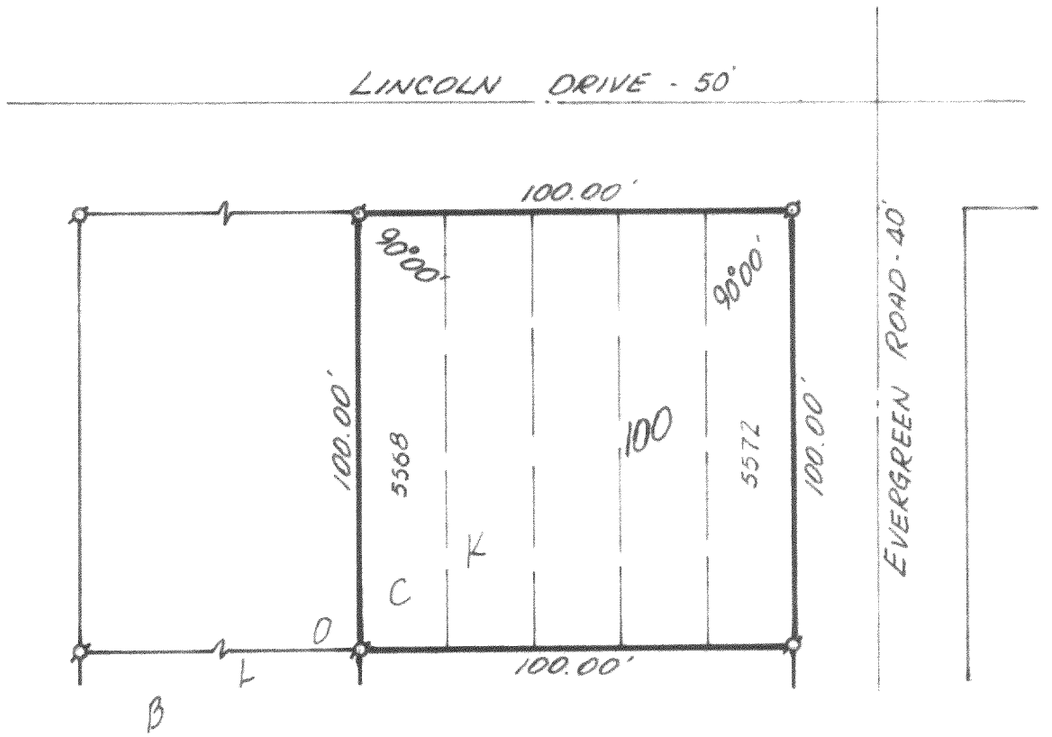

Plat Of Survey Of

Lots 5568 to 5572, Block 100,
Lake Como Beach Subdivision,
T 2 N, R 17 E Walworth County
Wisconsin.

N

LEGEND

- ⌀ — IRON PIPE FOUND
- ○ — IRON PIPE PLACED
- ● — CONCRETE MONUMENT
- x — SPIKE

SCALE - 1" = 40'

WISCONSIN
HAROLD H. KOLB
S-187
LAKE GENEVA, WIS.
LAND SURVEYOR

I, HAROLD H. KOLB, DO HEREBY CERTIFY THAT I HAVE SURVEYED THE PROPERTY HEREON DESCRIBED ACCORDING TO THE OFFICIAL RECORDS, AND THAT THE PLAT HEREON IS A CORRECT REPRESENTATION OF THE LOT LINES.


Harold H. Kolb
HAROLD H. KOLB
WISCONSIN REGISTERED LAND SURVEYOR, S-187
DATE APR. 13, 1970

JLCB-1132

239
217-~~239~~
~~2176~~

HAROLD H. KOLB

REGISTERED PROFESSIONAL LAND SURVEYOR
LAKE GENEVA, WISCONSIN

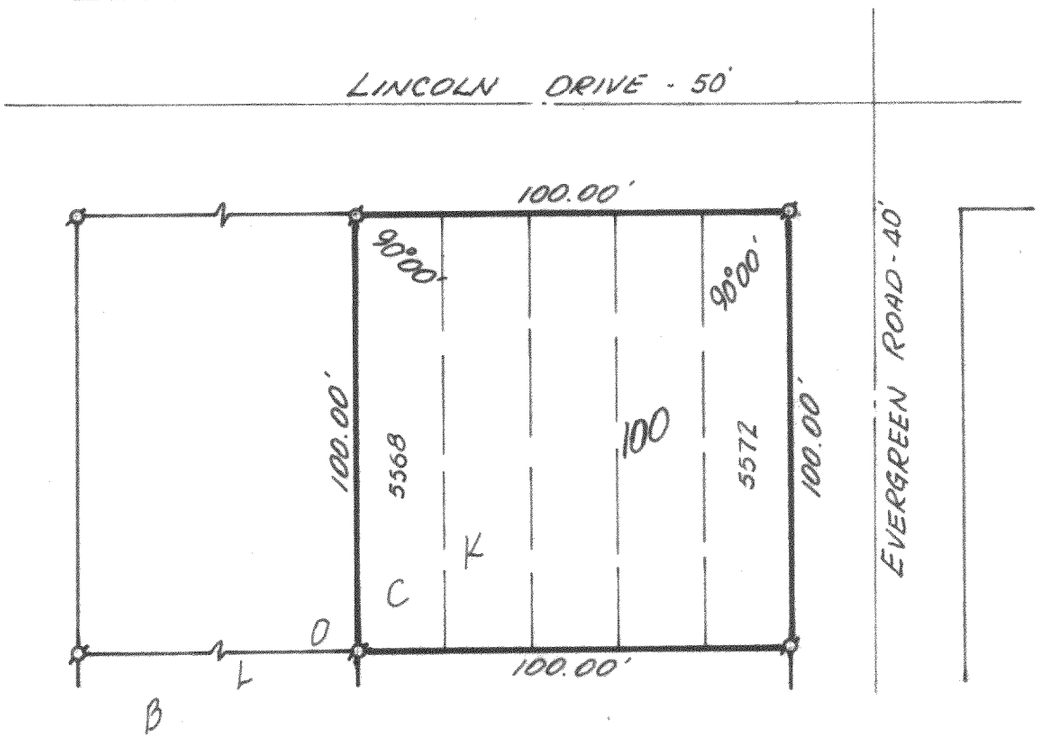

Plat Of Survey Of

Lots 5568 to 5572, Block 100,
Lake Como Beach Subdivision,
T 2 N, R 17 E Walworth County
Wisconsin.

N

LEGEND

- ⌀ — IRON PIPE FOUND
- ○ — IRON PIPE PLACED
- ● — CONCRETE MONUMENT
- x — SPIKE

SCALE - 1" = 40'

WISCONSIN
HAROLD H. KOLB
S-187
LAKE GENEVA, WIS.
LAND SURVEYOR

I, HAROLD H. KOLB, DO HEREBY CERTIFY THAT I HAVE SURVEYED THE PROPERTY HEREON DESCRIBED ACCORDING TO THE OFFICIAL RECORDS, AND THAT THE PLAT HEREON IS A CORRECT REPRESENTATION OF THE LOT LINES.

Harold H. Kolb
HAROLD H. KOLB
WISCONSIN REGISTERED LAND SURVEYOR, S—187
DATE Apr. 13, 1970

217-73