PREPARED FOR:


AJAMIAN CONSTRUCTION
P.O. BOX 1221
LAKE GENEVA, WI
53147

PLAT OF SURVEY

- OF -

LOT 37 OF WILDWOOD SUBDIVISION, LOCATED IN SECTION 34, T.2.N., R.17.E., WALWORTH COUNTY, WISCONSIN.

J.K. SURVEYING INC.
N3705 WILLOWBEND LANE
LAKE GENEVA, WI, 53147
262-248-3697

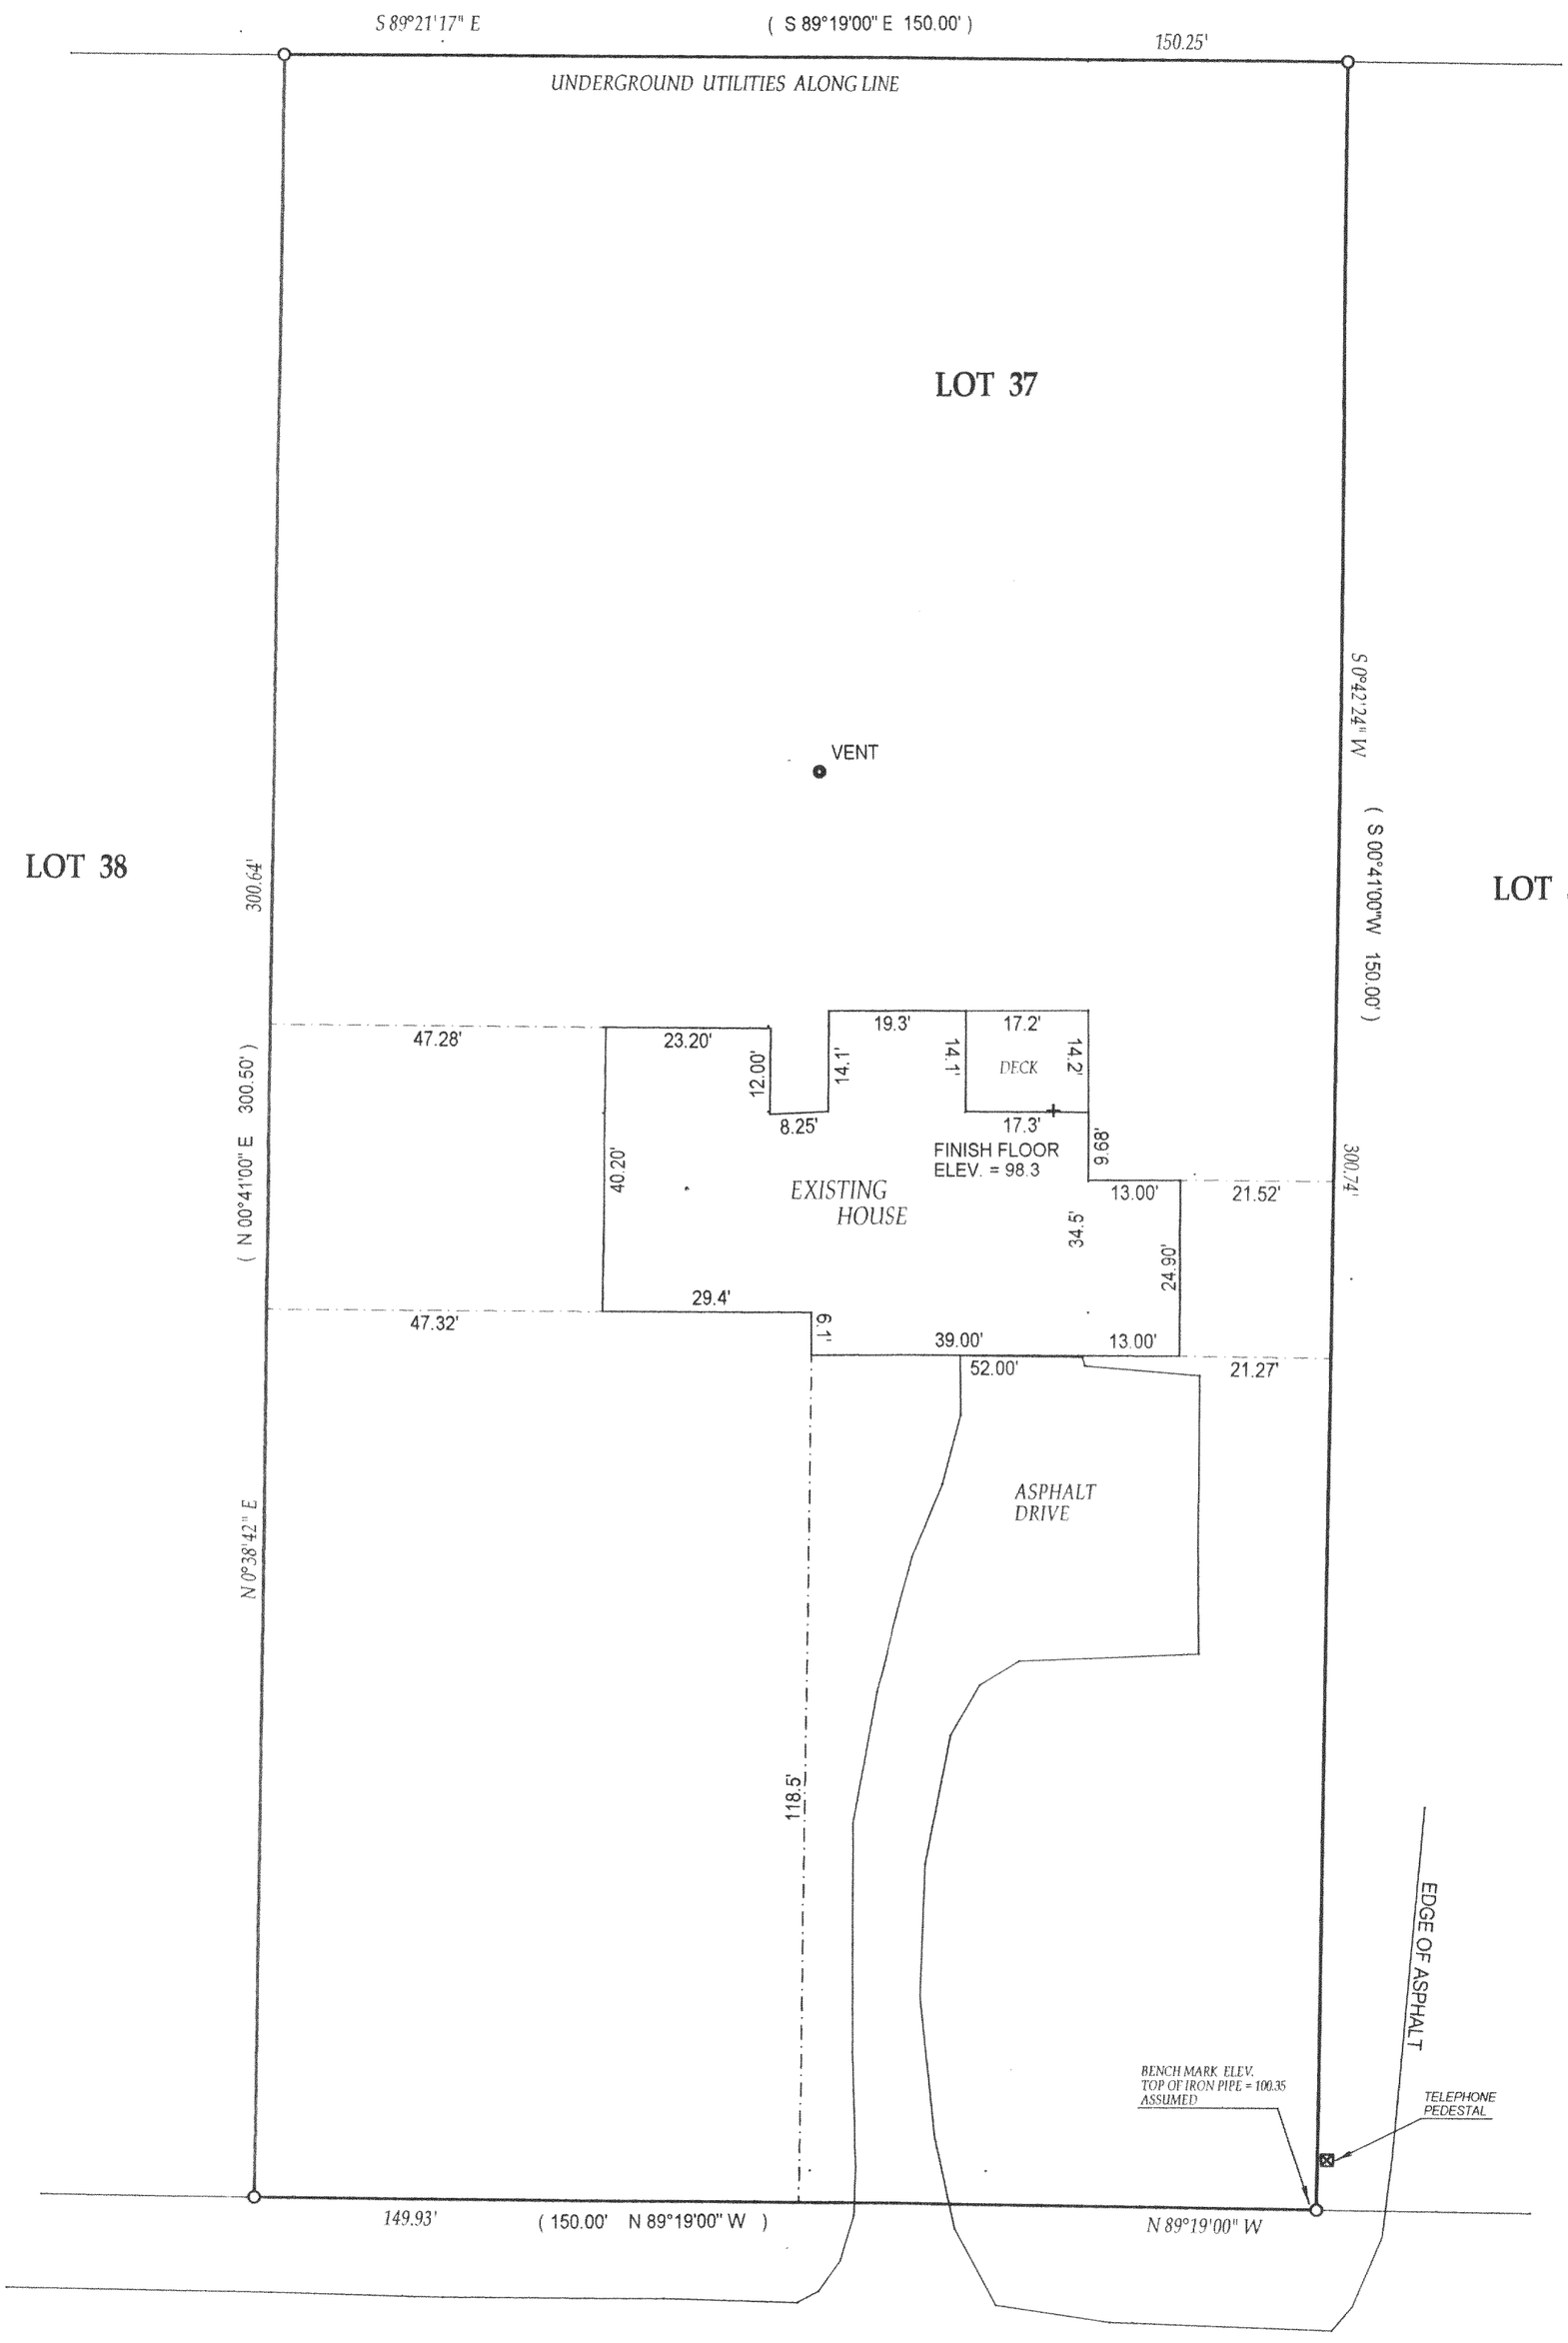

( )= recorded as

○ = iron pipe found

● = iron pipe set

SCALE 1" = 20'

JOB # 02-477

TAX ID # JWS 00035

COMPARE LEGAL DESCRIPTION ABOVE AND DRAWING WITH DEED. FOR BUILDING RESTRICTIONS AND EASEMENTS NOT SHOWN, REFER TO DEED, ABSTRACT SOURCES AND LOCAL MUNICIPAL CODES. NOTIFY THE SURVEYOR IMMEDIATELY OF ANY DISCREPANCY.

"I hereby certify that I have surveyed the above described property and that the above map is a true representation thereof and shows the size and location of all visible structures, apparent easements and encroachments if any."
This survey is made for the present owners of the property, and those who purchase, mortgage, or guarentee the title thereto, within one year from the date hereof.

DATED THIS 24 TH, DAY OF SEPTEMBER 20 02 .

RECEIVED
DEC 26 2002
KW

WISCONSIN
JOHN P. KROTT
S-2258
MUKWONAGO, WIS.
LAND SURVEYOR

JOHN KROTT S - 2258
Wisconsin Registered Land Surveyor
(original if signed in red)

DATE OF LAST REVISION 12 - 05 - 02

JWS-35

217-2471